

Survey for  
 JAMES E. SMITH

January 17, 1973

LEGEND

Scale: 1" = 200'

( ) Data of Record.

o Found Monuments as indicated.

• Set 5/8" x 30" steel rods.

▽ Rock Jacks


— Road center lines.

■ Drove Steel Fence Post.

REGISTERED  
 PROFESSIONAL  
 LAND SURVEYOR

*James E. Voelz*

OREGON  
 JAMES E. VOELZ  
 385

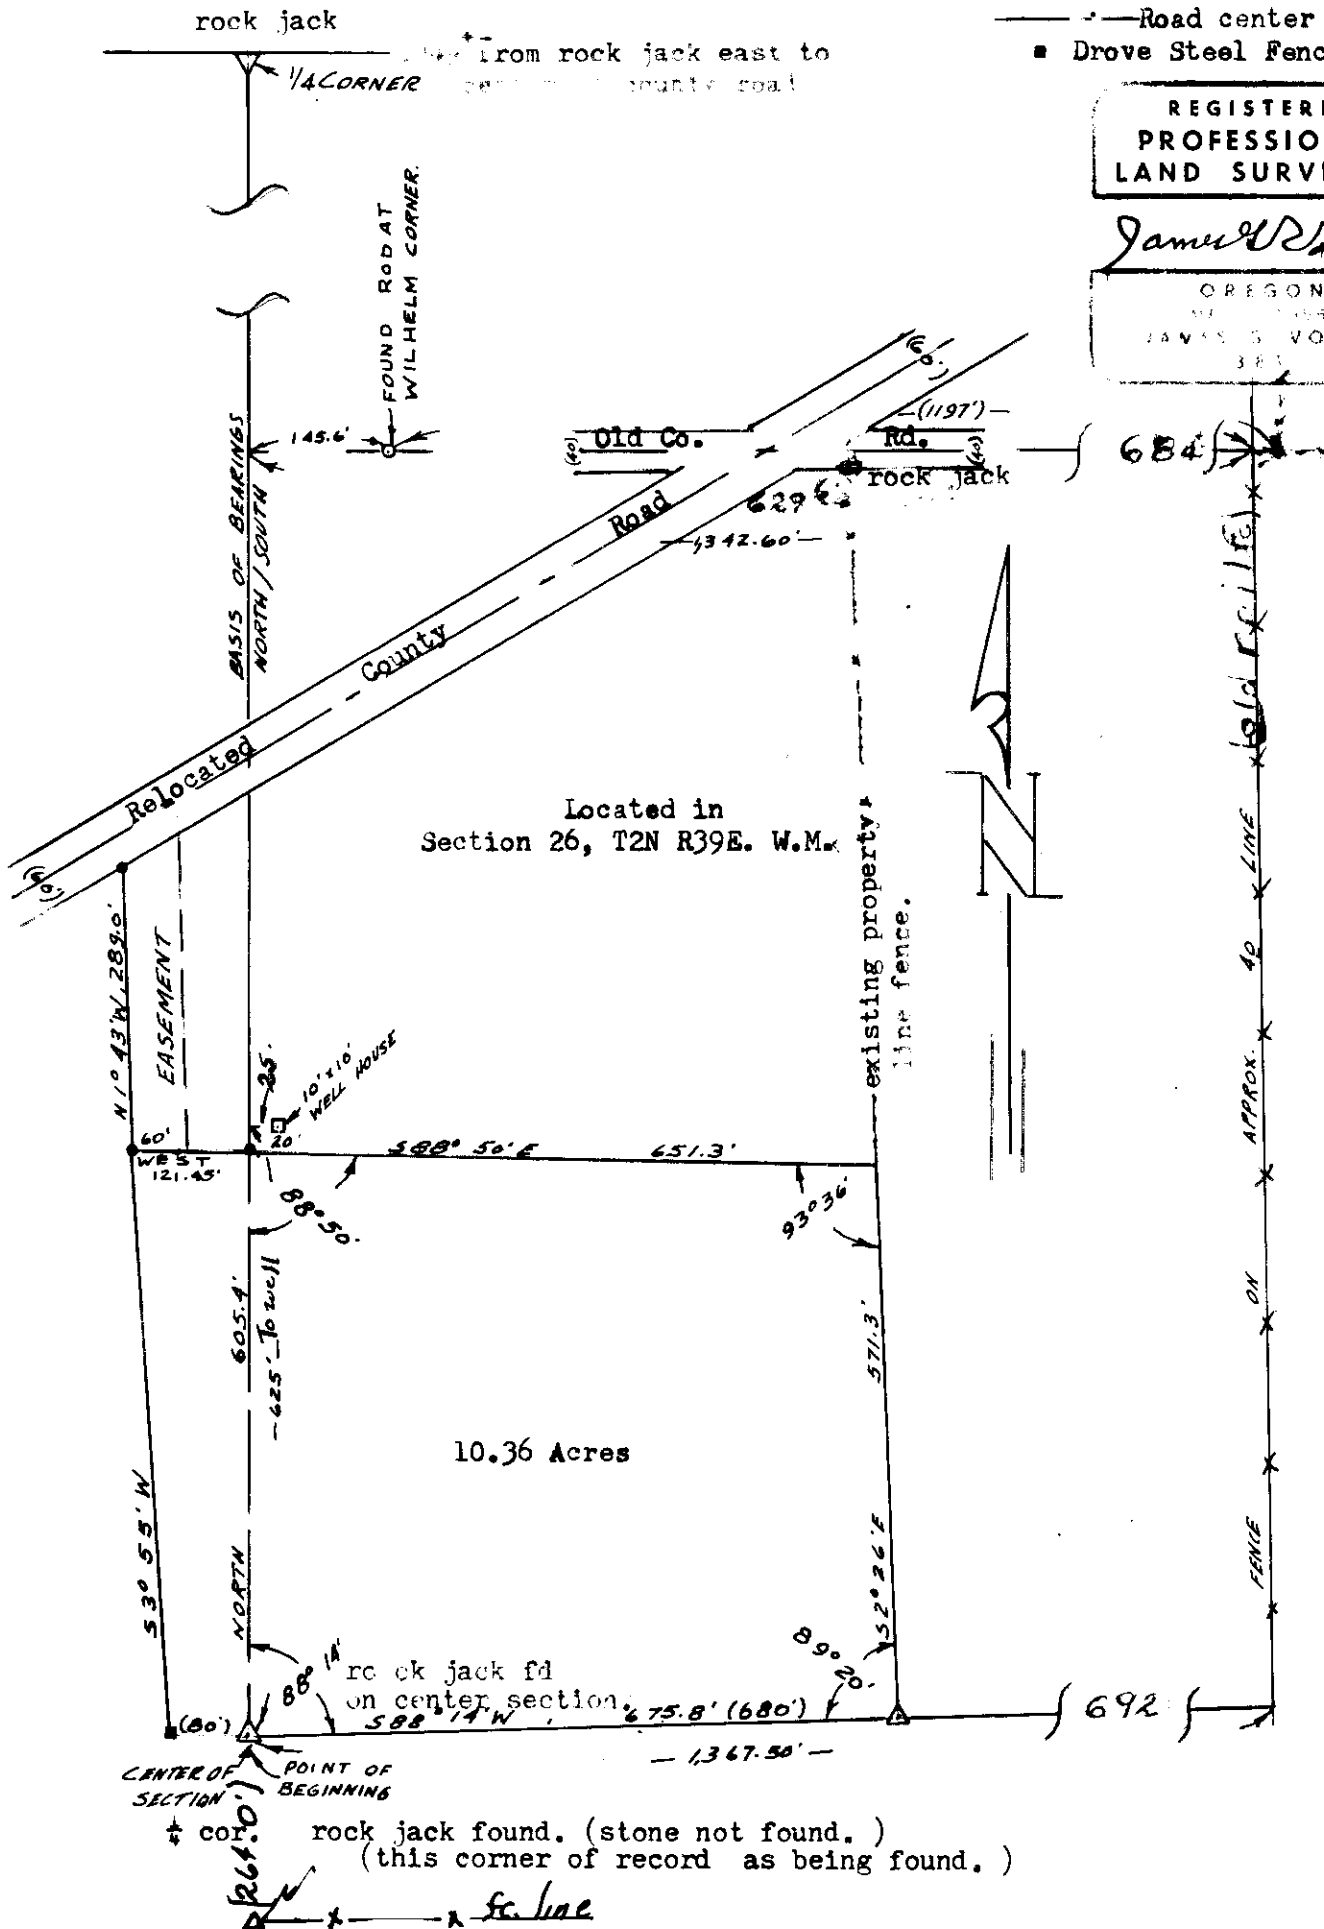

36-73