PLAT
of Survey of

JOHN CASE LAND

Alicel, Oregon.

APRIL 19, 1973

Located in Sections 16 & 17 T2S R39 E. W.M.

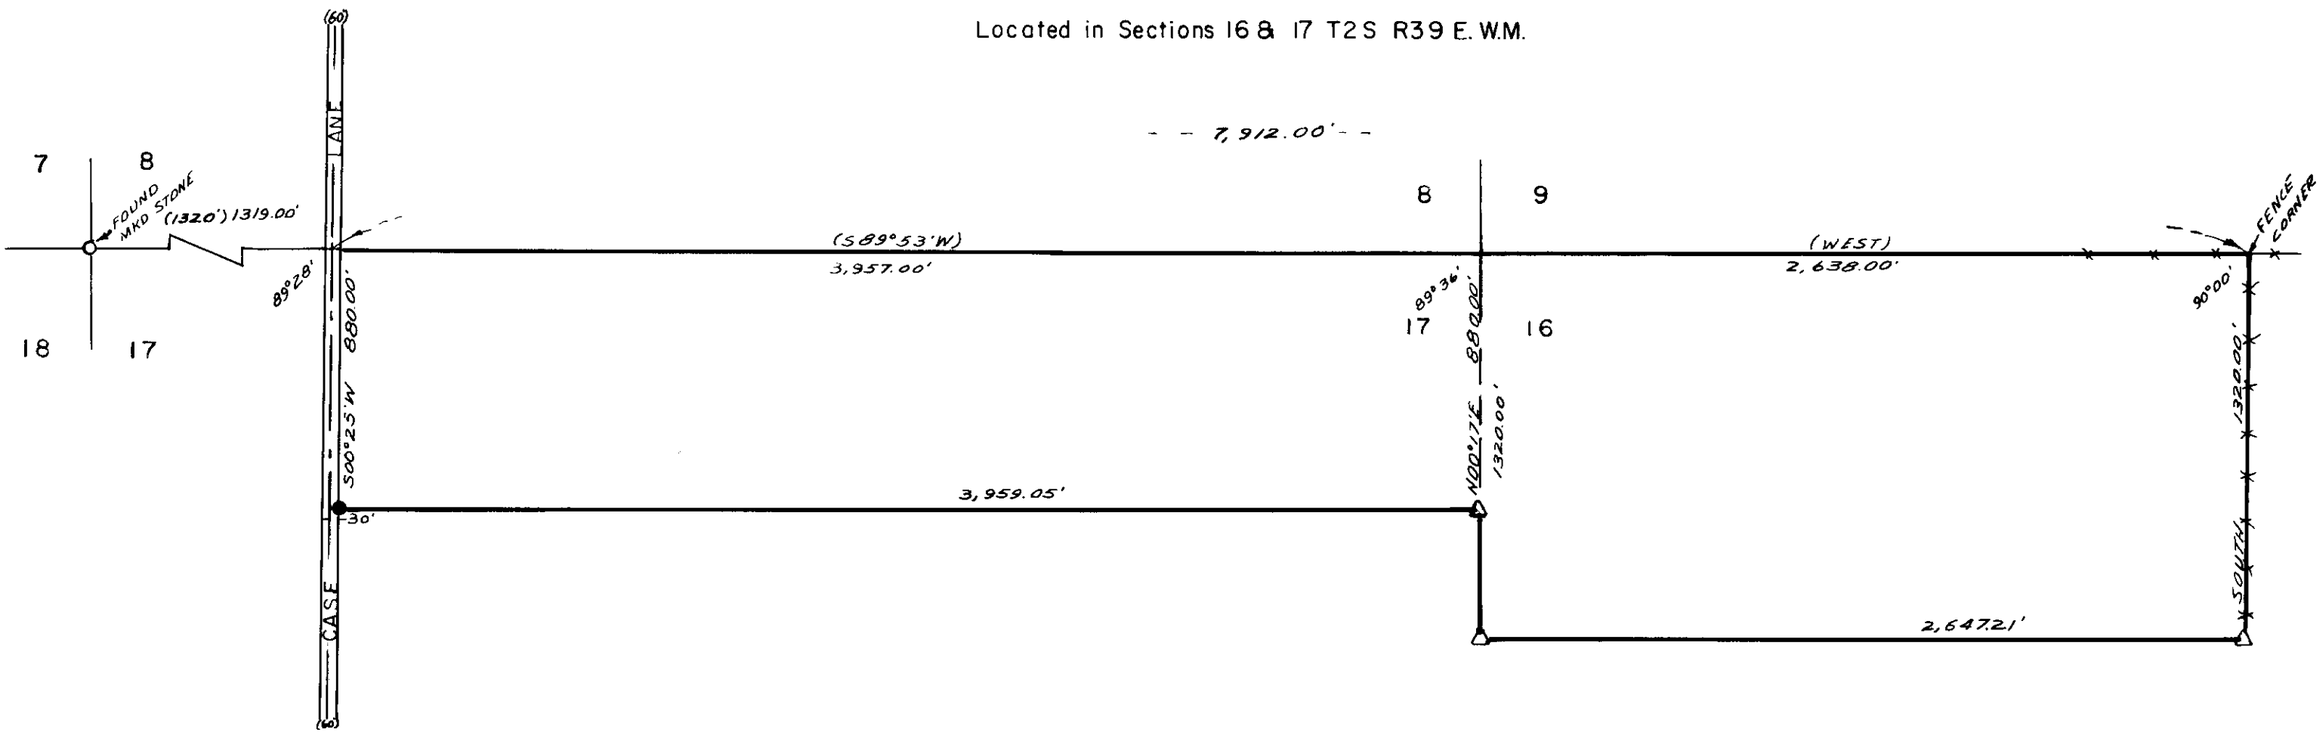

LEGEND

Scale: 1" = 600'.
( ) Data of record.
● Set 5/8" X 30" steel rod.
○ Found monuments as indicated.
△ Set steel fence posts (deep).
——— Road center line.
—x—x—x— Existing fences.

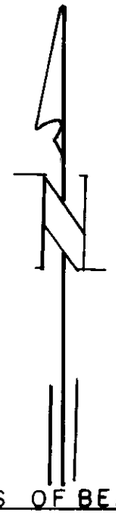

BASIS OF BEARINGS
Based on N. Line.
Sec. 17 being S 89° 53' W.