

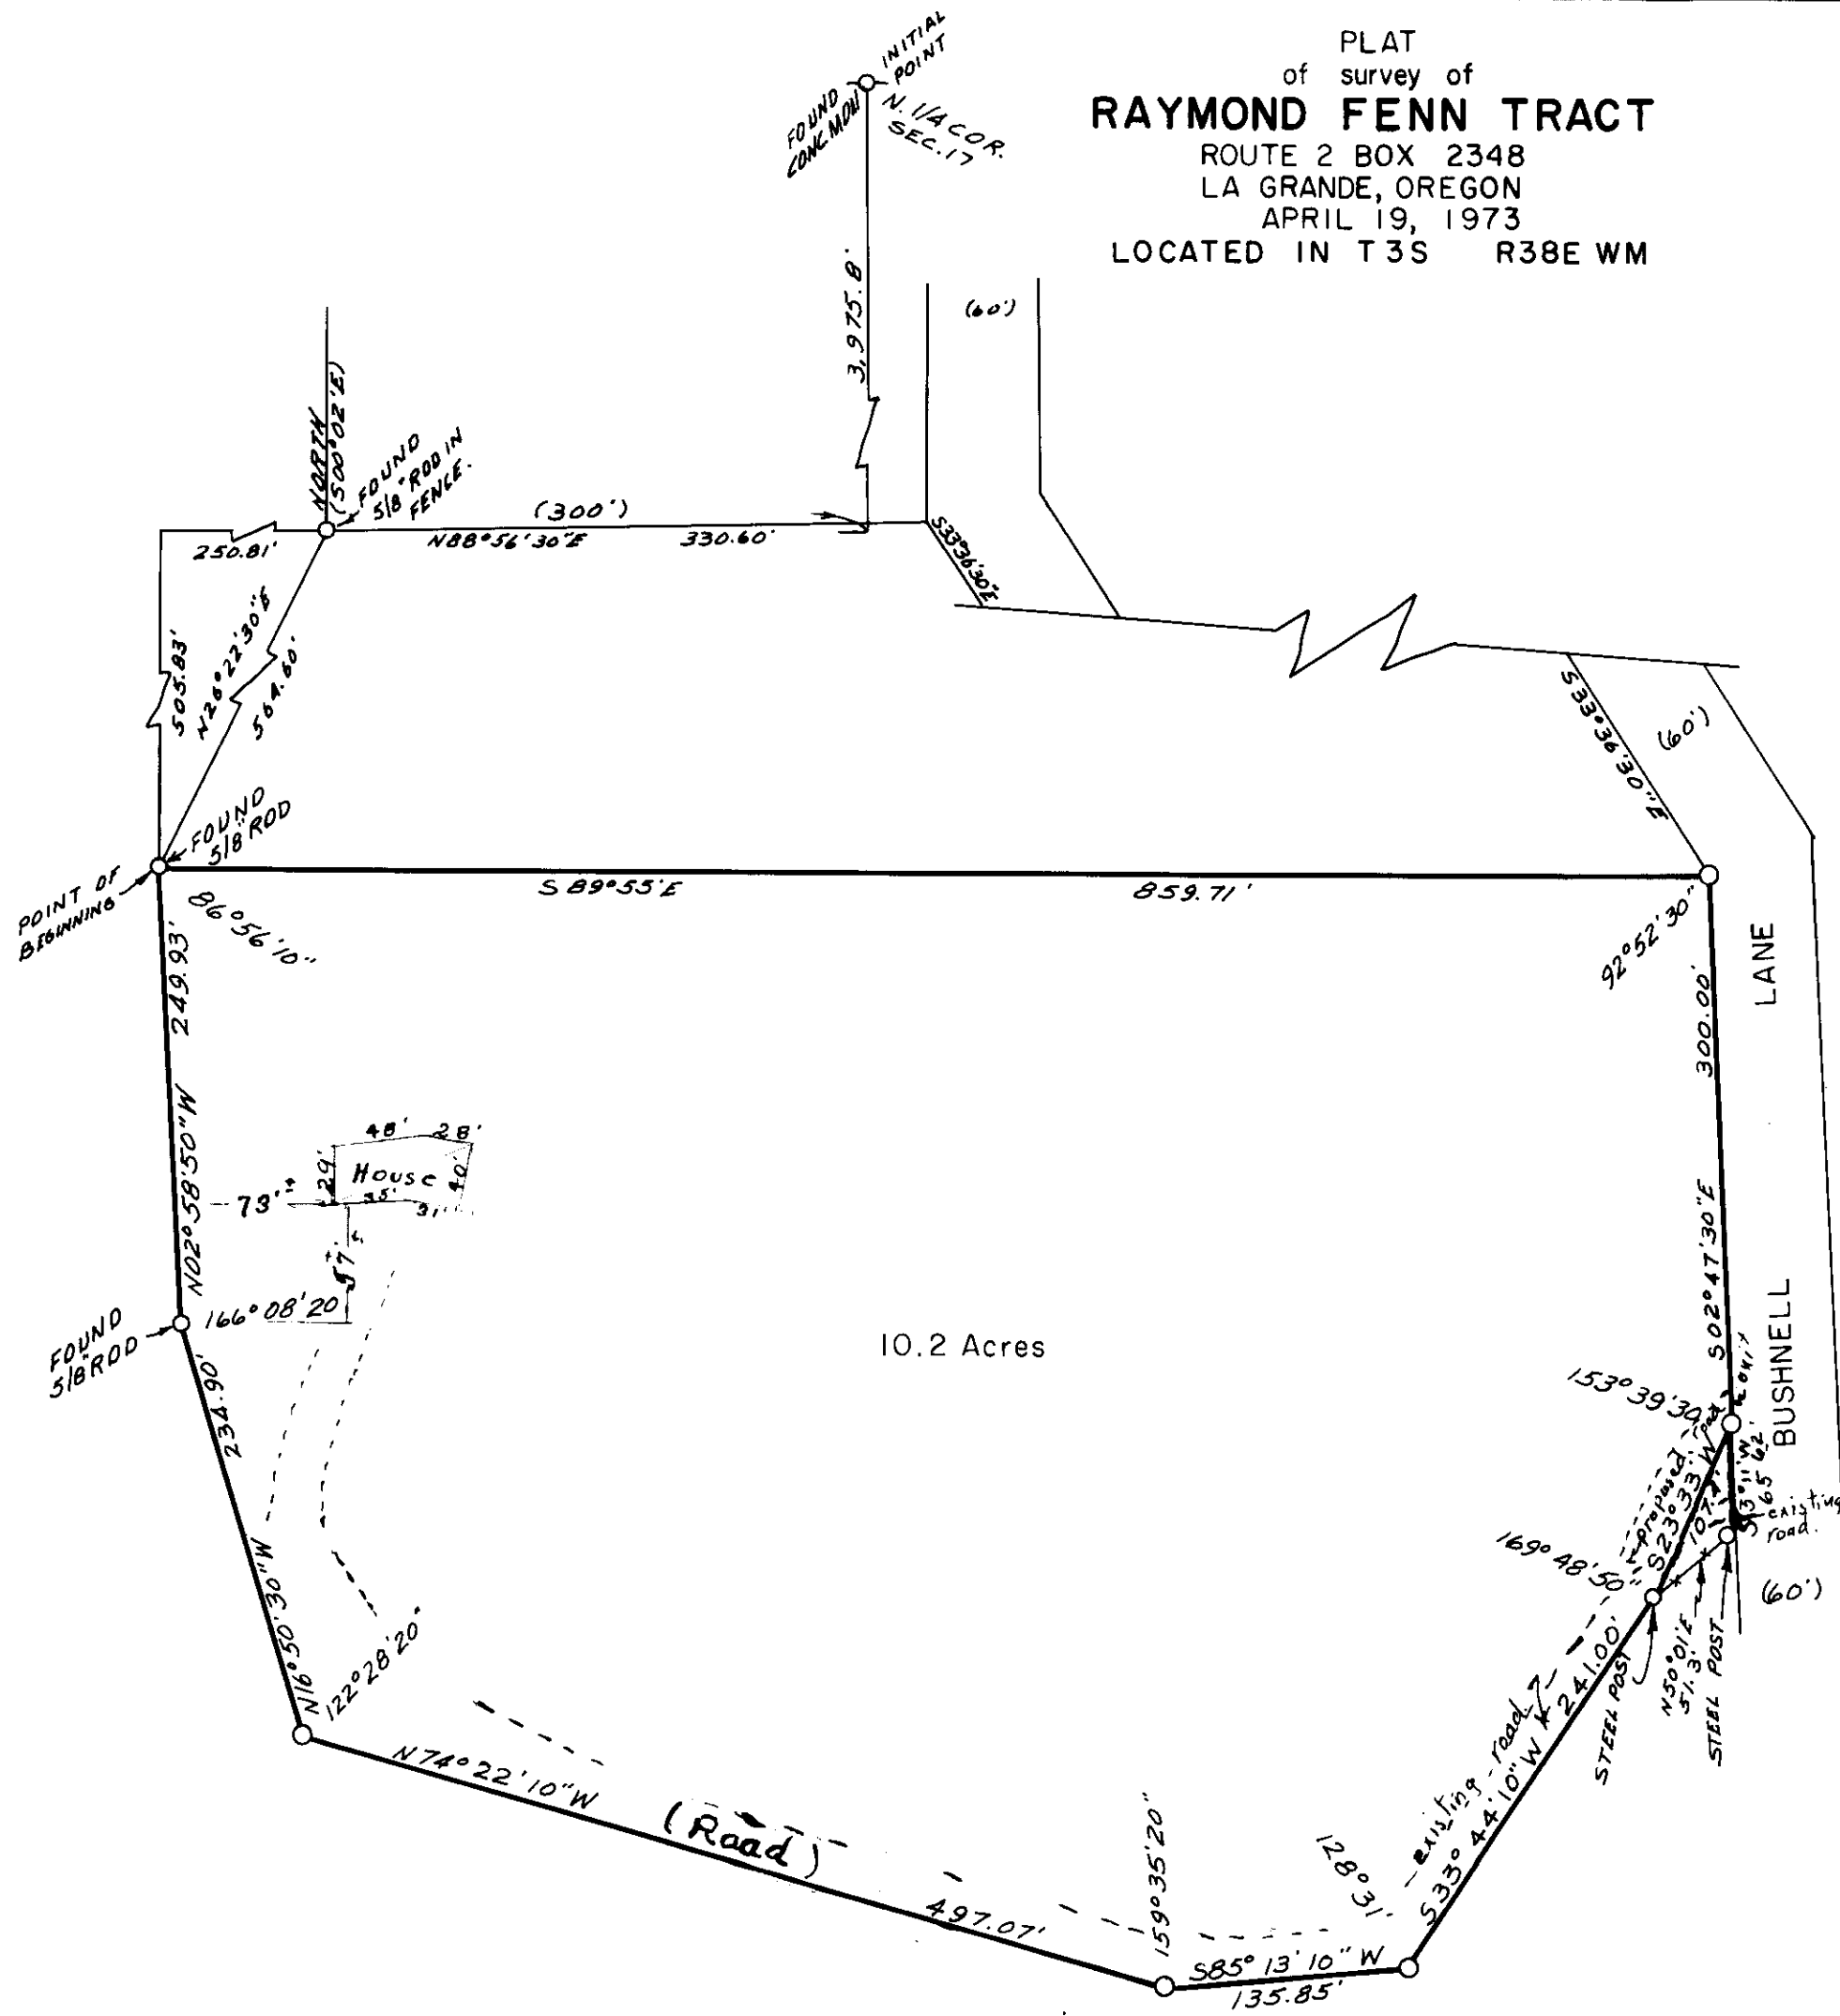


PLAT
of survey of
RAYMOND FENN TRACT
ROUTE 2 BOX 2348
LA GRANDE, OREGON
APRIL 19, 1973
LOCATED IN T3S R38E WM

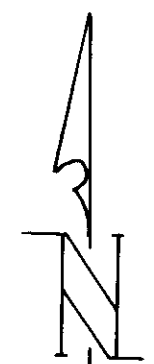

LEGEND
Scale 1"=100'
() Data of record.
○ Found monuments as indicated.
○ Set 5/8" X 30" steel rods.
--- Existing fences.

 

BASIS OF BEARINGS
Based on East line of
Spence's prop. as North.

38.28