


PLAT
of survey of
EVA MILLER LOT
702 "N" Avenue
La Grande, Oregon

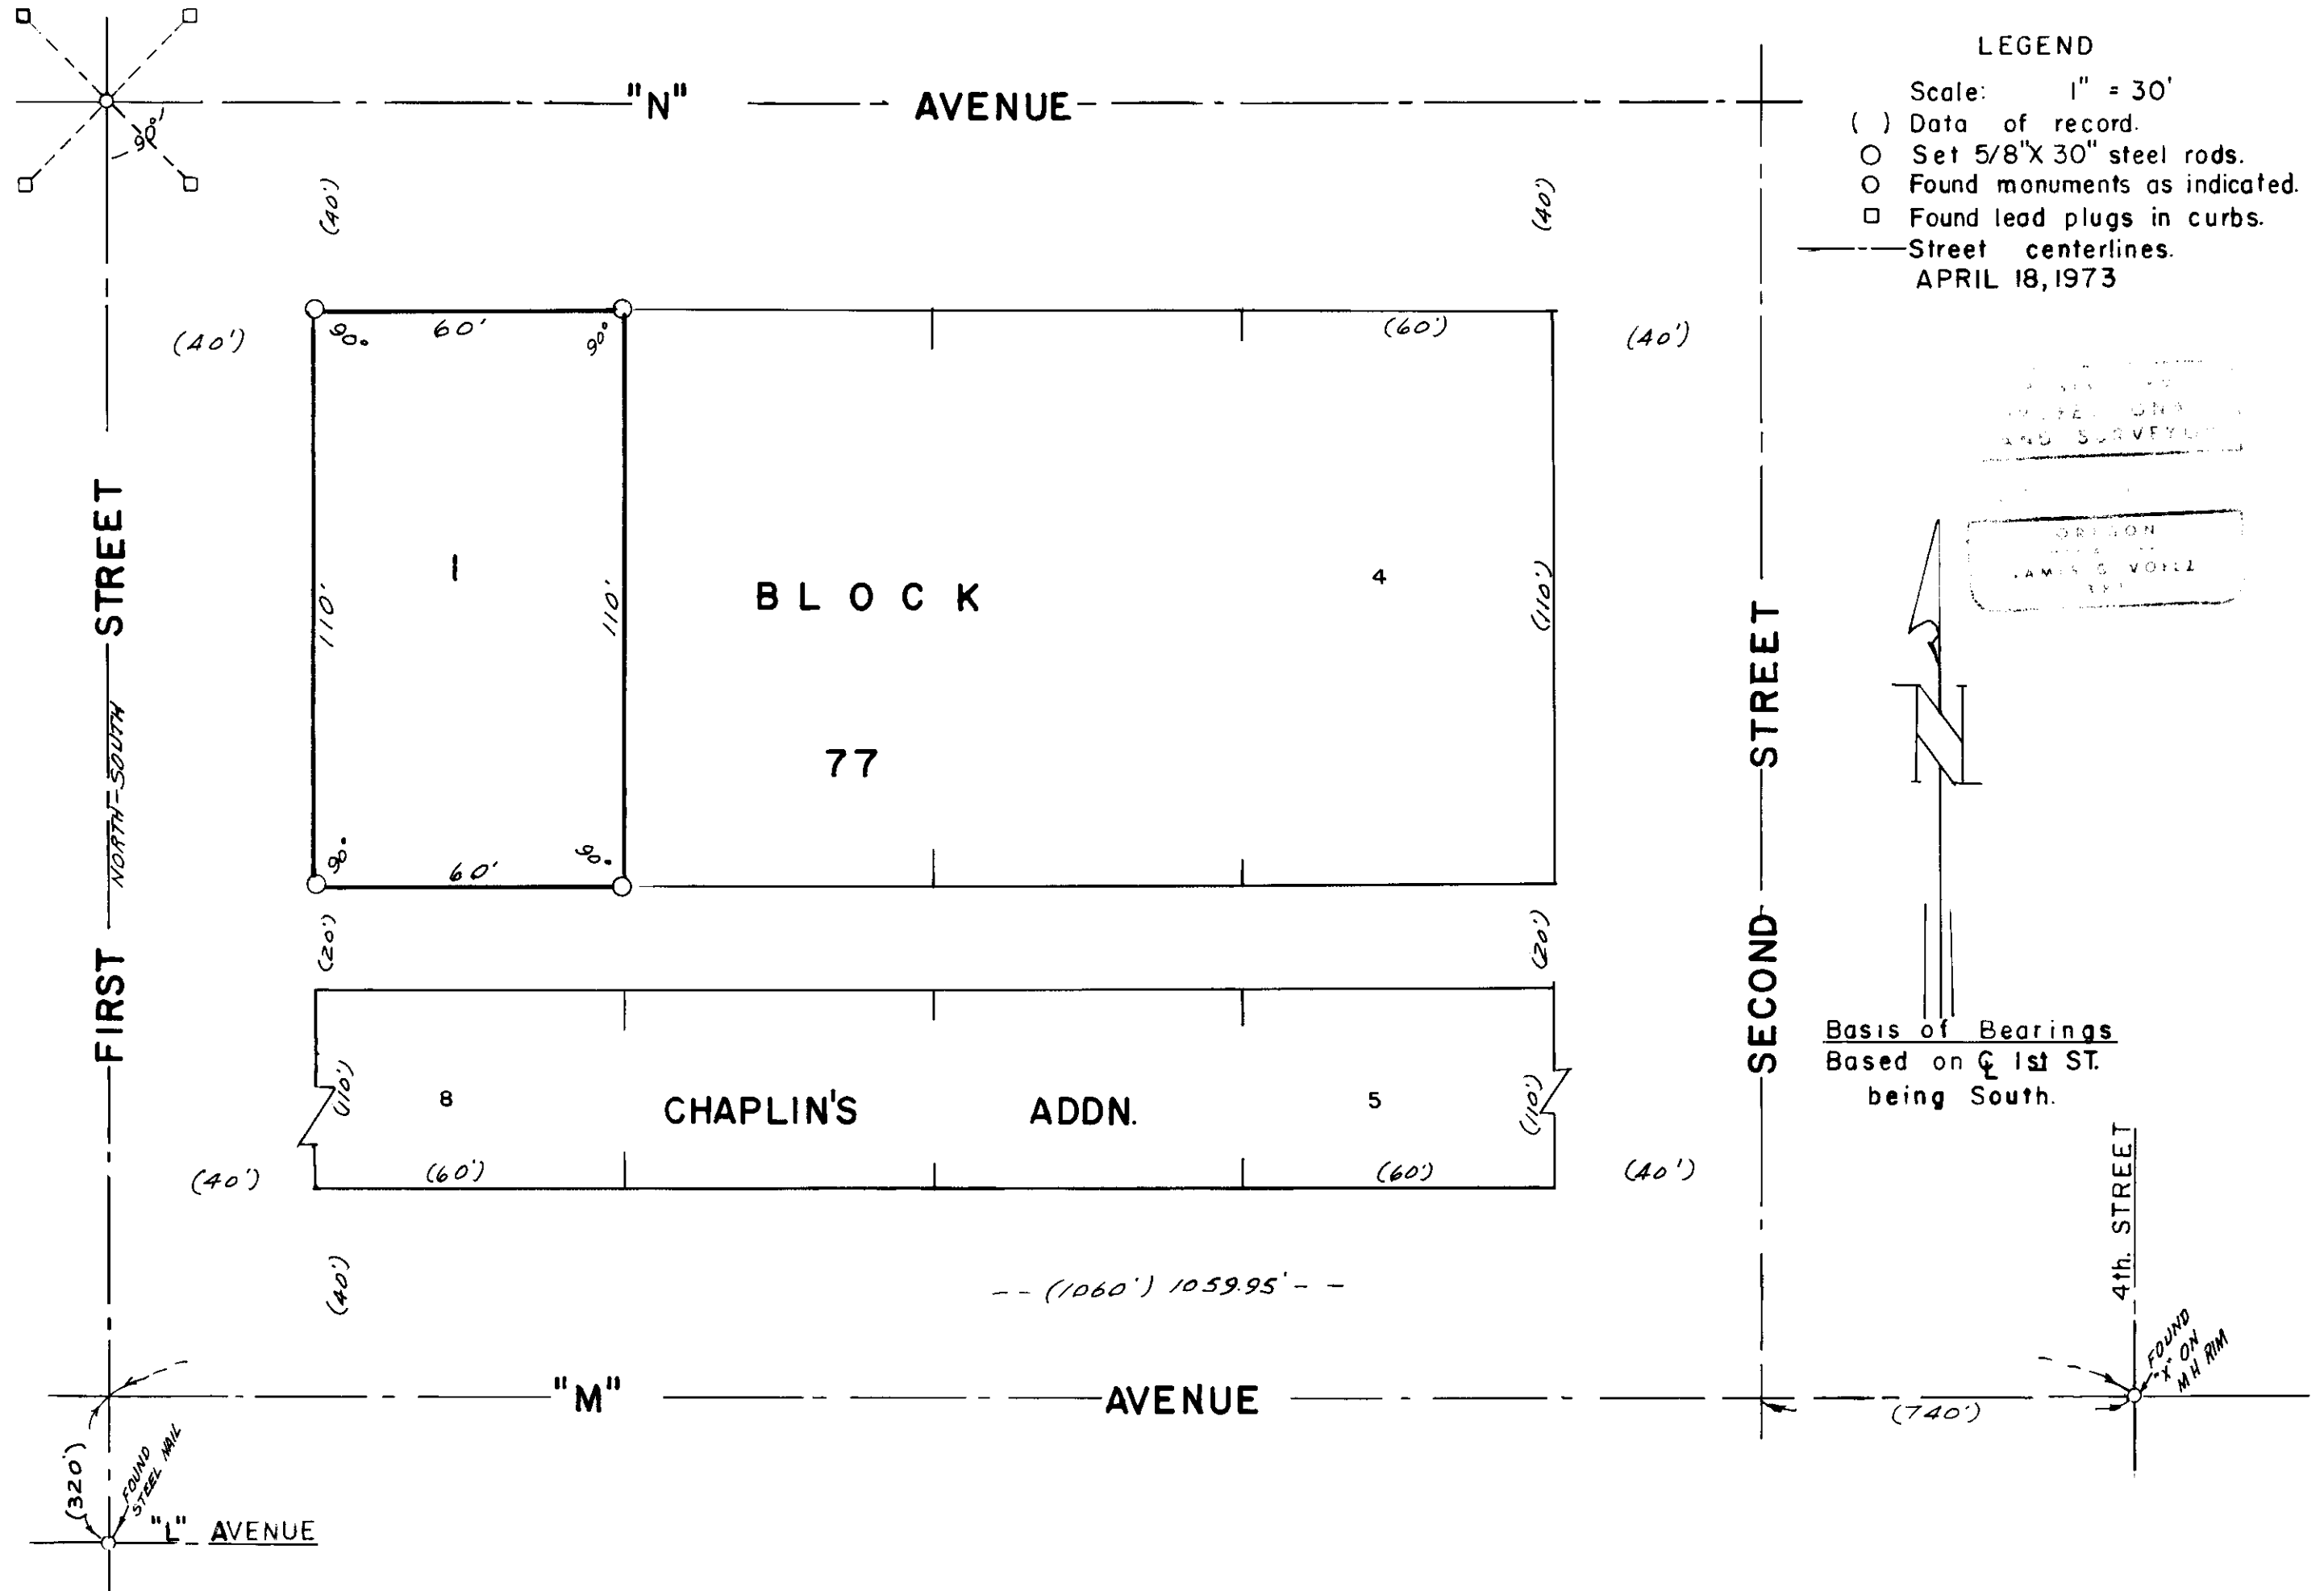

47-73