

PLAT
of survey of

FRANCES M. TOWLEY LOTS


UNION, OREGON

MAY 8, 1973

Located in ARNOLD'S & DRAYS ADDN.

to

La Grande, Oregon

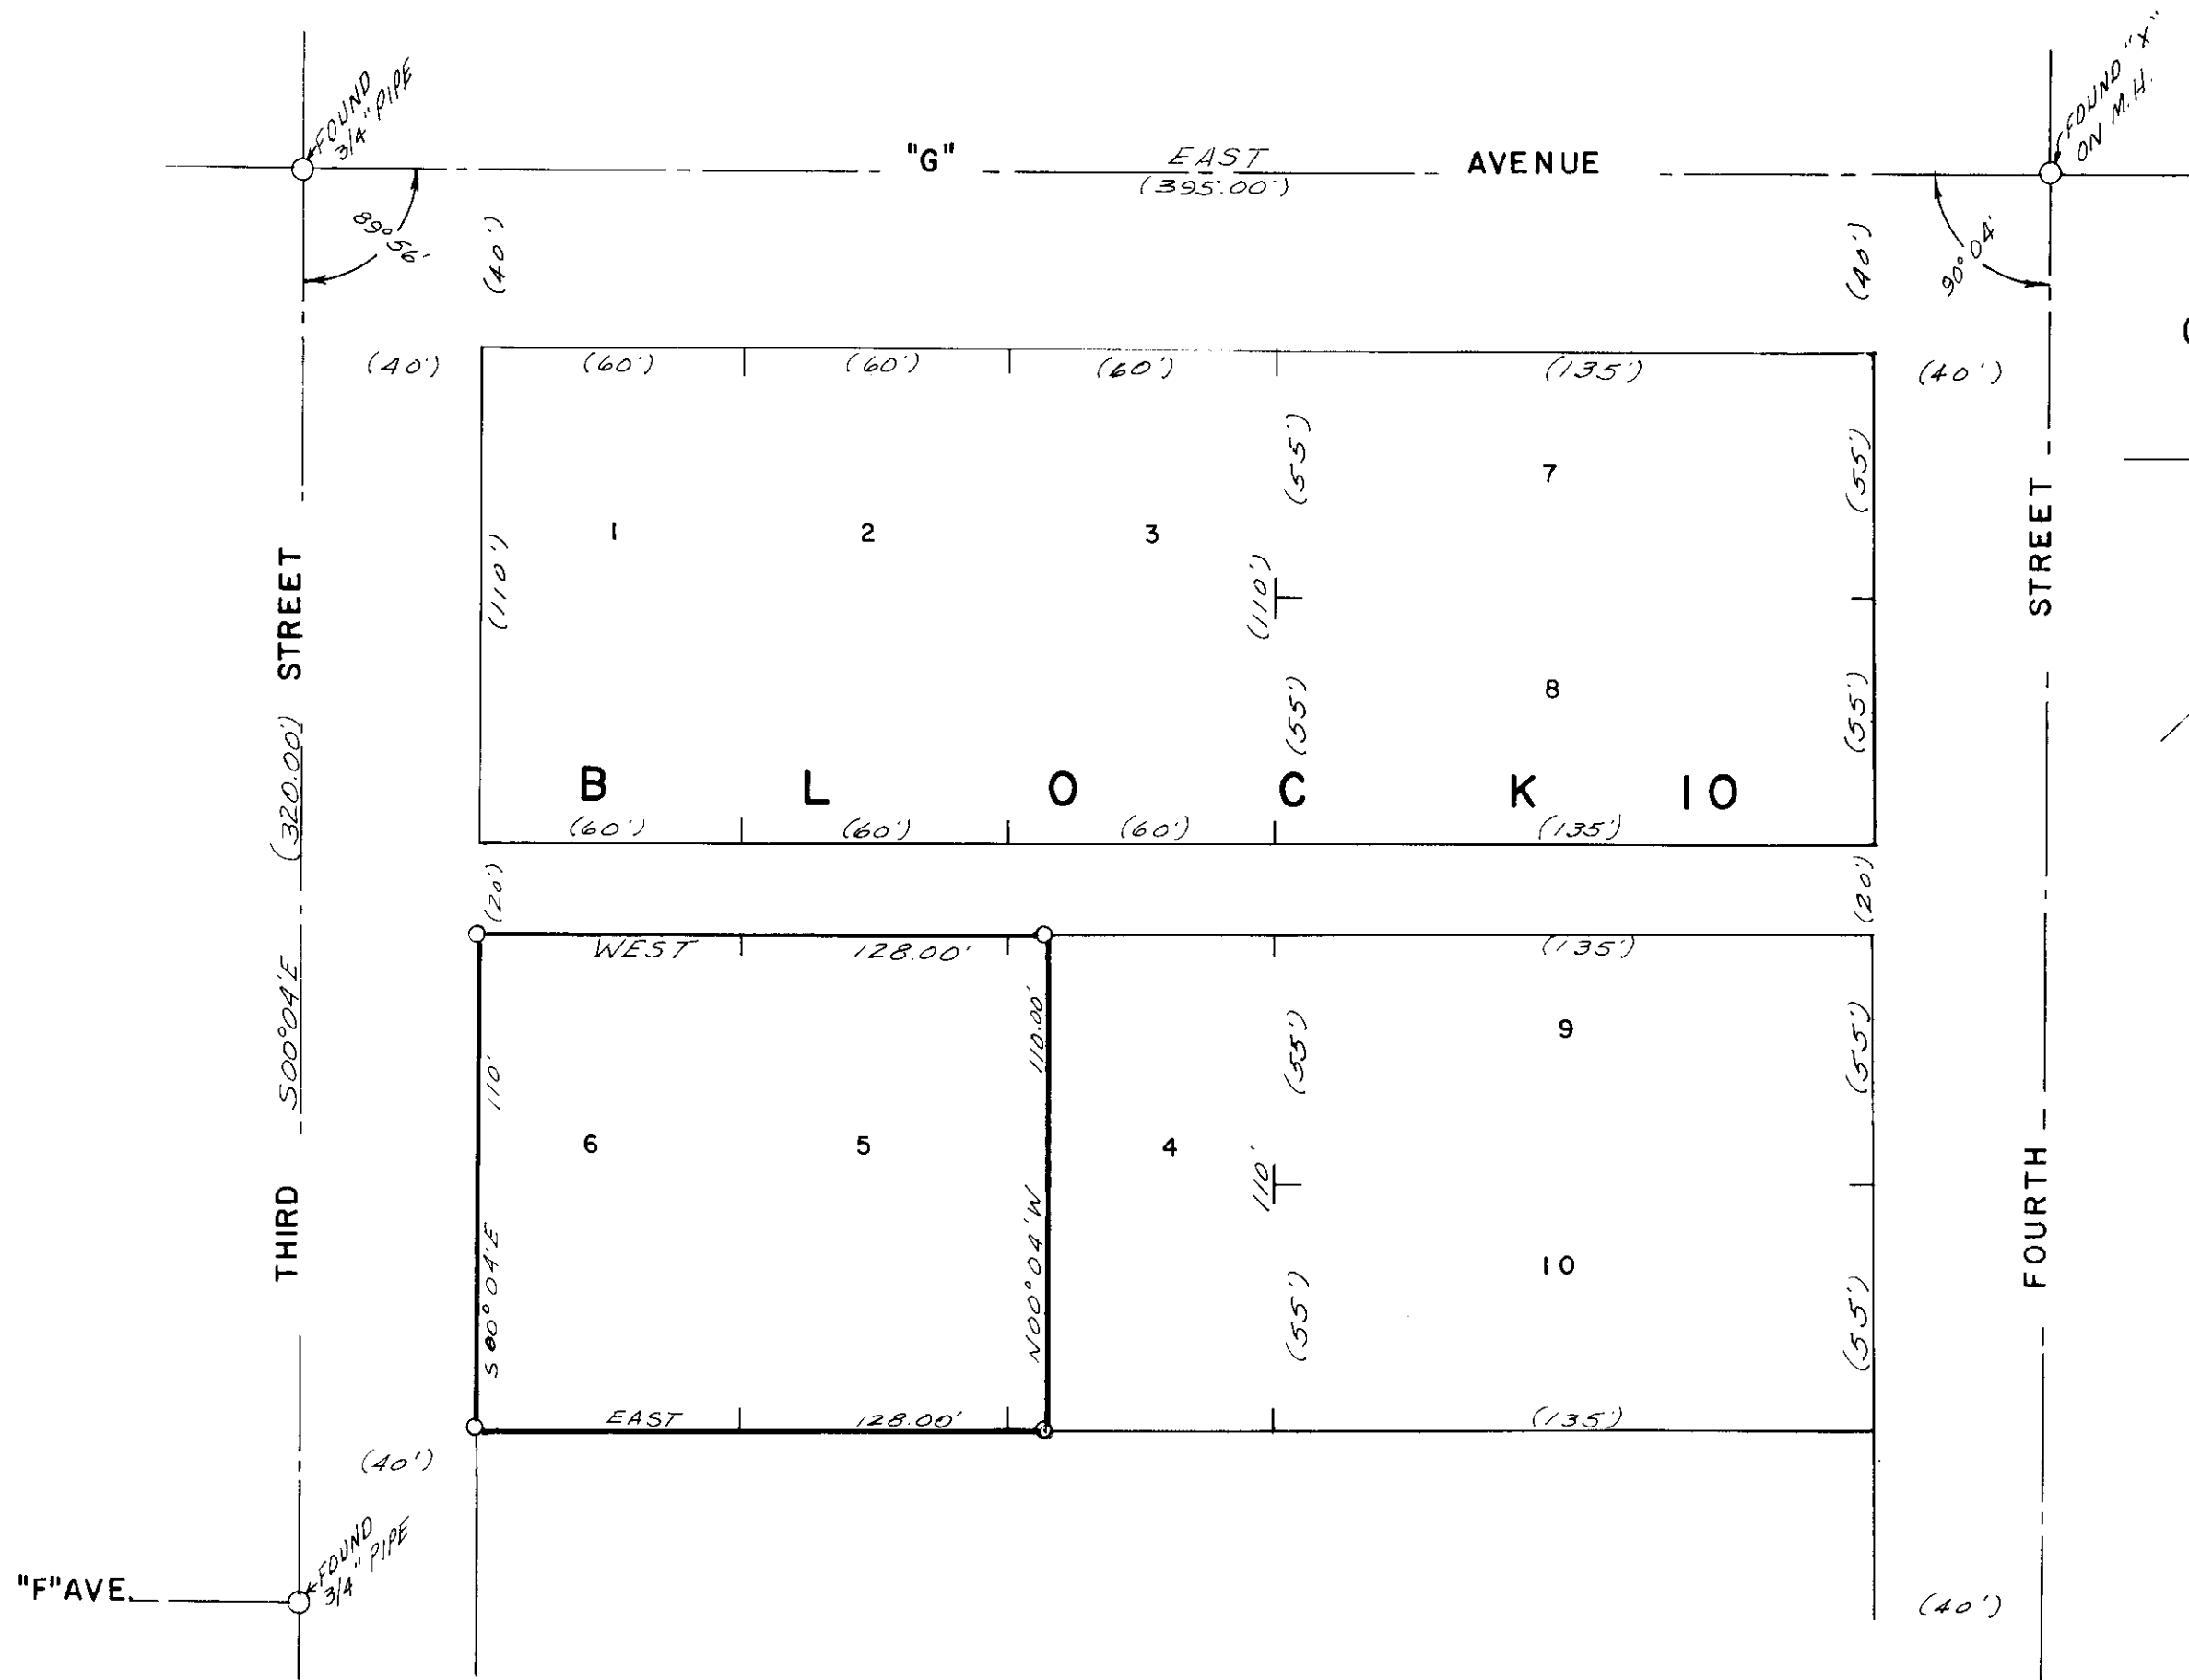

LEGEND

SCALE 1" = 40'

- () Data of record
- Found monuments as indicated
- Set 5/8" X 30" steel rods
- Center line of streets

