
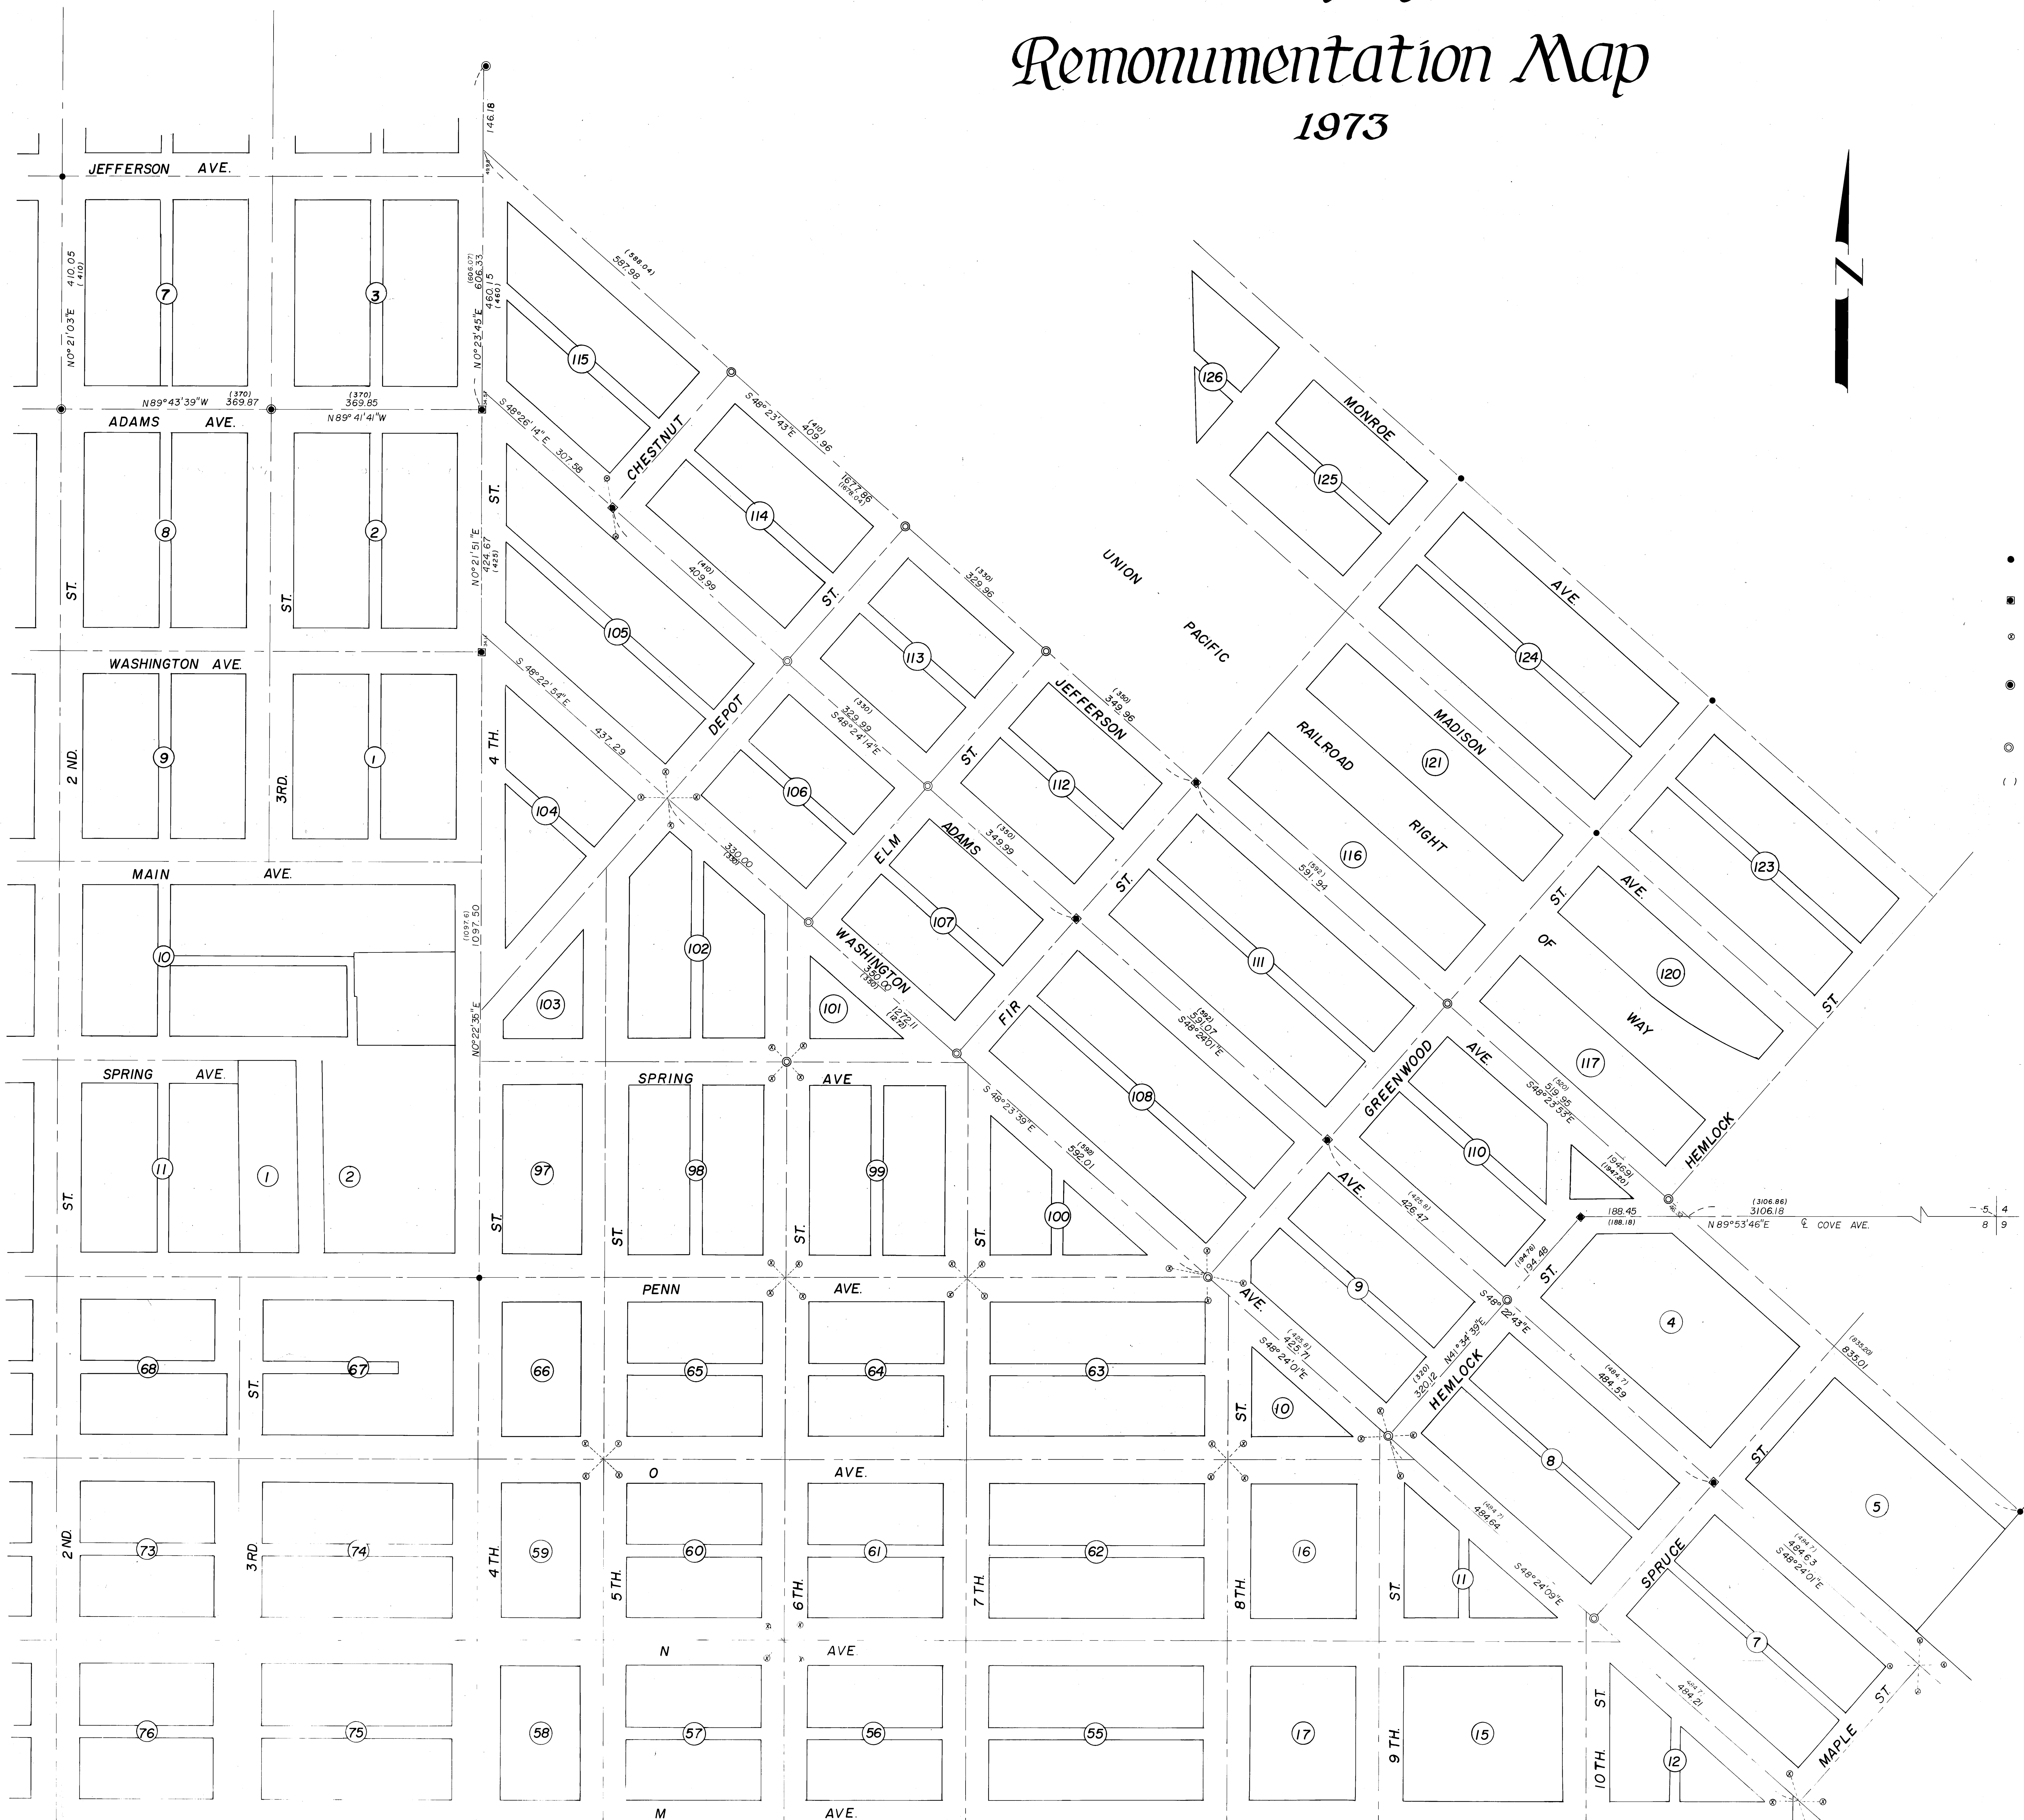


City of LaGrande

Re monumentation Map

1973

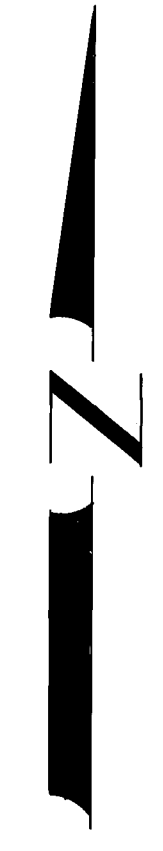

LEGEND

- FD. MONUMENT OF RECORD (McLEAN'S 1922 SURVEY)
- FD. MONUMENT OF RECORD IN A 6" PIPE WITH LID
- ⊙ FD. REFERENCE MARK OF RECORD
- ⊙ FD. MONUMENT OF RECORD & REPLACED BY 5"x30" CONCRETE CYLINDER WITH BRASS TABLET; COVERED WITH 6" WATER VALVE COVER TABLET MARKED WITH AN "X" AT INTERSECT POINT.
- ⊙ SET MONUMENT AS DESCRIBED ABOVE AT PROPORTIONATE DISTANCE
- () RECORD DISTANCE

REGISTERED
PROFESSIONAL
LAND SURVEYOR
Diane J. Griffith
OREGON
DIANE J. GRIFFITH
6-4

BAGETT-GRIFFITH-FERGUSON
LaGrande, Oregon
Map of Survey
Intersection Monument Restoration
LaGrande
UNION COUNTY, OREGON
SURVEYED FOR *City of LaGrande* BY *D.J.G.*
DESIGNED FOR _____ BY _____
Scale: 1"=100' Drawn by *d.j.g.* **May 1, 1973**

6373