



PLAT
of survey of
FRANK A. NIELSEN TRACT

UNION, OREGON
LOCATED IN THE NW 1/4 NE 1/4 OF SECTION 19 T4S R40E WM.
SEPTEMBER 19, 1973

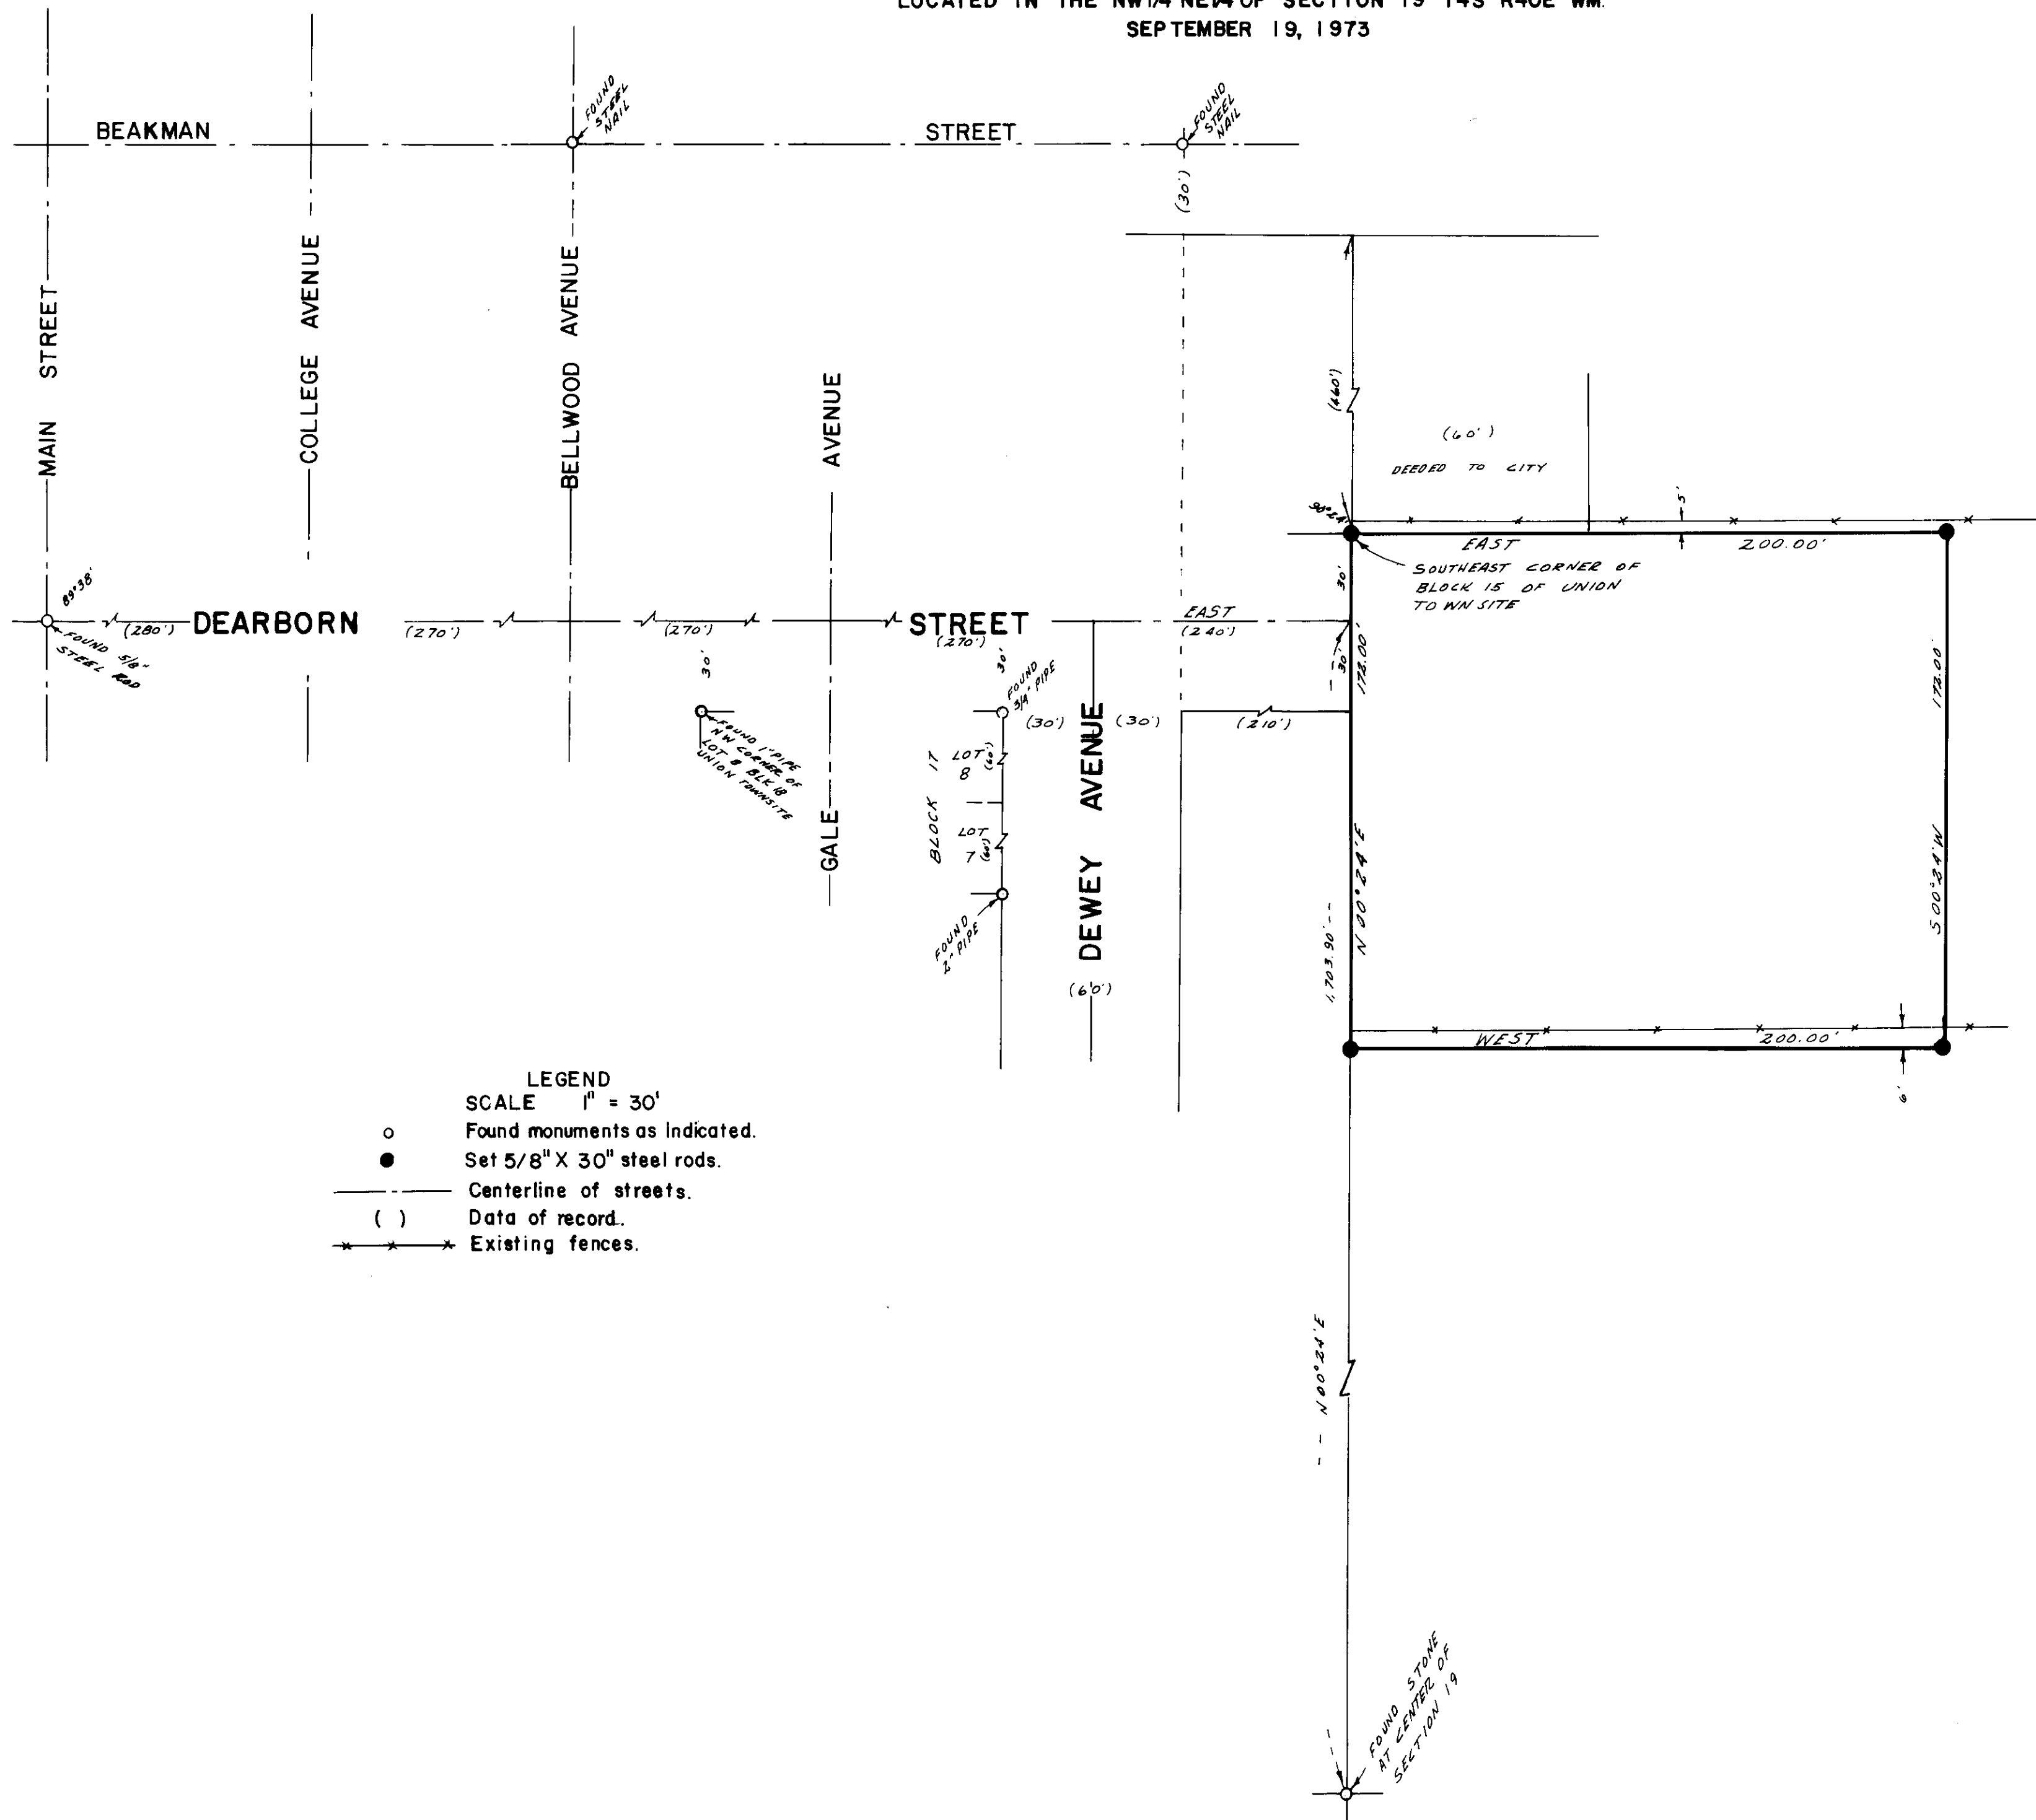

- LEGEND**
SCALE 1" = 30'
- Found monuments as indicated.
 - Set 5/8" X 30" steel rods.
 - Centerline of streets.
 - () Data of record.
 - * * * Existing fences.

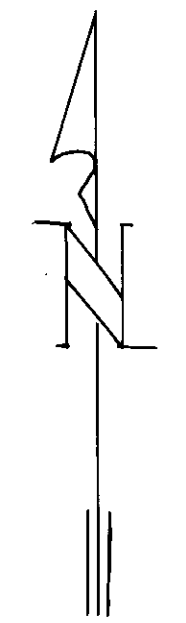

BASIS OF BEARINGS
BASED ON \hat{c} OF
DEARBORN STREET
BEING EAST

REGISTERED
PROFESSIONAL
LAND SURVEYOR
James G. Voelz
OREGON
MAY 4, 1956
JAMES G. VOELZ
381