


BAXTER PROPERTY SURVEY

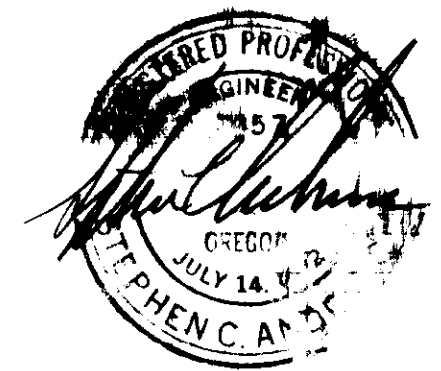


- LEGEND**
- - SET 1/8" X 30" STEEL PIN
 - X— EXISTING FENCE
 - () DATA ON RECORD

NOTE:
ASSUMED WEST PROPERTY HAS A BEARING OF NORTH

MARCH 8, 1974

**STEPHEN C. ANDERSON
& ASSOCIATES
LAGRANDE, OREGON**

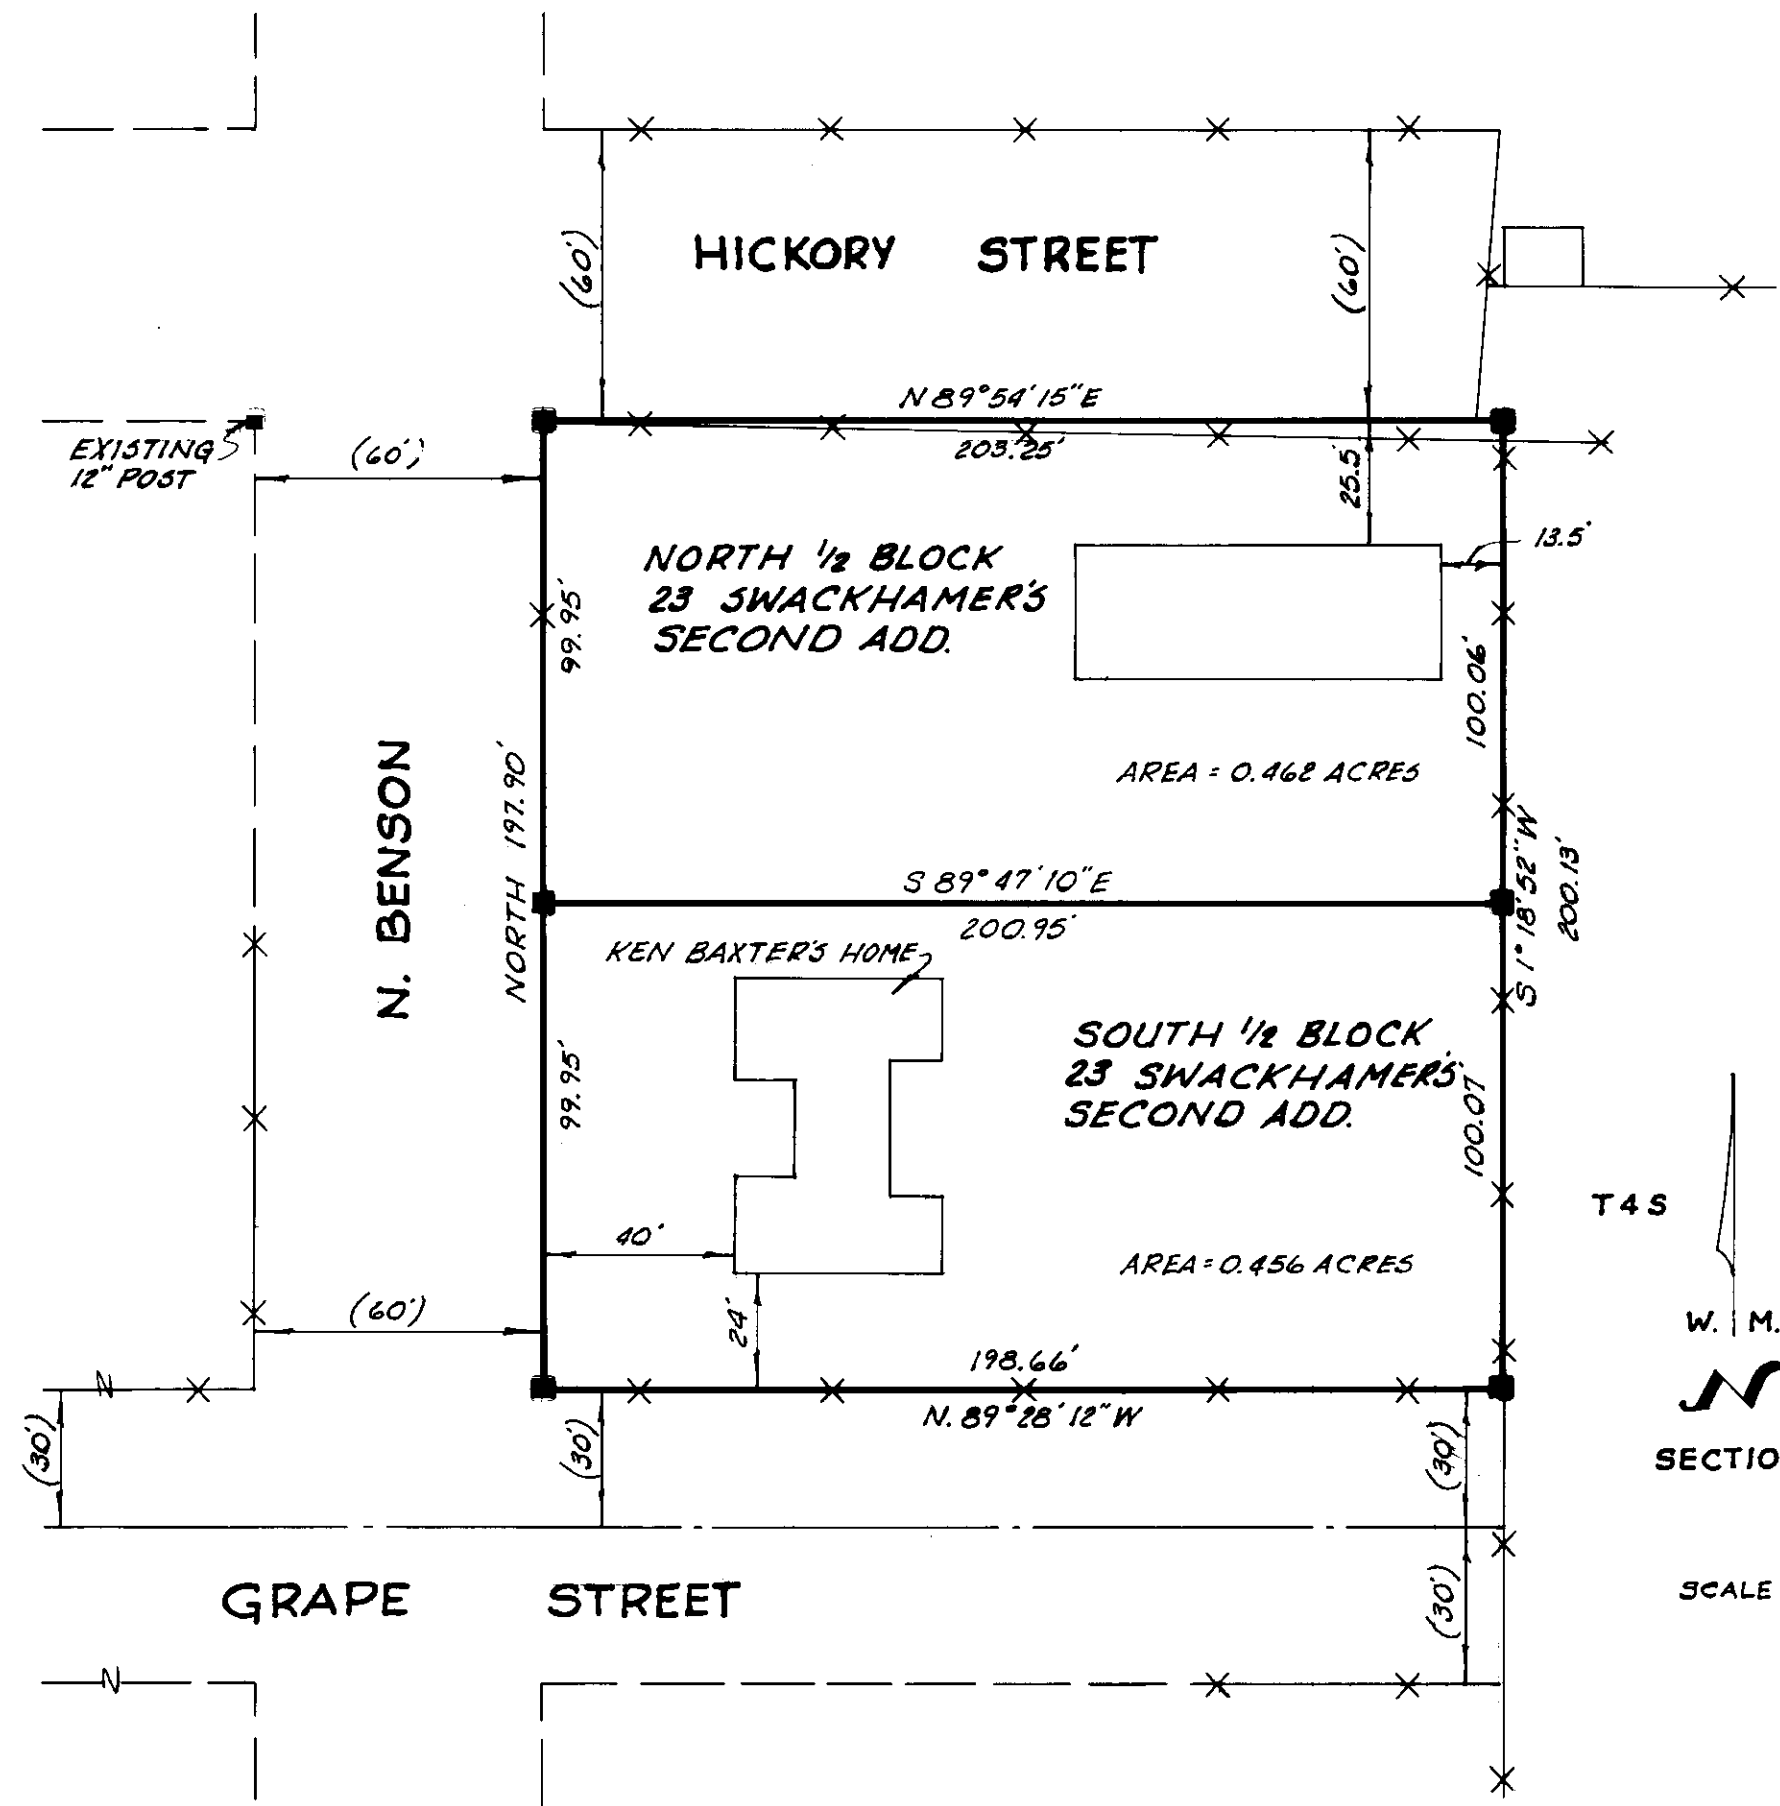

T 4 S R 40 E

W. M.

SECTION 18

SCALE 1" = 40'