
ALL BEING SITUATE IN THE SW $\frac{1}{4}$  OF SECTION 20, TWP. 13., R. 39 E.; W.M.

Date: March 29, 1974 Scale: 1" = 100' Bearings: True

P.O.B.: Established from 5/8" rods located at the Intersections of Main and Esther Streets, and at 3rd and Esther Streets as shown.

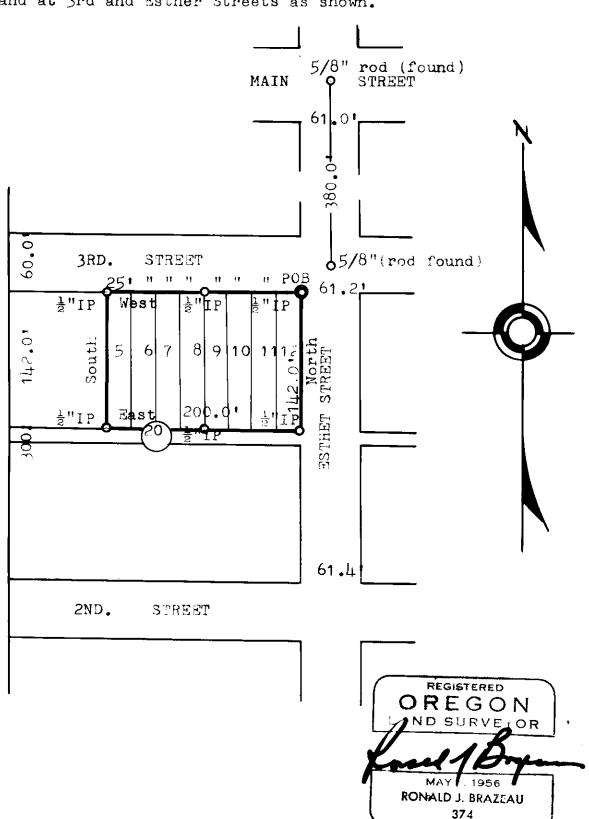

Prepared by Eastern Oregon Land Surveys La Grande, Oregon, 3-29-74 x