SKETCH-MAP OF PARCEL OF LAND LOCATED AND DESCRIBED AS BEING LOT #4, AND THE EAST 35 FEET OF THE NORTH ONE HALF OF LOT #5, OF BLOCK #1, OF THE SUNNYSIDE ADDITION TO THE CITY OF LA GRANDE, UNION COUNTY, OREGON.

Date: April 16, 1974 Scale: 1" = 100'

True: Established from Union County Survey #48-72 (J.G.V.) 5/8" iron rods found on the Bearings:

west side of above survey.


Distances: Same as above

Recorded: Book 153 Page 199 (UCRD)

Micro. #: 40163

PREPARED BY:

EASTERN OREGON LAND SURVEYS LA GRANDE, OREGON

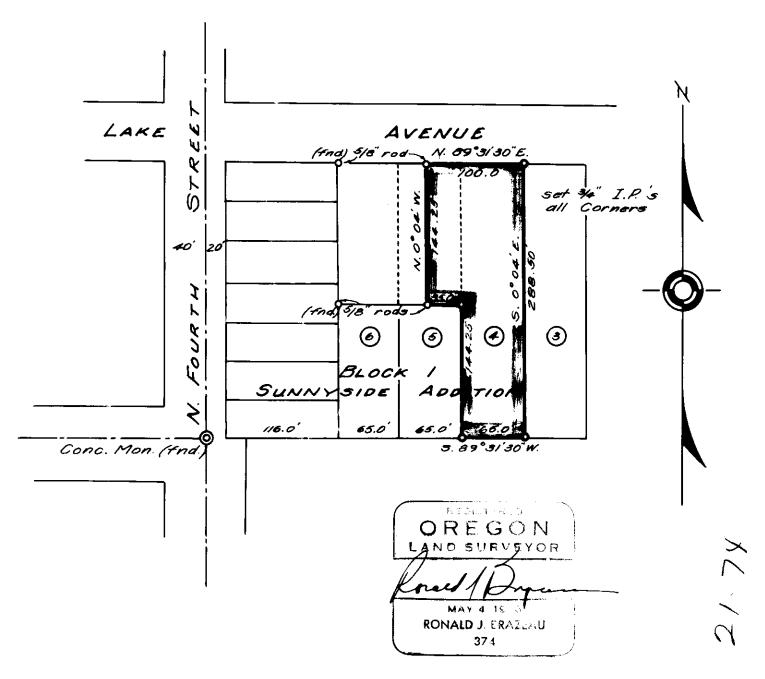

Recorded: CO. Sur.: 4-17-74