


RECORD OF SURVEY
FOR
SCHOOL DISTRICT No. 1
OF
BLOCK 5, HONAN'S ADDITION
TO
CITY OF LA GRANDE, OREGON

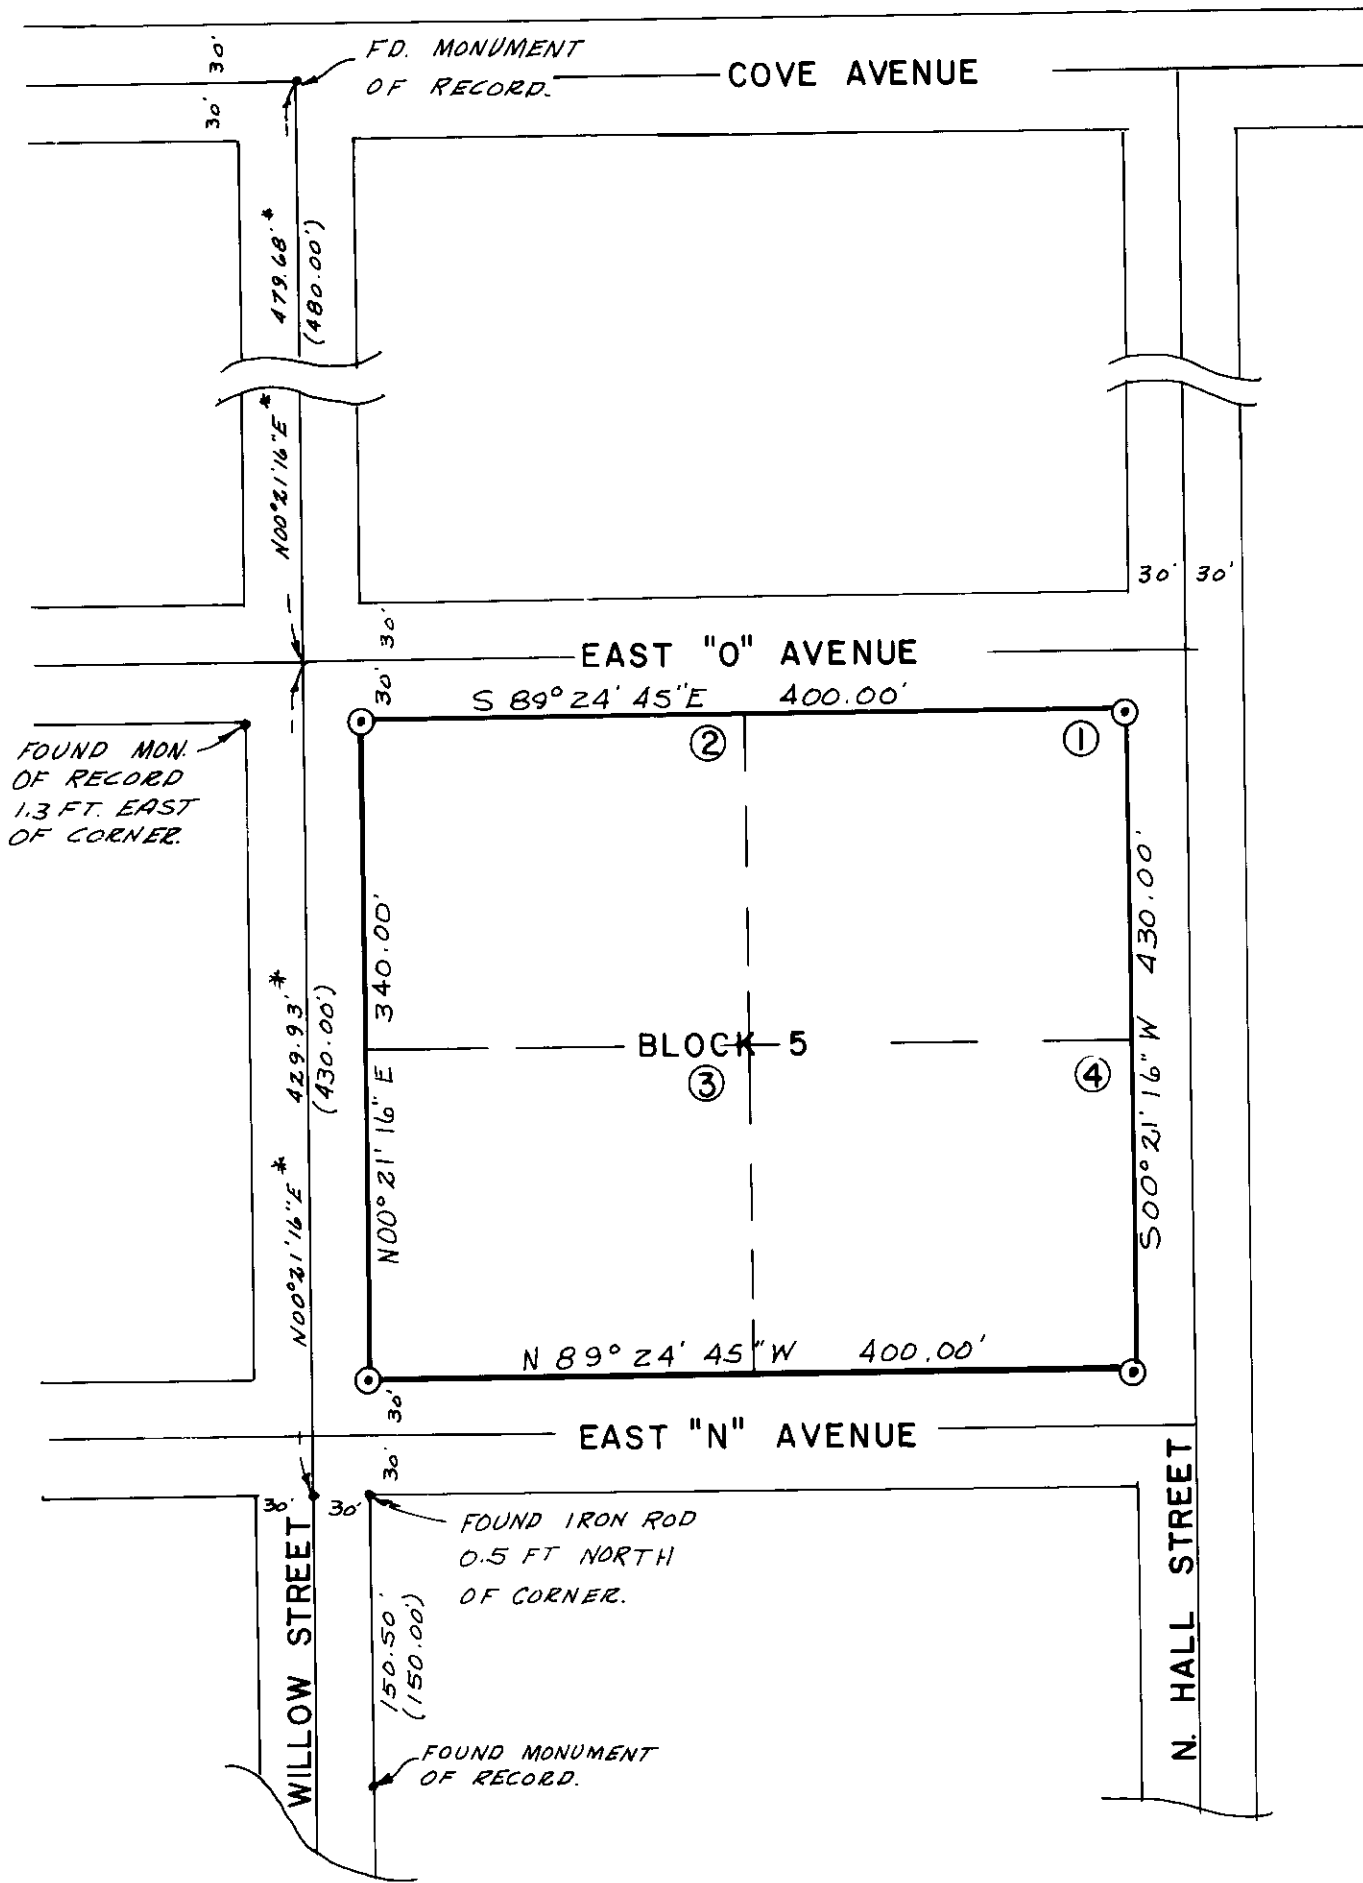

SCALE 1" = 100'
BASIS OF BEARINGS
BGF SURVEY No 23-71
APRIL 1971.

LEGEND

- FOUND MONUMENT OF RECORD.
- ⊙ SET 5/8" X 30" IRON PIN.
- * RECORD OF SURVEY No. 23-71 BEARING AND DISTANCE.
- () PLATTED DISTANCES.

Thomas A. Stoggin

SURVEYED FOR LA GRANDE SCHOOL DIST No. 1	
SURVEYED BY TELEK ENGINEERING LA GRANDE	
SCALE: 1" = 100'	DATE: MAY 20, 1974

23-71