



PLAT
of survey for
OSCAR L. & RITA M. JACOBSON

ROUTE 1 BOX 1475
LA GRANDE, OREGON
JUNE 5, 1974

LOCATED IN NE1/4 NW1/4 OF SECTION 16, T2S R38E W.M.

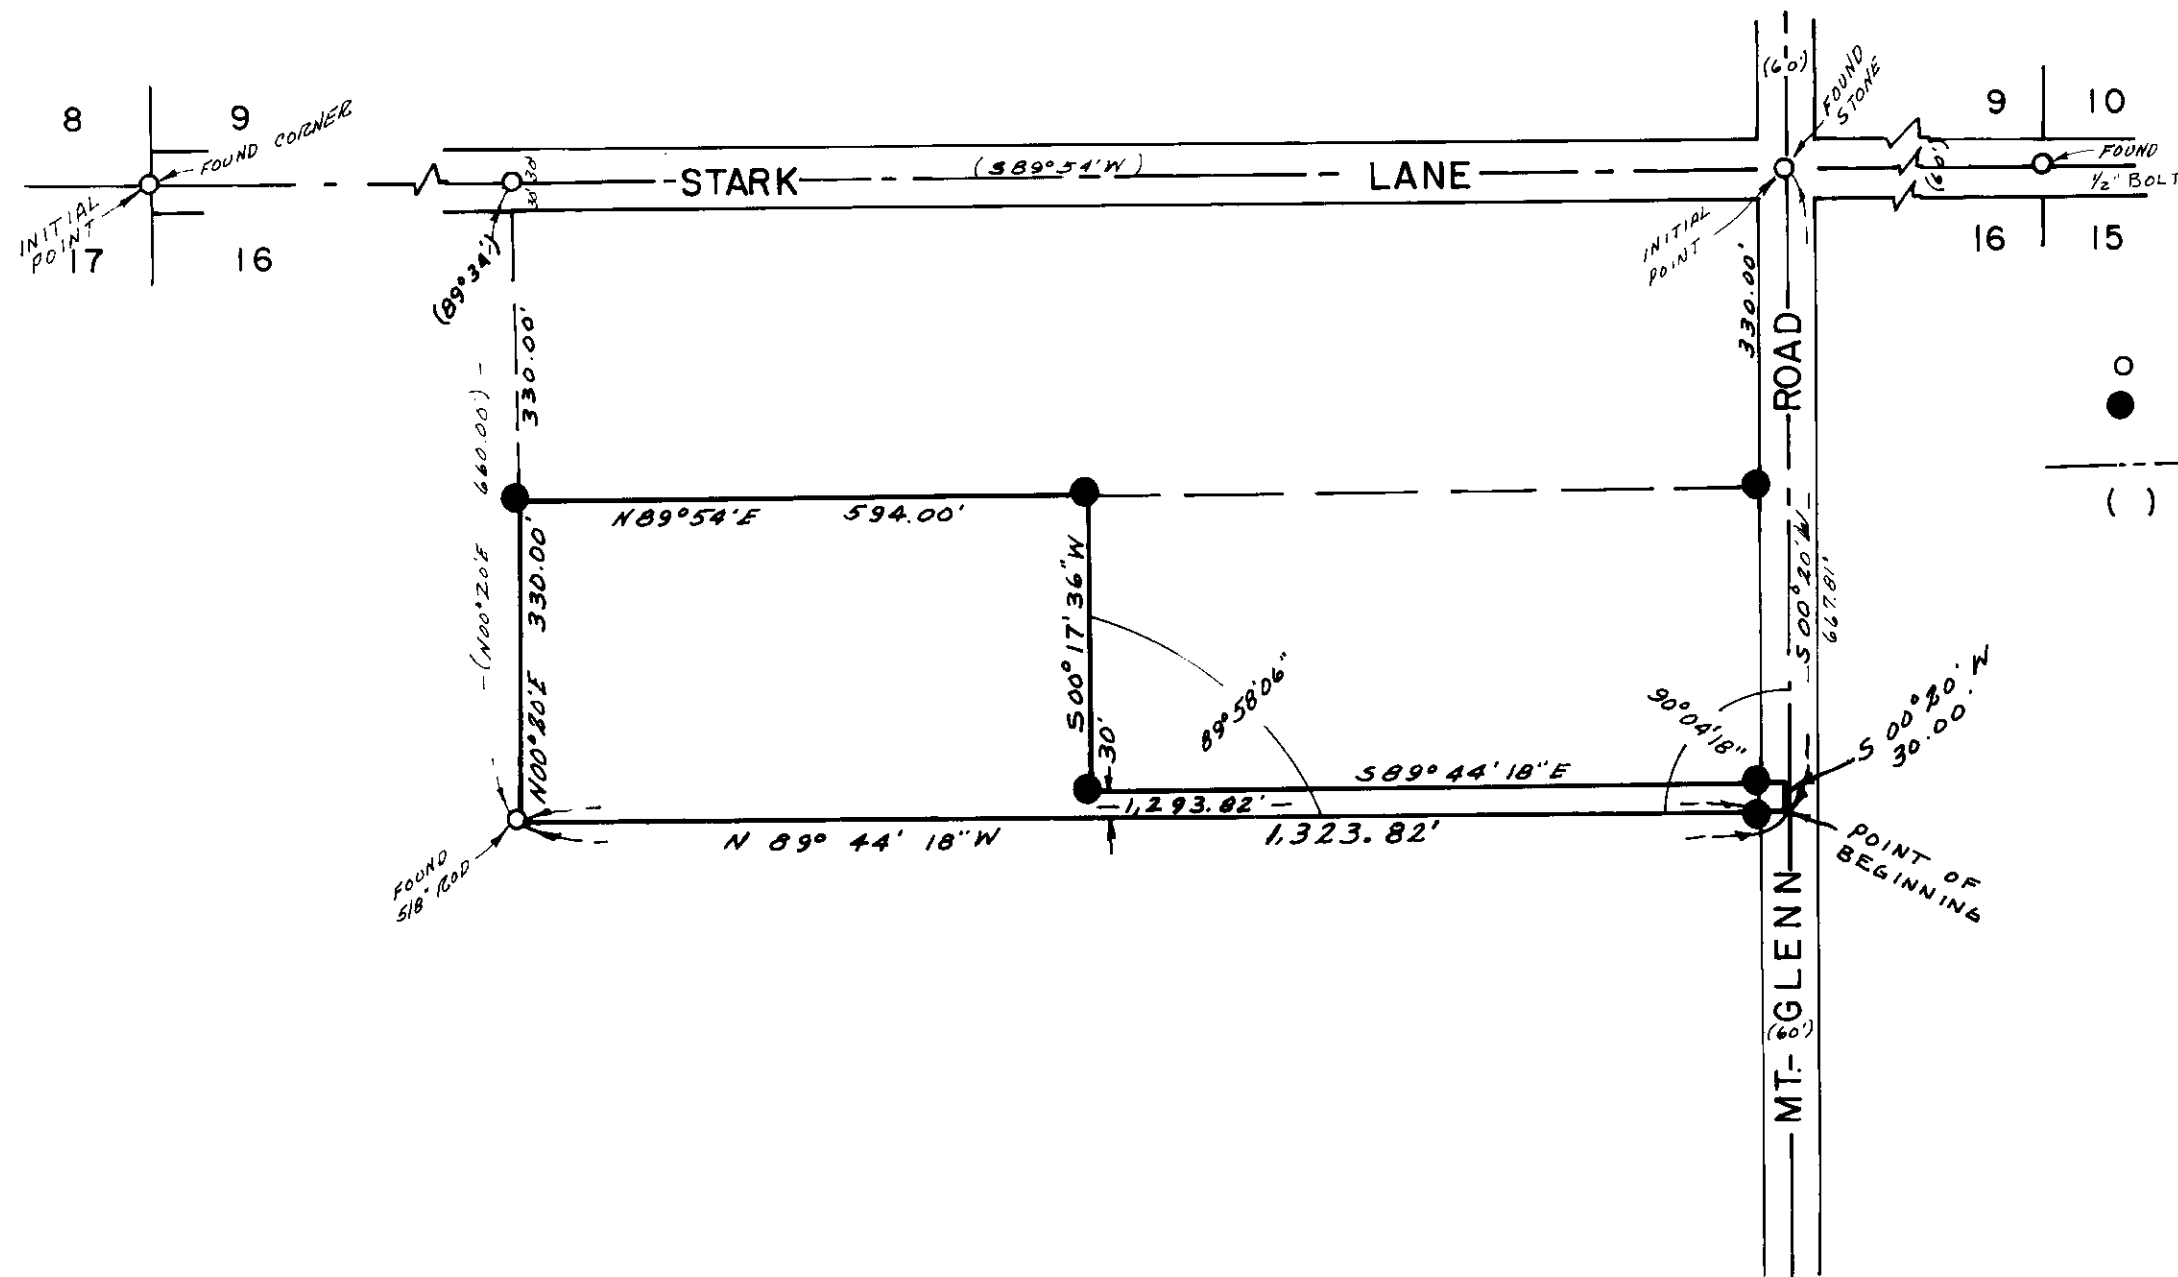

LEGEND
SCALE 1" = 200'
○ Found monuments as indicated.
● Set 5/8" X 30" steel rods.
--- Center line of roads.
() Data of record.

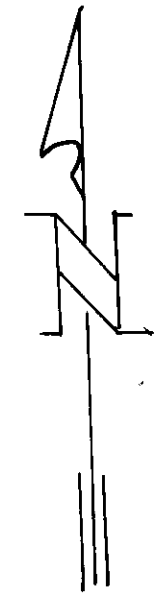

James D. [Signature]

BASIS OF BEARINGS
BASED ON N. LINE
SEC. 16 BEING
S 89° 54' W (GLO).