


PLAT
of survey for
DEWAYNE PFEASTER
1806 "X" AVENUE
LA GRANDE OREGON 97850

"Y" - AVE.

FOUND
3/4" PIPE
(BENT OVER)

INITIAL
POINT

IN LOTS 2 & 3, BLOCK 2 of PLEASANT HOME ADDITION (1902)

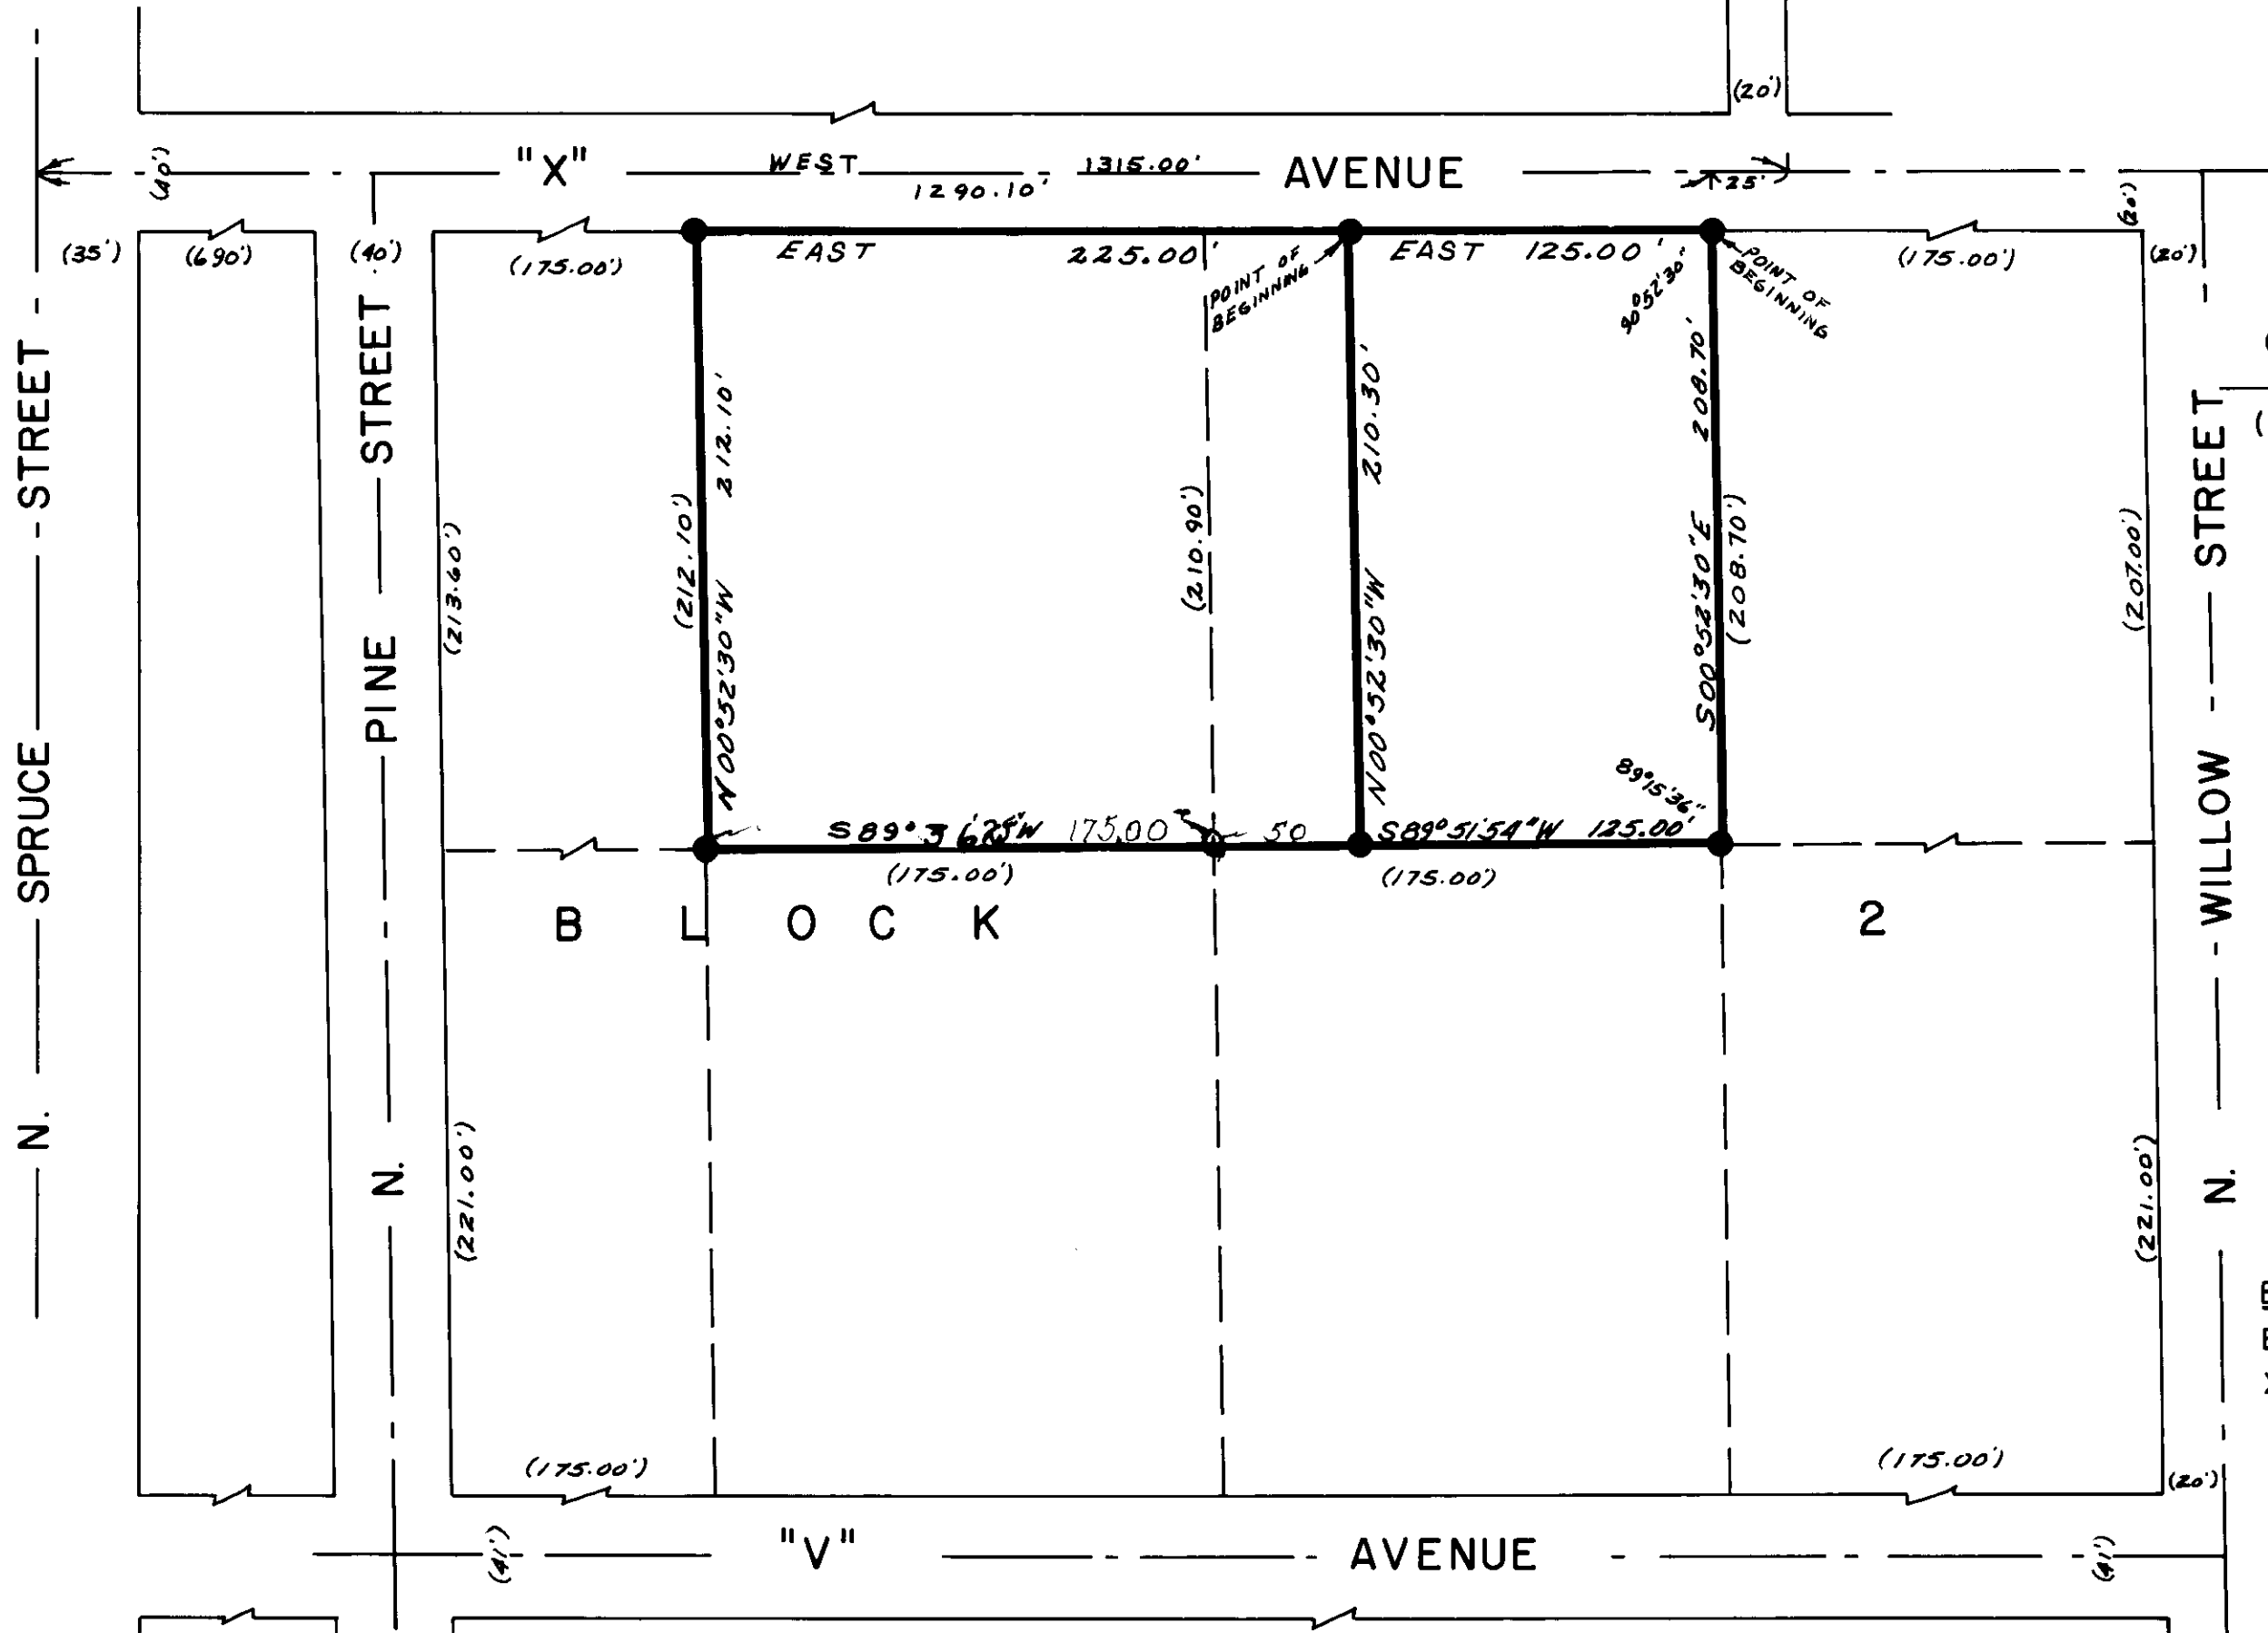

- LEGEND
SCALE 1" = 60'
- Found monuments as indicated.
 - Set 5/8" X 30" steel rods.
 - Center line of streets
 - () Data of record.
- MARCH 25, 1974

REGISTERED
PROFESSIONAL
LAND SURVEYOR
Janet D. Coyle
BRAND & ASSOCIATES

BASIS OF BEARINGS
Based on \odot of
X Ave being West.