



PLAT
of survey for
JOHN C. & RUBY TRAVIS
ELGIN, OREGON

SURVEY OF LOTS 12, 13, 14 AND A PORTION OF
LOTS 15, 16, 17 & 18 BLOCK 71 OF HINDMANS
ADDITION TO ELGIN
APRIL 12, 1974

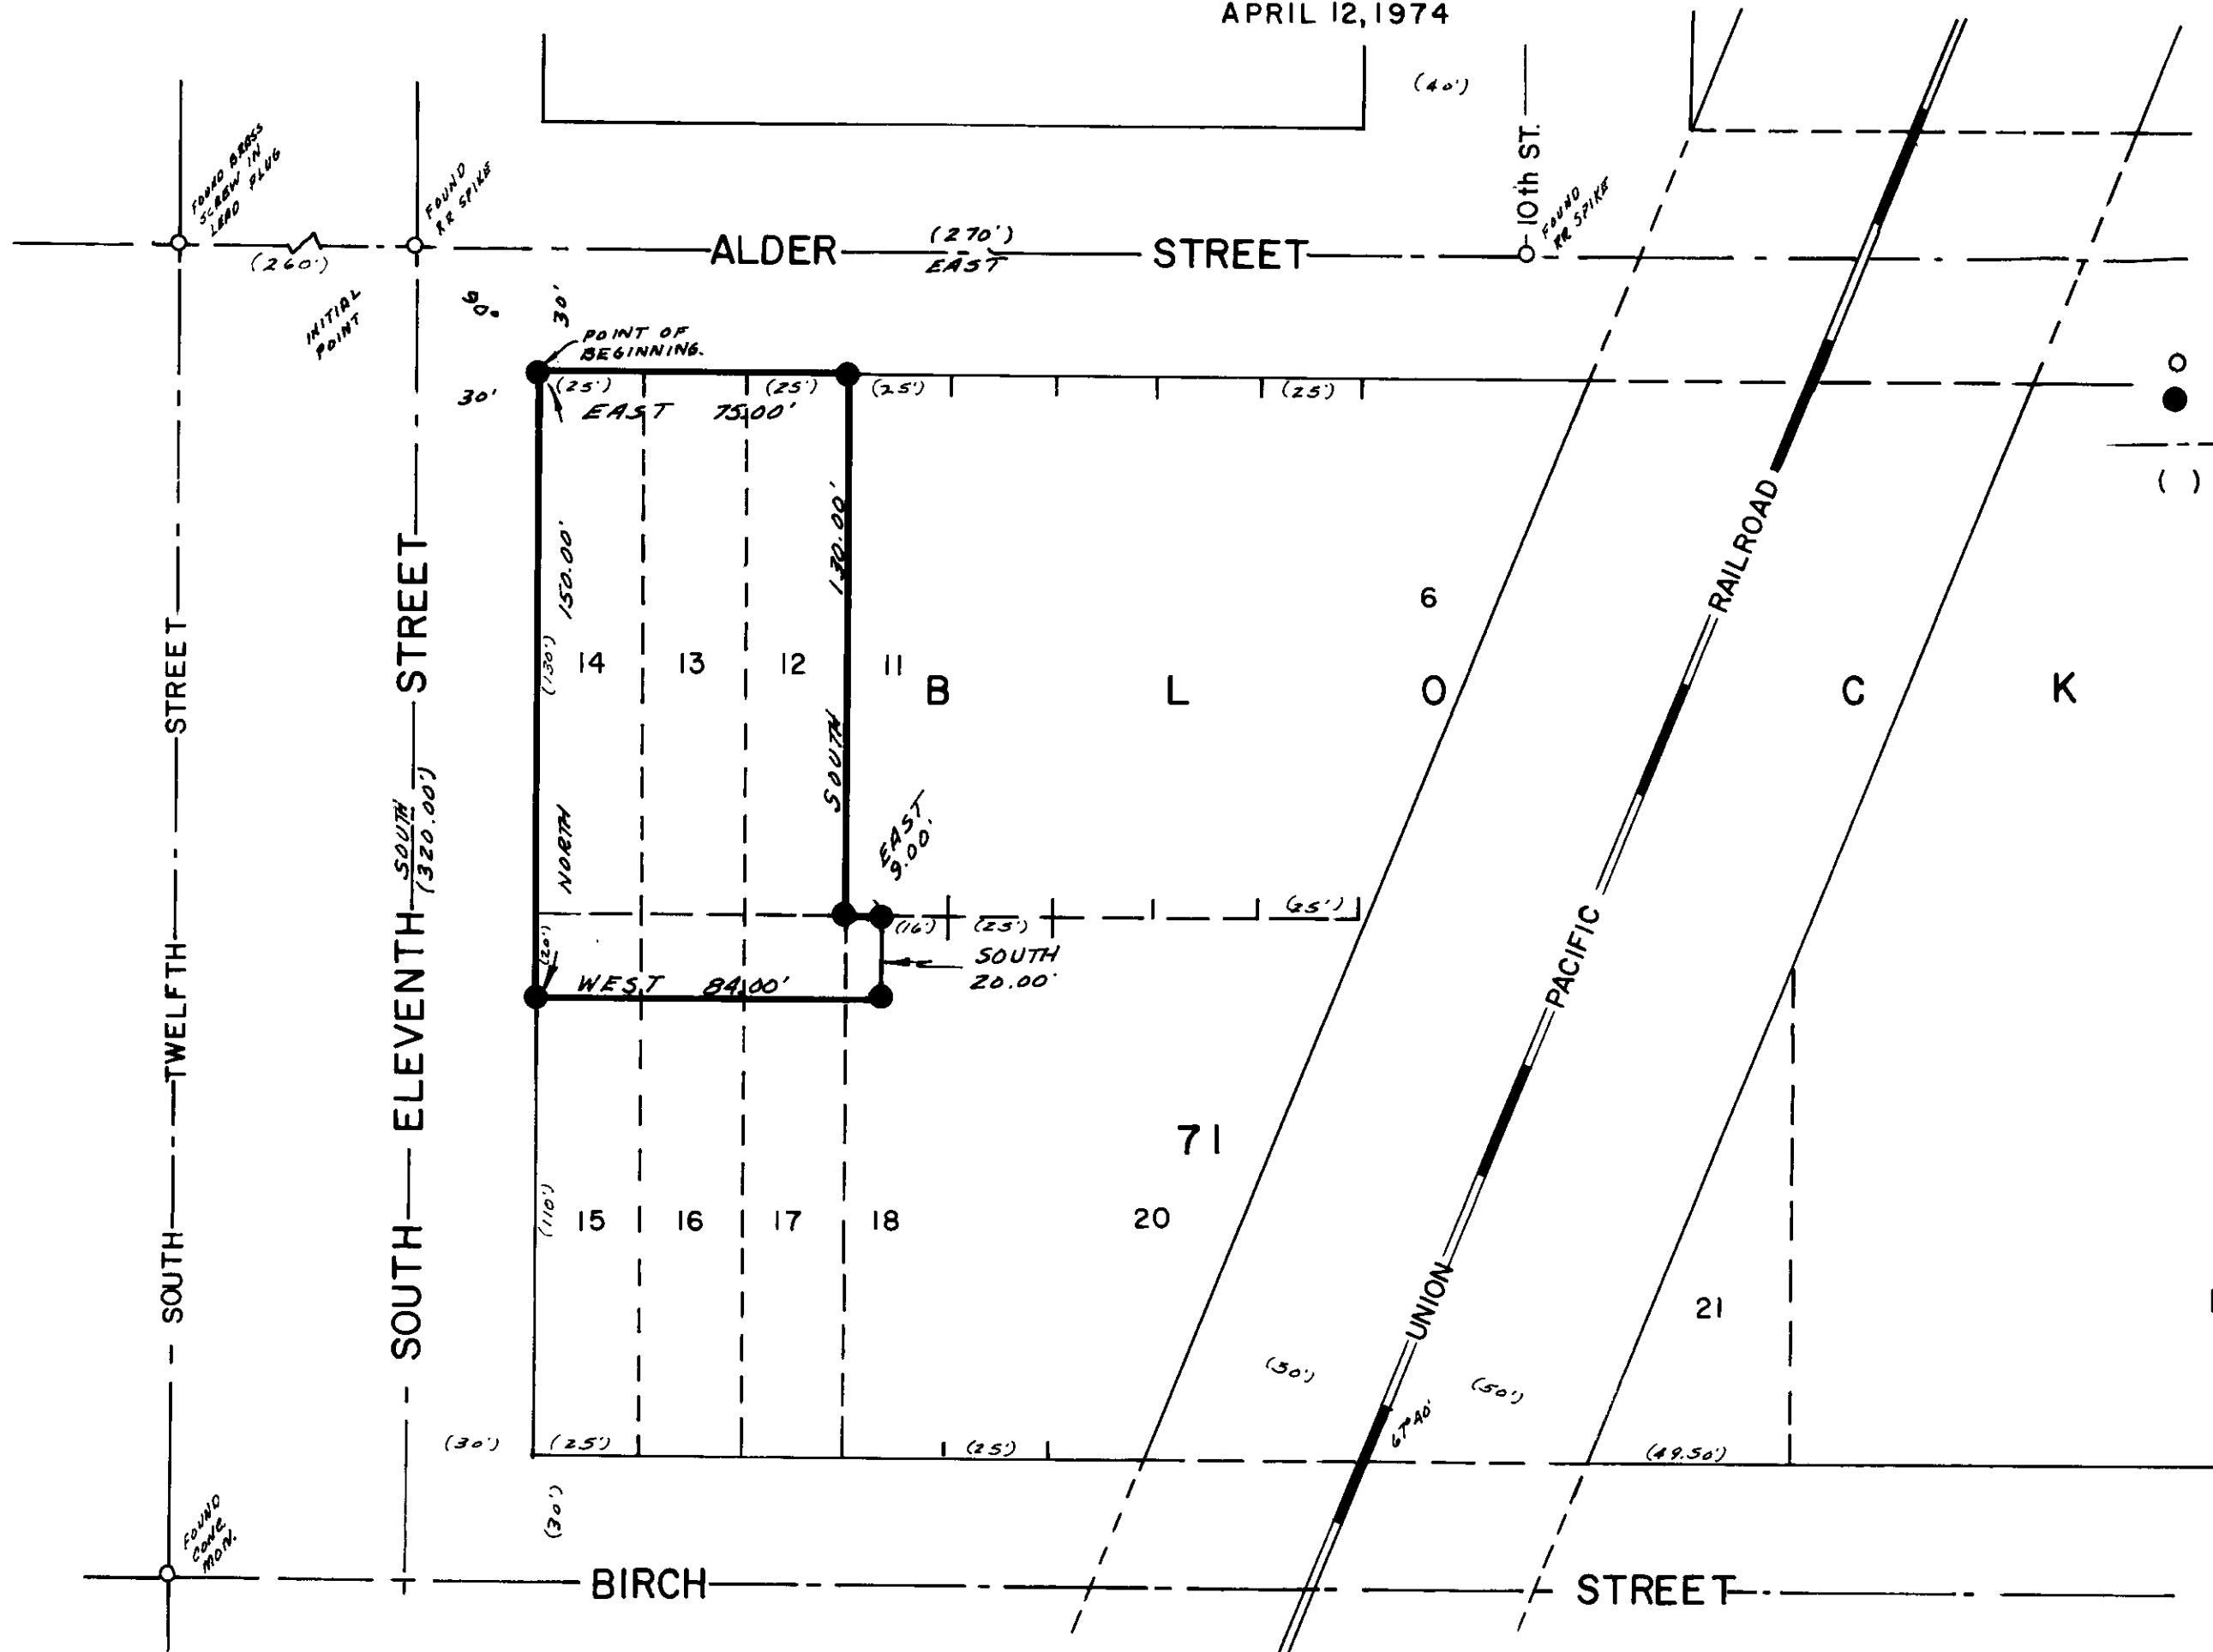

LEGEND
SCALE 1" = 40'
○ Found monuments as indicated.
● Set 5/8" X 30" steel rods.
--- Center line of streets.
() Data of record.

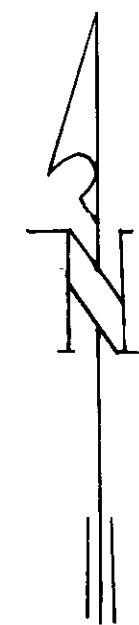

BASIS OF BEARINGS
BASED ON \angle OF
ALDER STREET
BEING EAST

James L. Deely