PLAT
of survey for

RUDDY EVANS

ROUTE 1, BOX 104
COVE, OREGON
FEBRUARY 18, 1973
LOCATED IN THE W1/2 SW1/4 OF SECTION 14, T3S R4OE W.M.

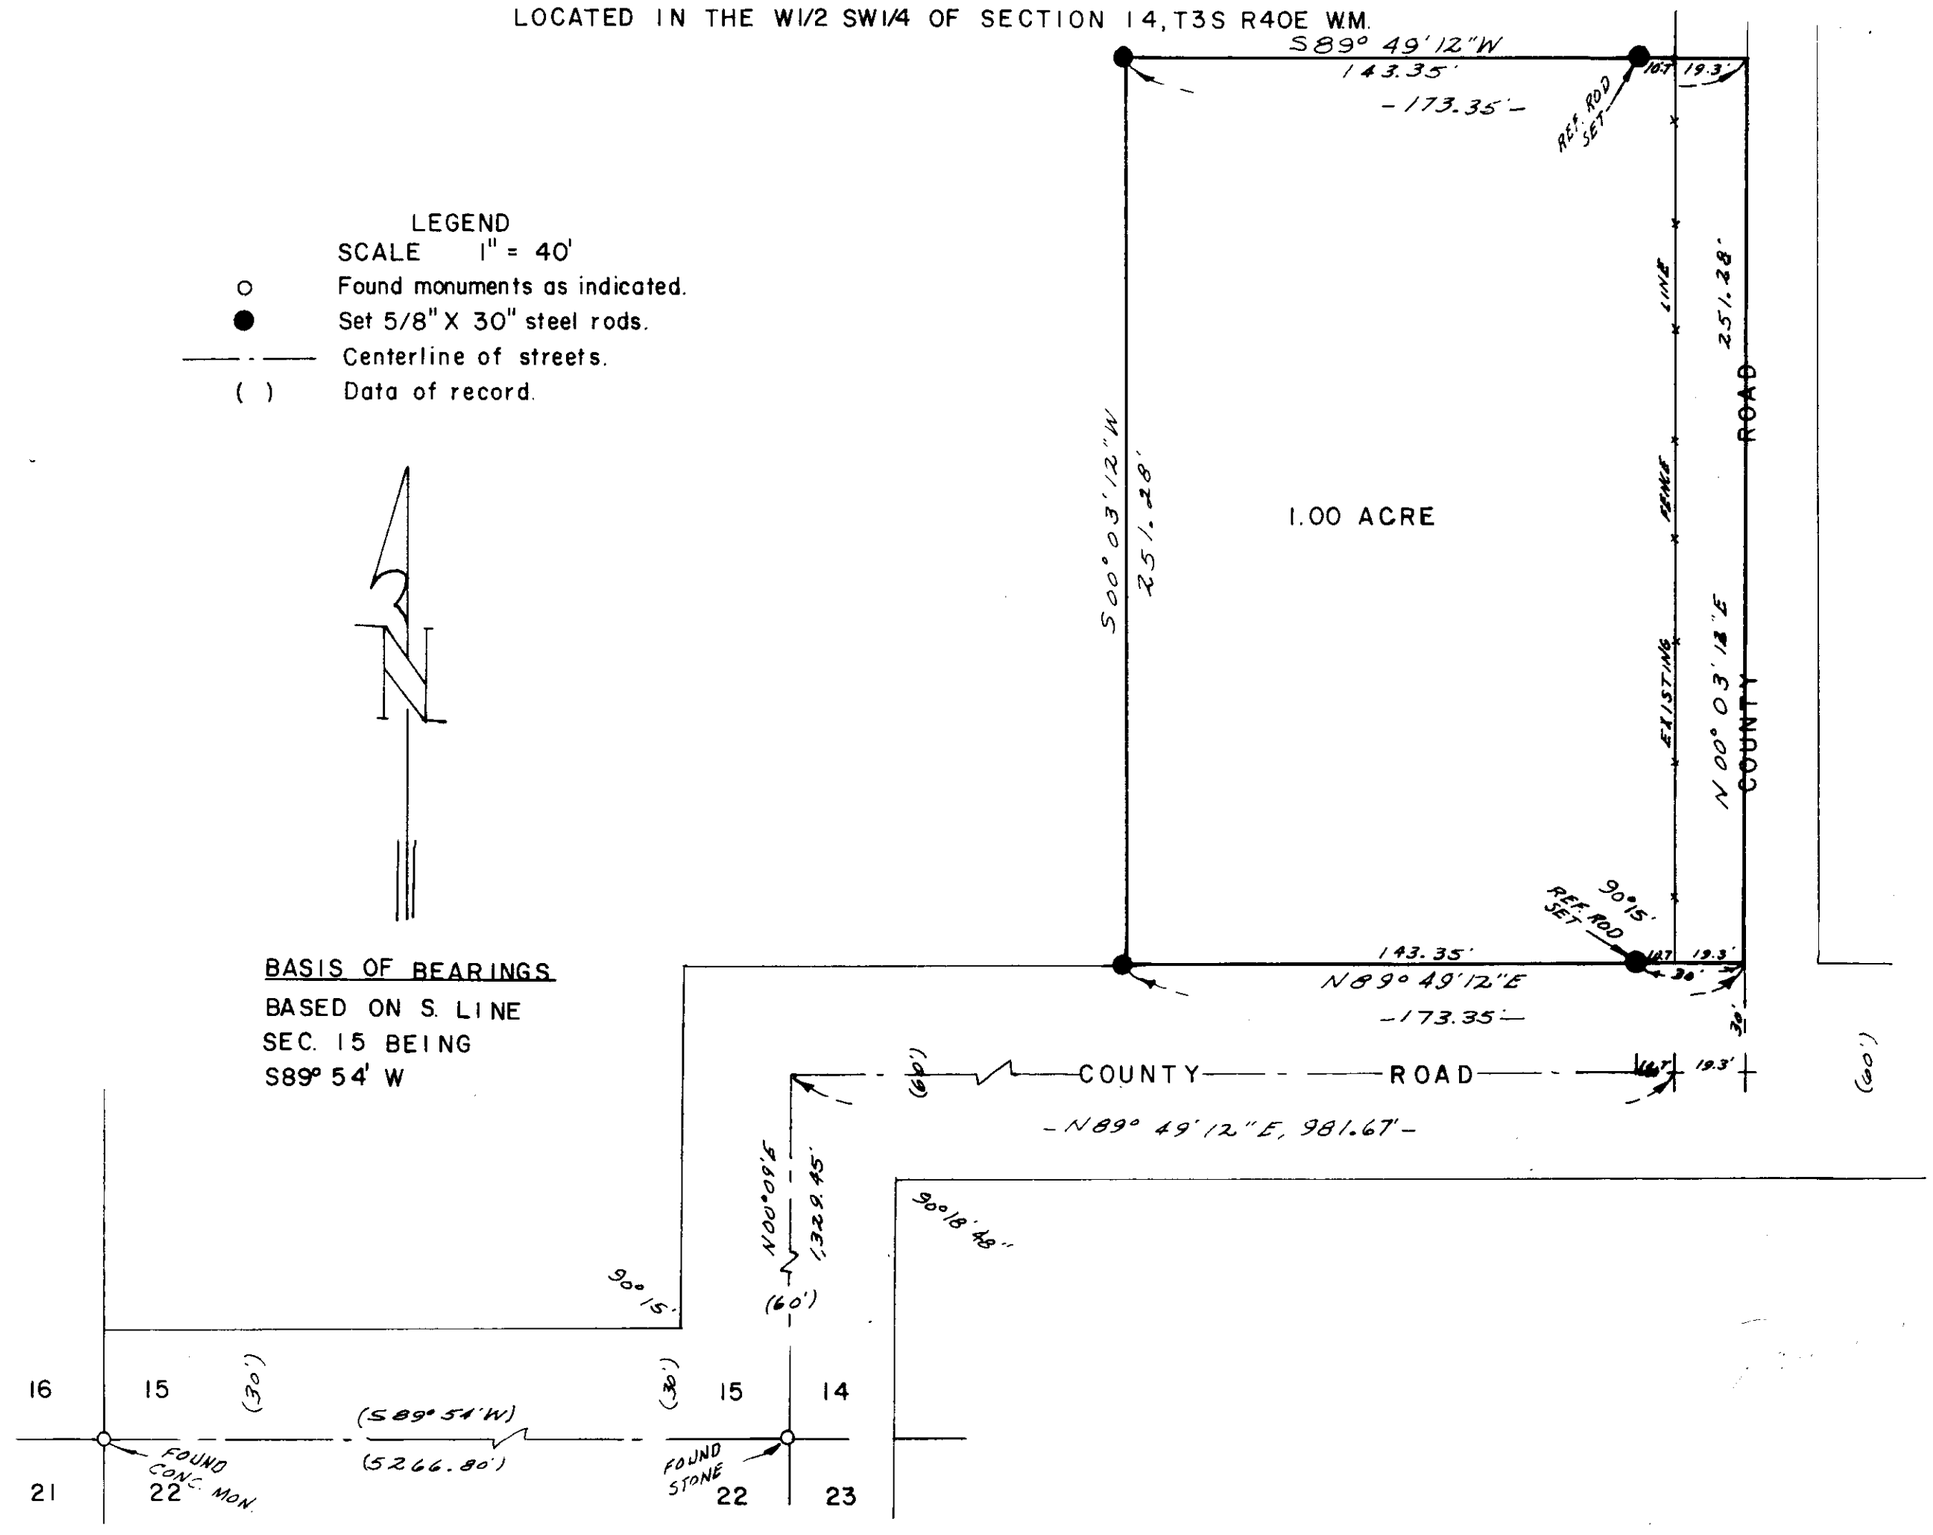

87-79