PLAT
of survey for

WAYNE GOODERHAM

506 SPRING AVENUE
LA GRANDE, OREGON
A PORTION OF LOTS 11 & 12, BLOCK 4 ROMIG'S ADDITION
TO LA GRANDE

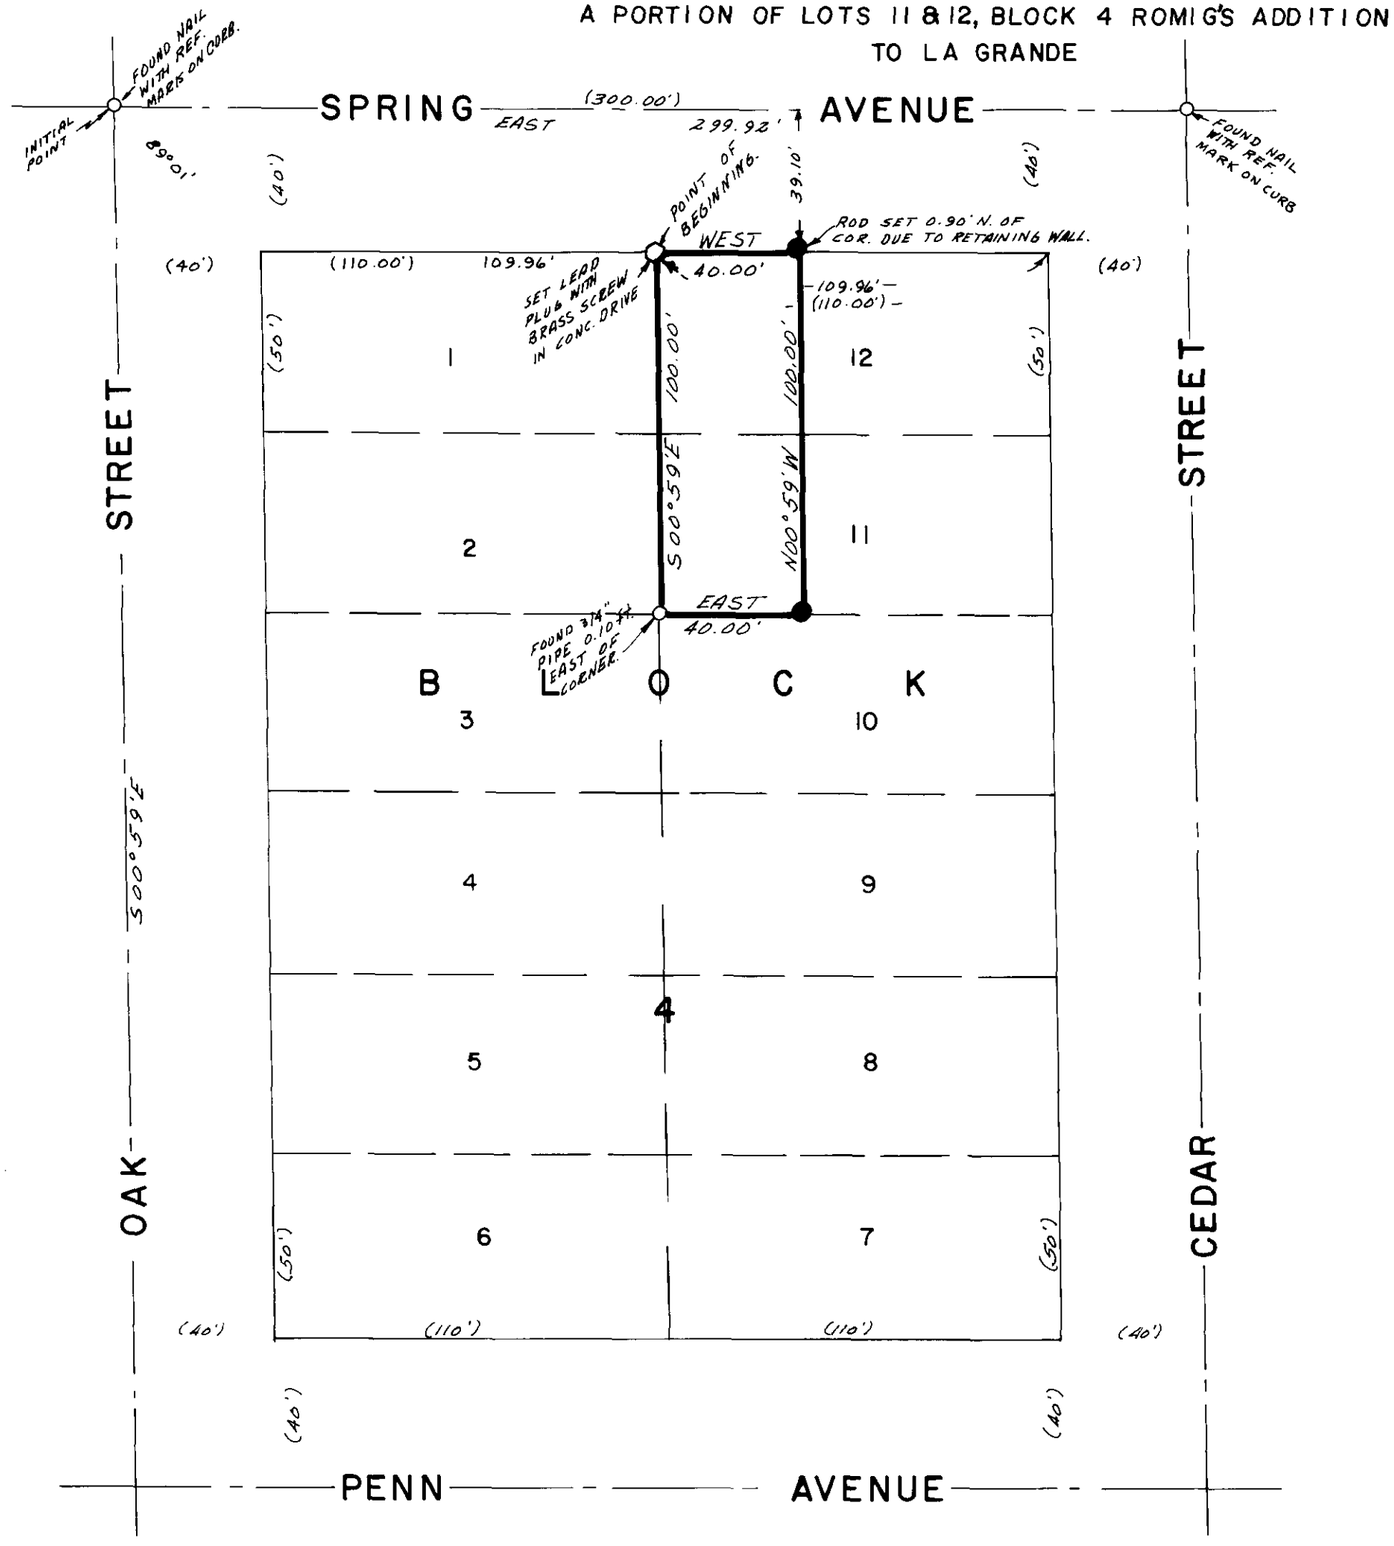

LEGEND

SCALE 1" = 40'

- ○ Found monuments as indicated.
- ● Set 5/8" X 30" steel rods.
- —— Center line of streets.
- ( ) Data of record.
- ⬡ Lead plug & brass screw.

June 10, 1974

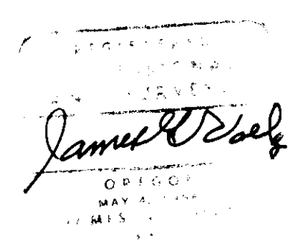

BASIS OF BEARINGS

BASED ON ℄ OF
SPRING AVENUE
BEING EAST

52-74