JN 209

SKETCH - MAP OF A PARCEL OF LAND LOCATED AND DESCRIBED AS BEING TAX LOT #2100, EAST ONE HALF OF LOT #1, BLOCK #6, OF GRANDY'S ADDITION TO THE CITY OF LA GRANDE, UNION COUNTY, OREGON.

Date: June 26, 1974
Scale: 1" = 100'
Bearings: True: From reference points located on Third Street at intersections with Adams Avenue and at Washington.
Distances: From reference points located at lot corners in lots No.'s 2,3, and 4, in block #7 of said addition.

Real Property recorded: Milburn J. and Judith D. Holmes

Prepared by: Eastern Oregon Land Surveys
La Grande, Oregon

Points Monumented: Set ½" pipes at all lot corners. The southeast corner of block #6 set, from which an iron pipe bears north, 0.67', and a flasher in a power pole bears S. 45° W., 11.07'.

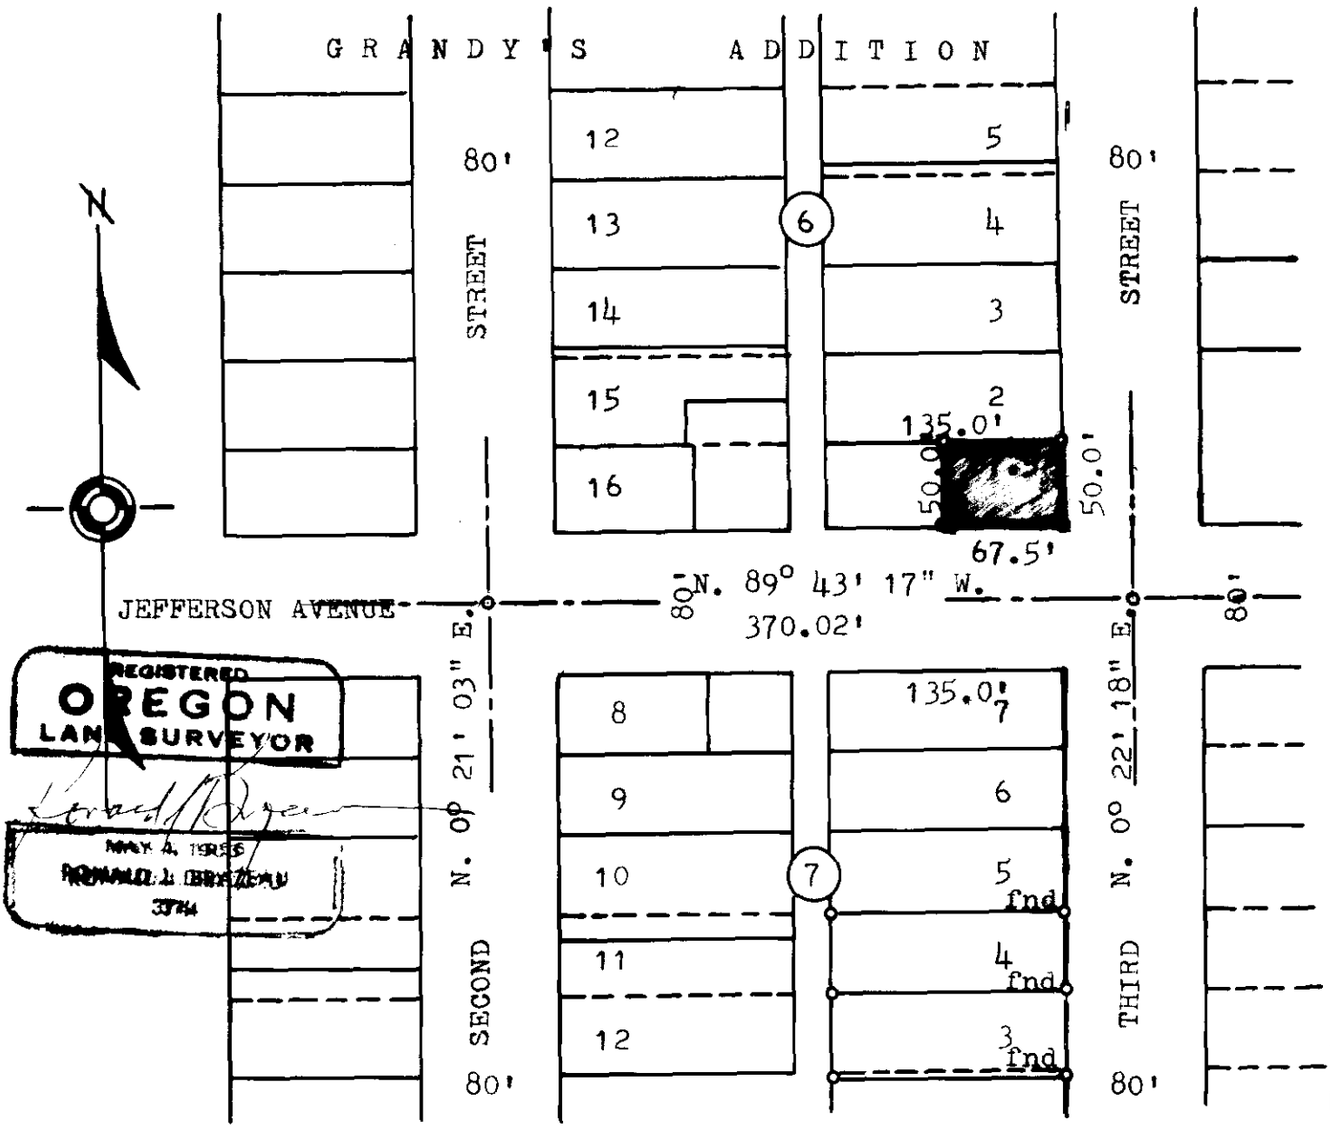

58-74