



VICINITY MAP - UPPER PERRY

E. 1/2 SEC. 34 T. 25. R. 37 E.

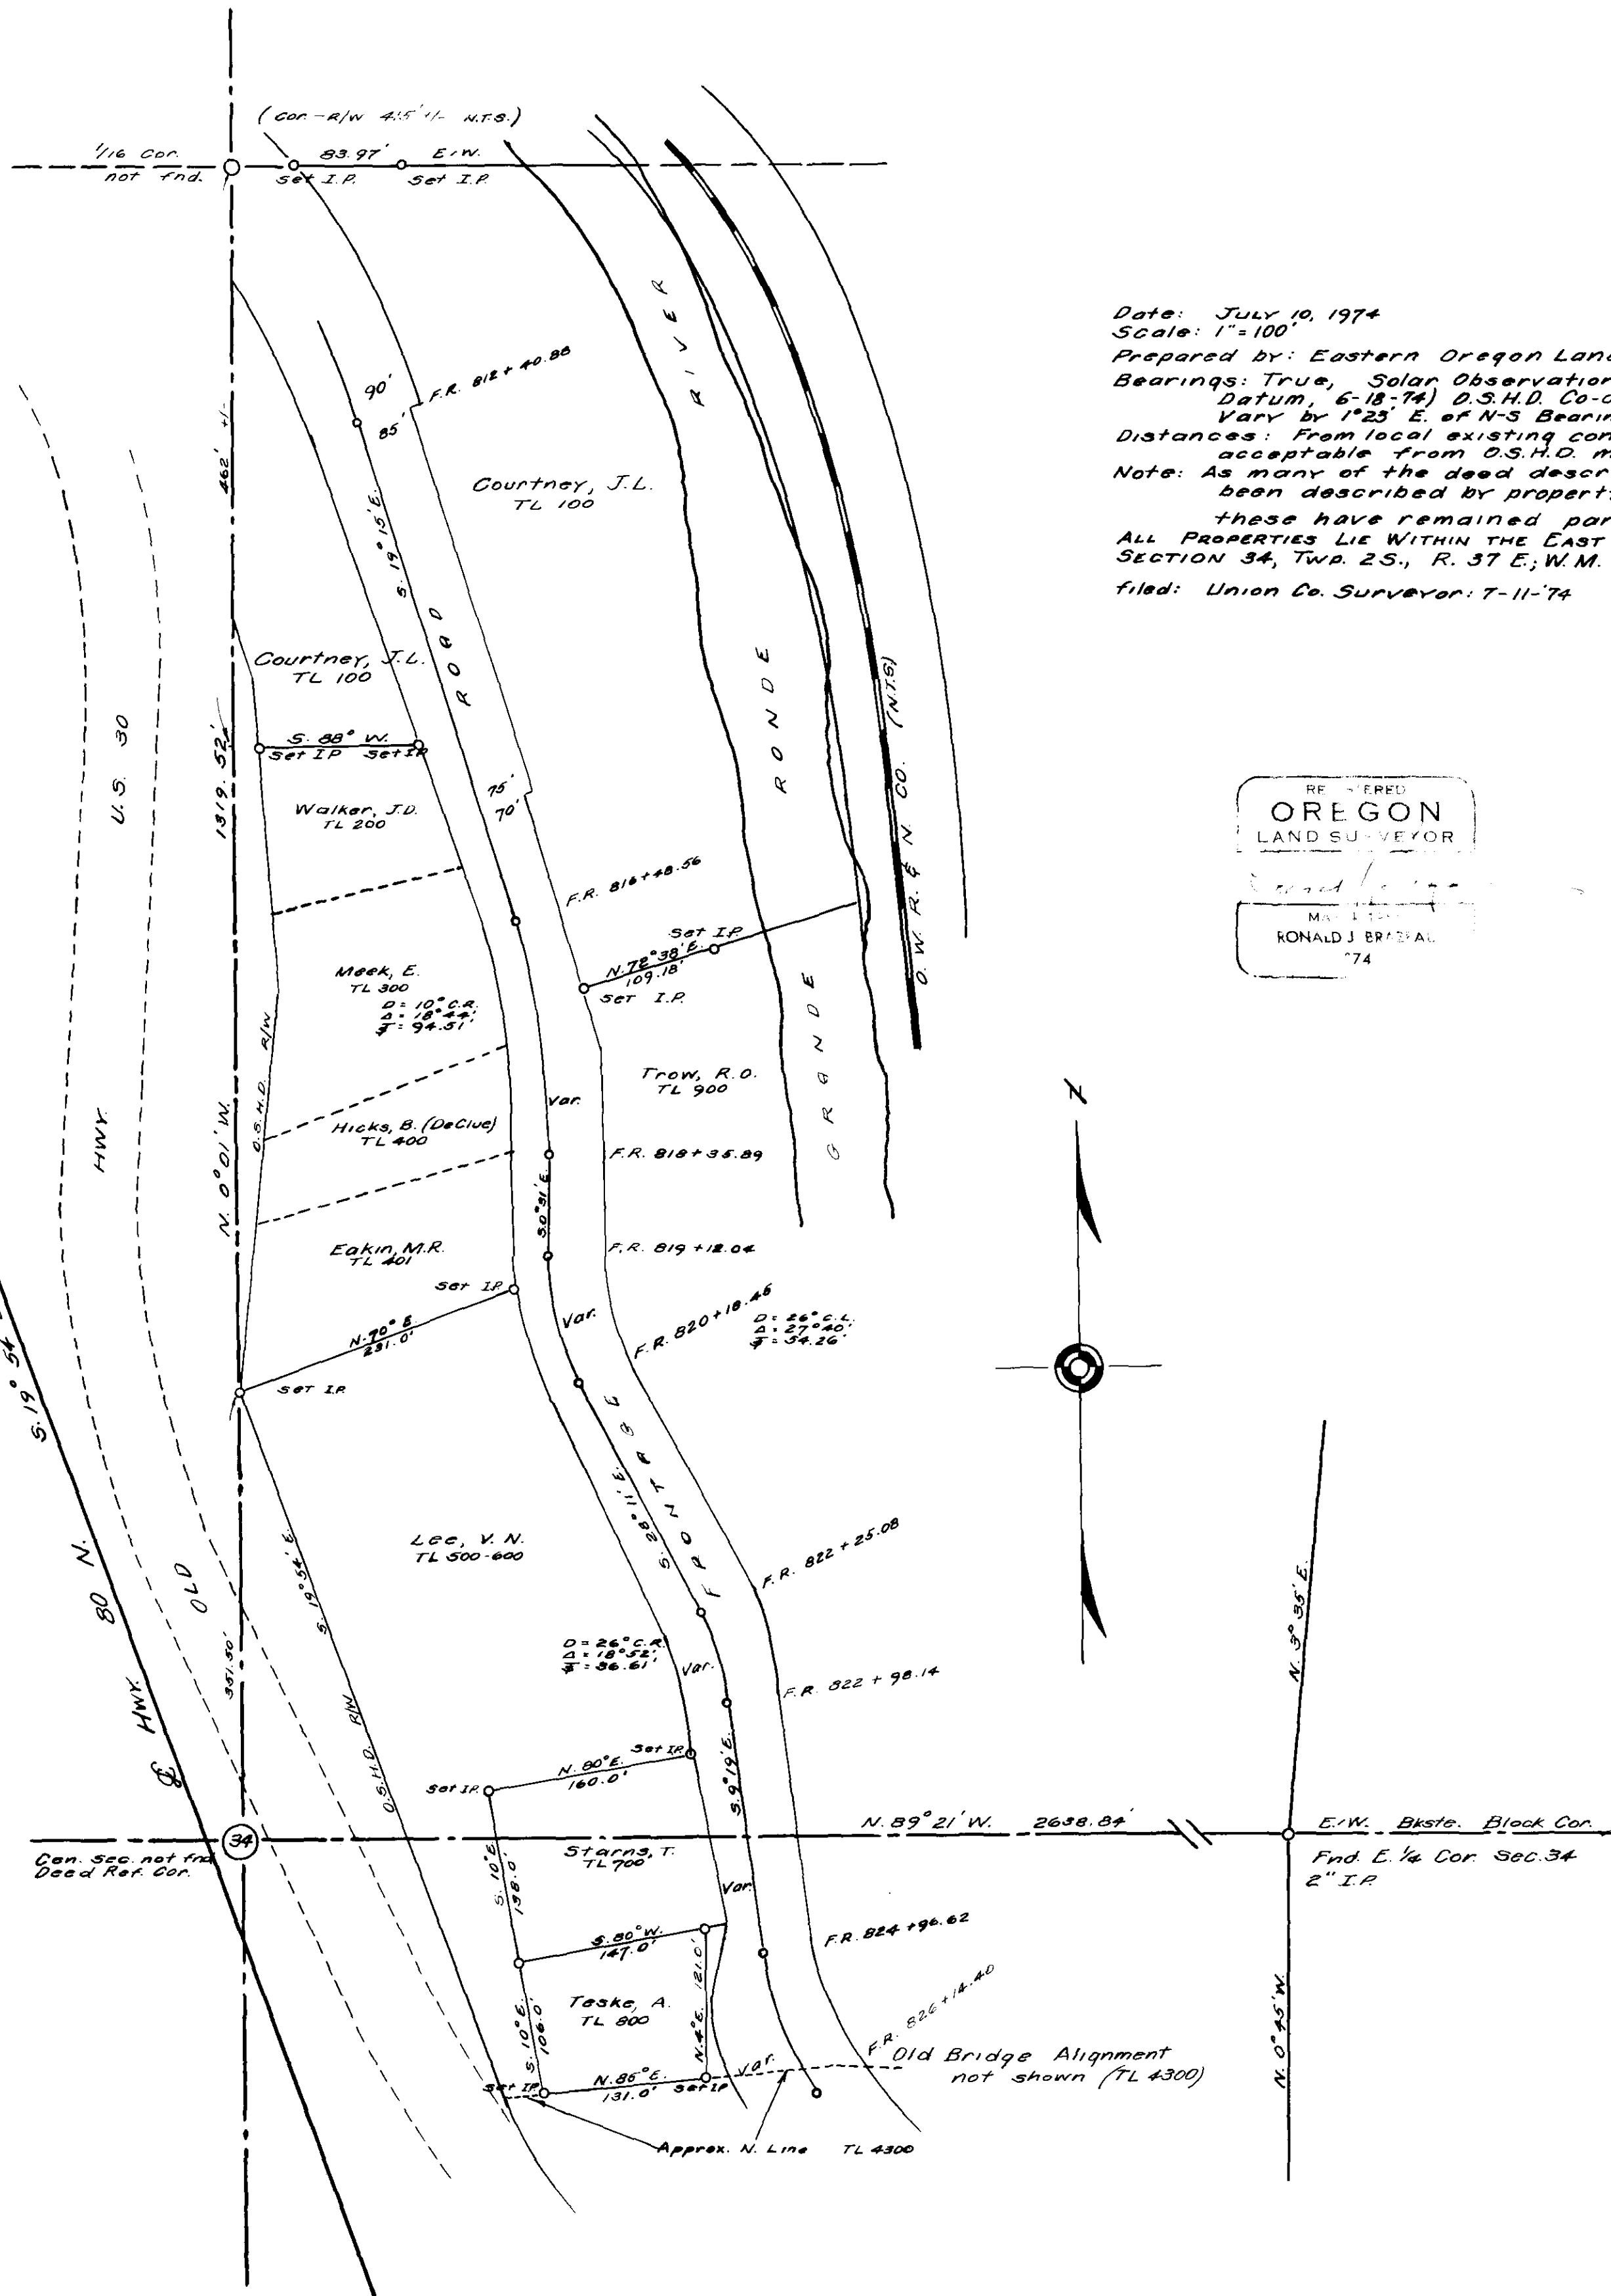

Date: July 10, 1974
 Scale: 1" = 100'
 Prepared by: Eastern Oregon Land Surveys
 Bearings: True, Solar Observation (Sol. Eph. Datum, 6-18-74) O.S.H.D. Co-ordinate data Vary by 1° 23' E. of N-S Bearings.
 Distances: From local existing conditions as acceptable from O.S.H.D. monuments.
 Note: As many of the deed descriptions have been described by property fences, these have remained paramount.
 ALL PROPERTIES LIE WITHIN THE EAST HALF OF SECTION 34, Twp. 25., R. 37 E.; W.M.
 filed: Union Co. Surveyor: 7-11-74

REGISTERED
OREGON
 LAND SURVEYOR
 RONALD J. BRADY
 1974

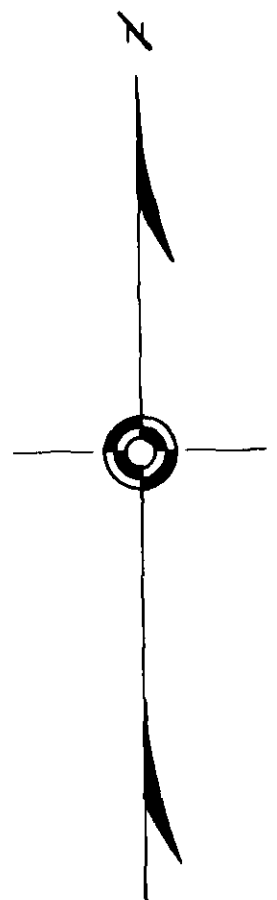

59-74