

T.2 S

R.38 E.

W. M.
SECTION 34

GRANDE RONDE RIVER

LEGEND

MEASURED DISTANCE 216.00
RECORDED DISTANCE & BEARING ()

POINT OF BEGINNING
FOUND 1" IRON PIPE
(SET BY EASTERN OREGON
LAND SURVEYS APRIL 4, 1974)
(30' OFFSET)

SET 5/8" X 30" IRON PIN

(N 75°22'19"E 1484.81')
(N 76°12'26"E 1482.76')


FOUND IRON PIN
W/B.G.F. CAP

(N 0°05'08"W) 200.35'
(N 0°05'08"W) 300.00'
FOUND 1" IRON PIPE
(SET BY EASTERN
OREGON LAND SURVEYS
APRIL 4, 1974)

NOTE:

BASIS OF BEARING
WEST LINE OF SURVEY
DONE BY EASTERN OREGON
LAND SURVEYS APRIL 4, 1974

O.W.R.R. & N. R/W

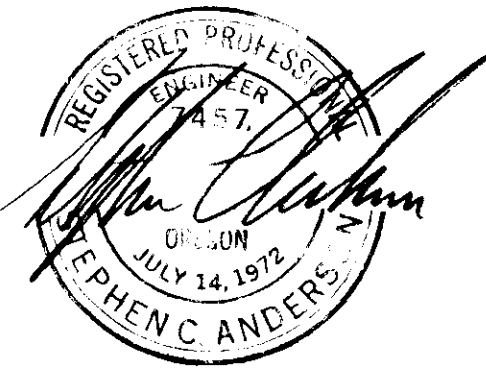

SCALE: 1" = 200'

R. D. MAC INC. SURVEY
STEPHEN C. ANDERSON
AND ASSOCIATES
LA GRANDE, OREGON

60-74

34
3