



PLAT
of survey for
SCOTT FURST
SEPTEMBER 5, 1974
LOCATED IN S 1/2 OF SECTION 15, T2S R36E WM.

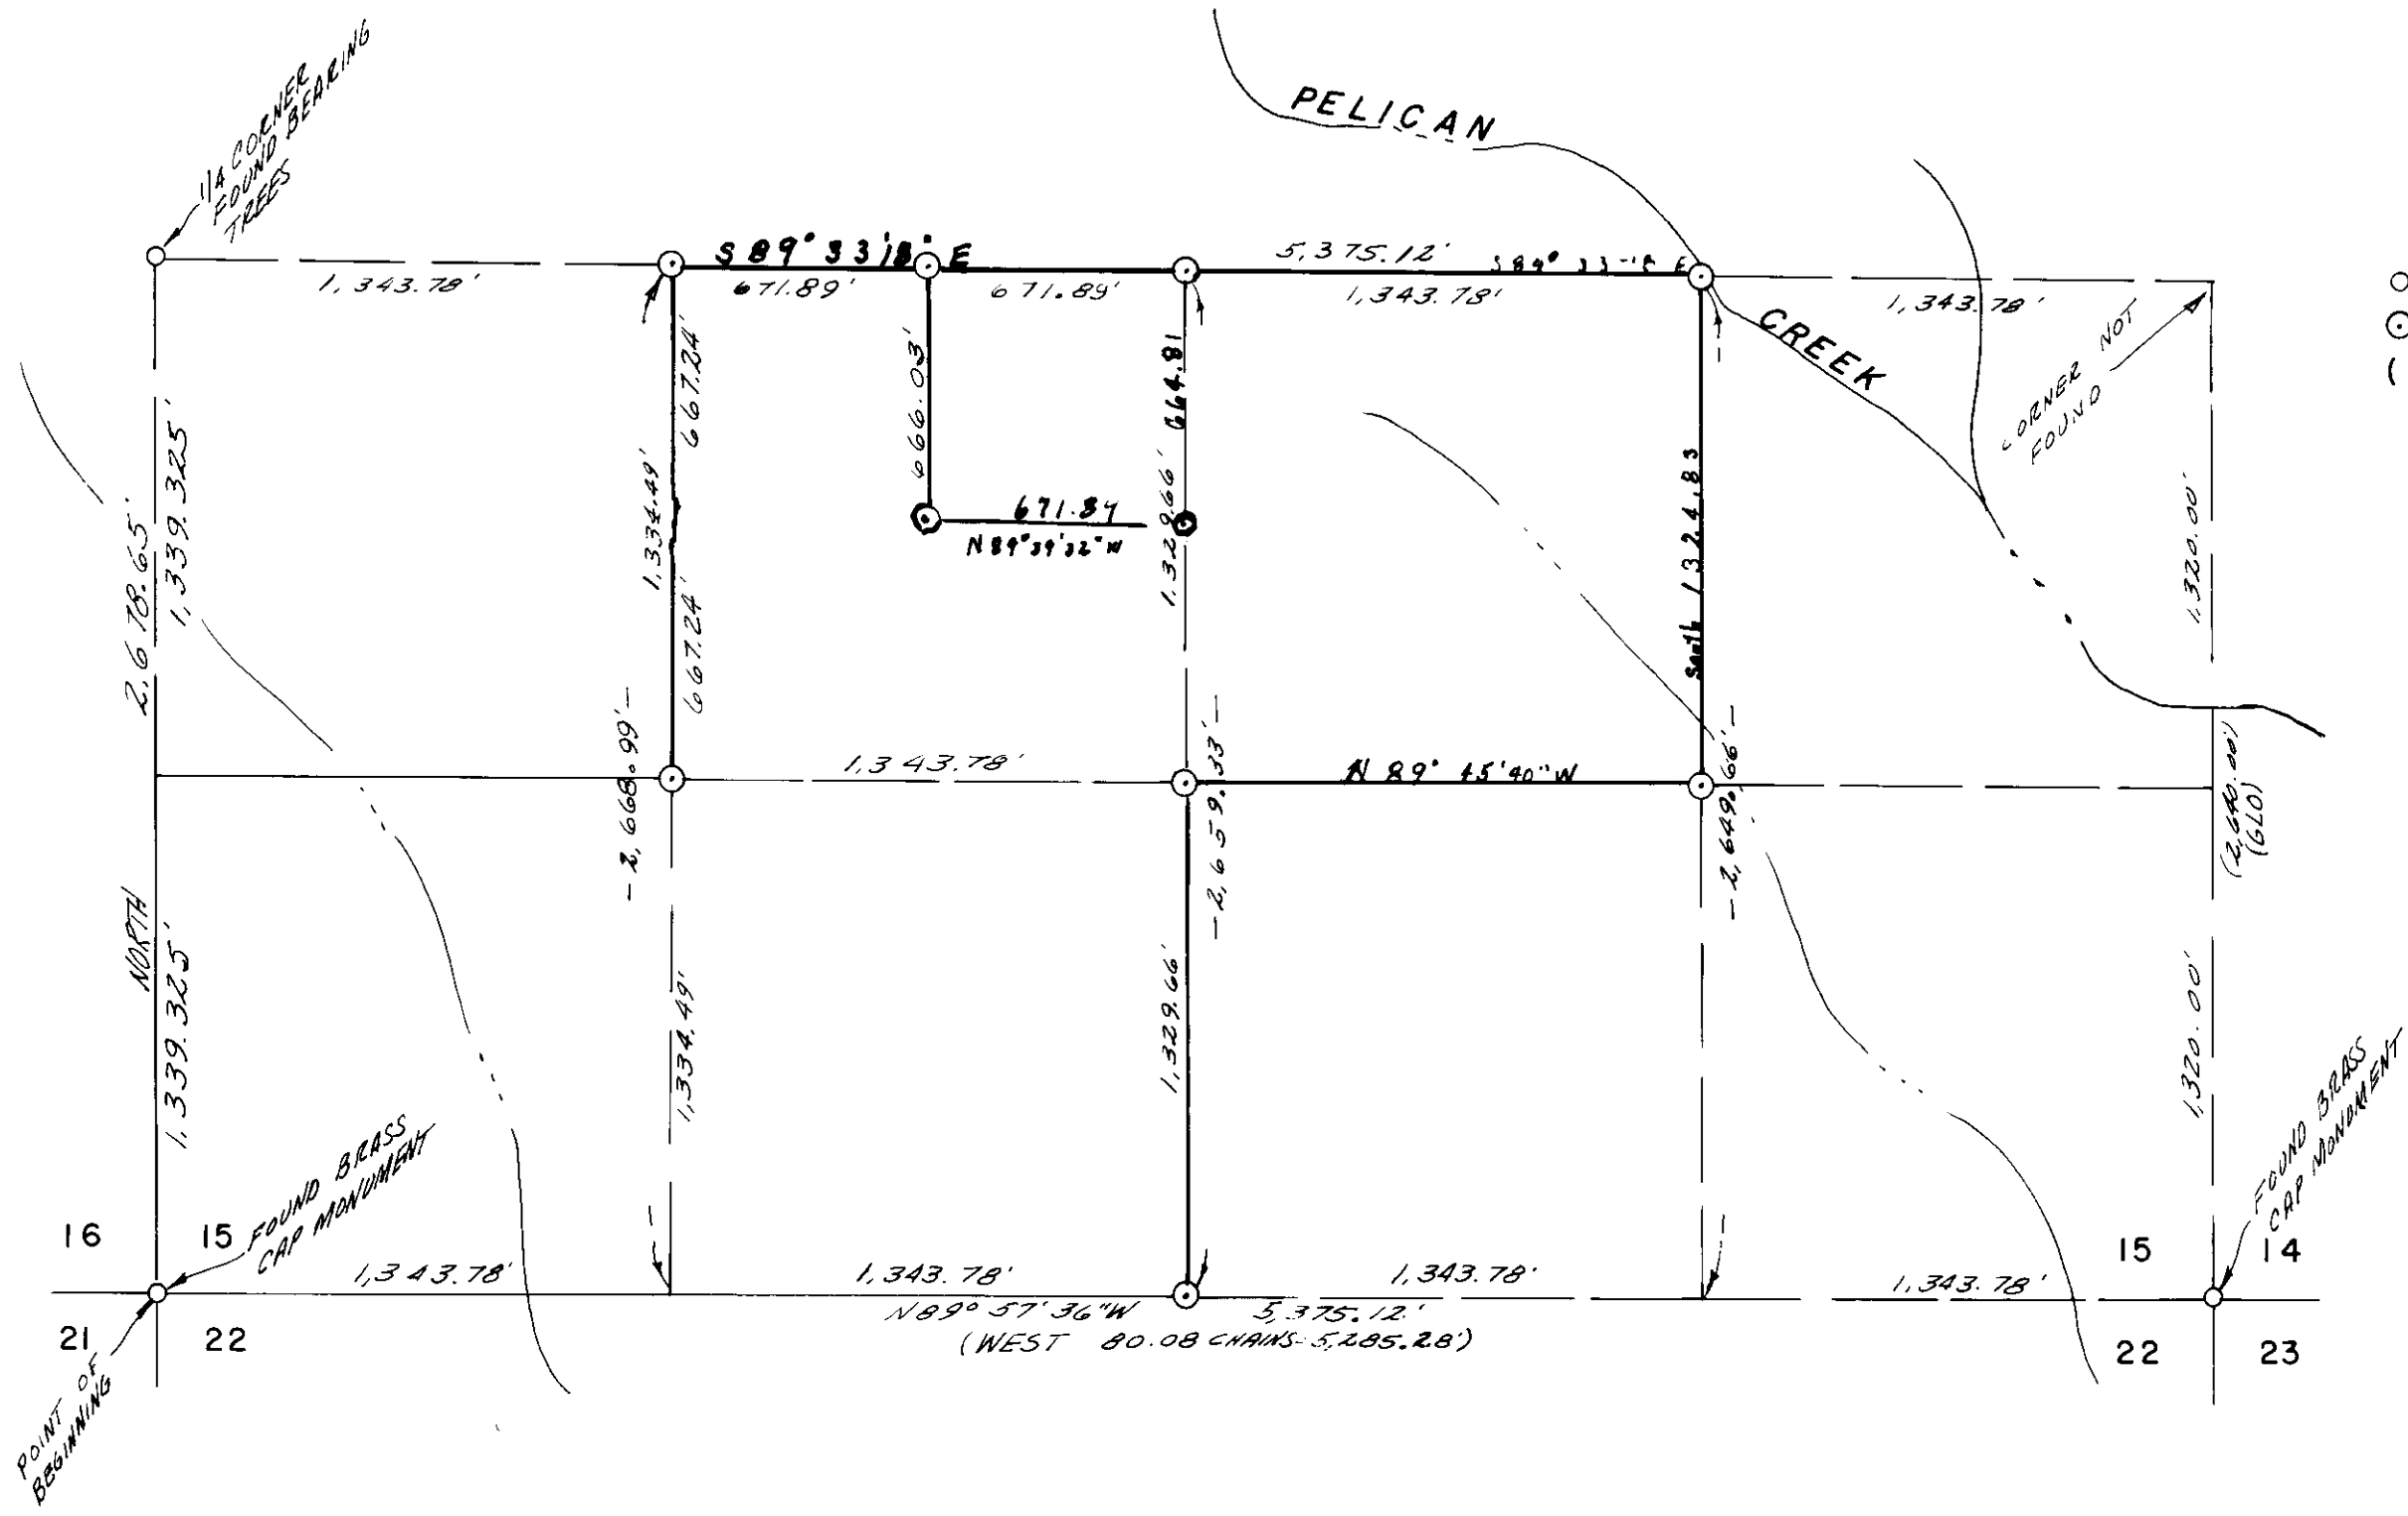

LEGEND
SCALE 1" = 50'
○ Found monuments as indicated.
⊙ Set 5/8" X 30" steel rods.
() Data of record.

REGISTERED
PROFESSIONAL
LAND SURVEYOR
James G. Voelz
OREGON
MAY 2, 1956
JAMES G. VOELZ
381

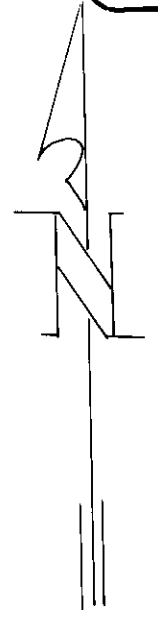

BASIS OF BEARINGS
BASED ON WEST
LINE SECTION 15
BEING NORTH.