


PLAT
of survey for
HERMAN BOUCHER
408 FIRST STREET
LA GRANDE, OREGON
LOCATED IN LOTS 5,6&7 OF BLOCK 15 OF ARNOLD & DRAYS ADDITION TO LA GRANDE, OREGON

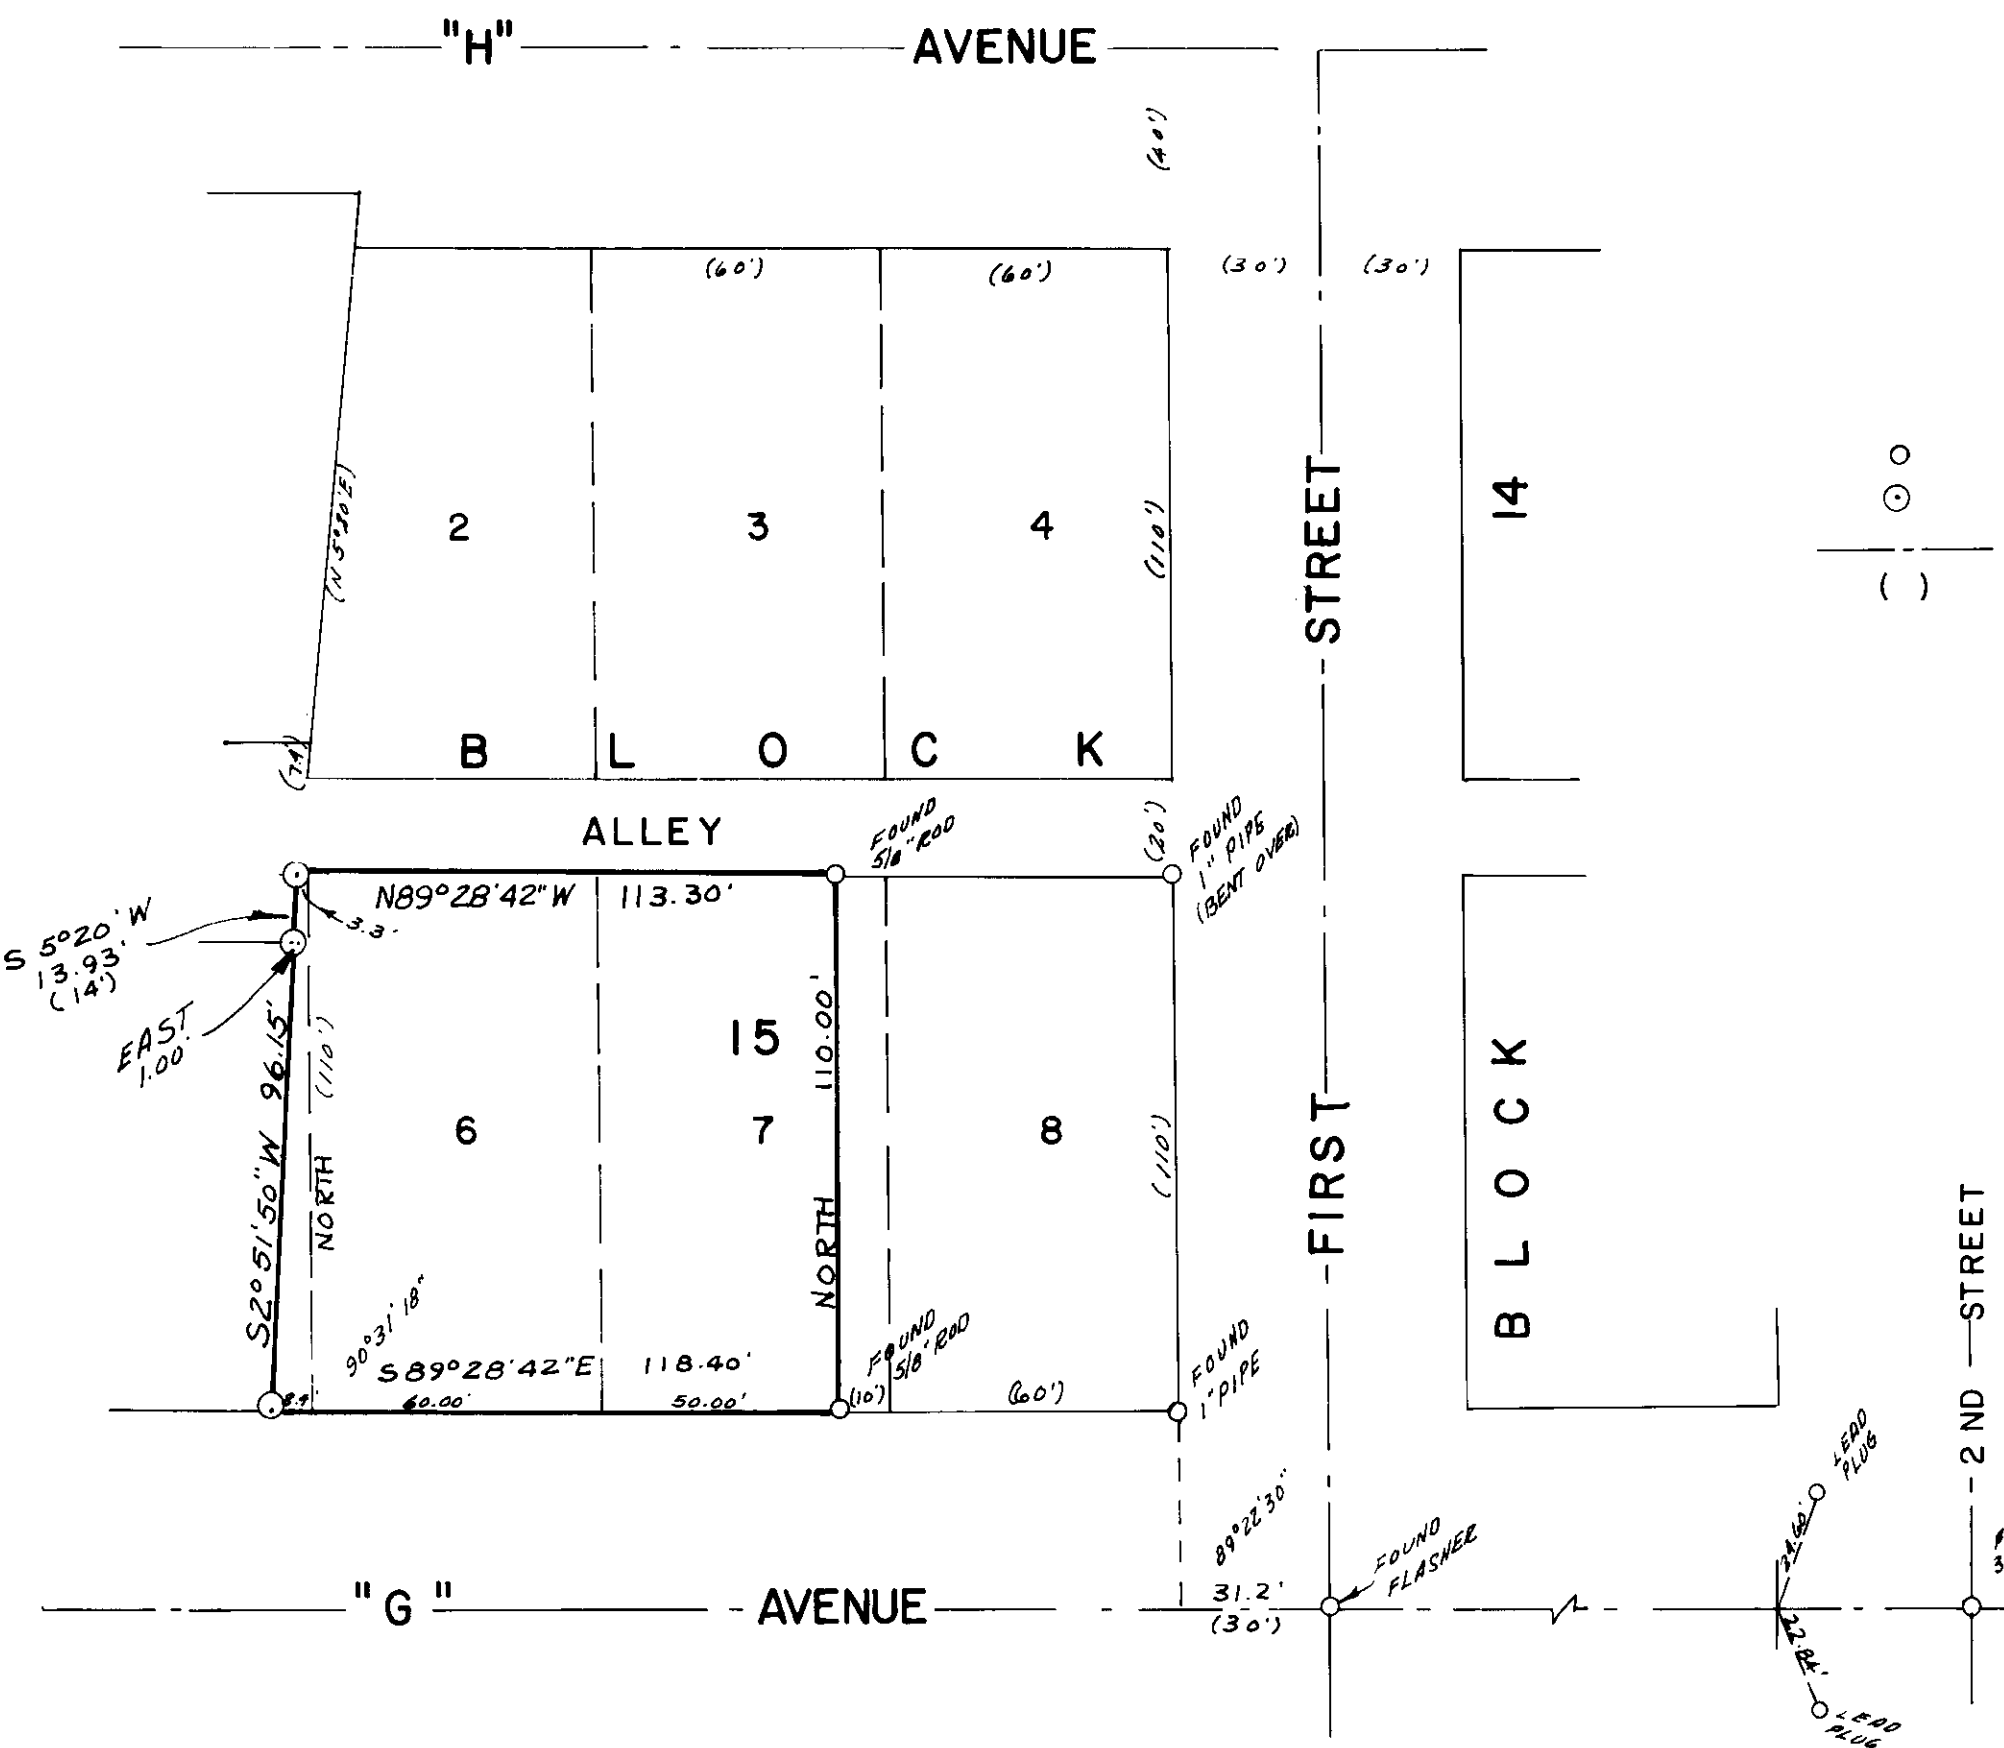

BASIS OF BEARINGS
BASED ON W LINE
LOT 6 BLK 15
BEING NORTH

LEGEND
SCALE 1" = 40'
○ Found monuments as indicated.
⊙ Set 5/8" X 30" steel rods.
--- Center line of streets.
() Data of record.

REGISTERED
PROFESSIONAL
LAND SURVEYOR
James G. Voelz
OREGON
MAY 4, 1956
JAMES G. VOELZ
381