PLAT
of survey for

DARELL & CLARA A. CALHOUN

COVE, OREGON 97824
LOCATED IN LOTS 1,2,3,4 & 5 OF BLOCK "K"
OF MC DANIEL'S 2ND ADDITION TO COVE, OREGON
OCTOBER 24, 1974

Note - The existing roads & fa. lines do not agree with recorded plat. No evidence found to justify existing locations. The fa. & roads have been in present location many years. Corners established based on distances recorded on original plat.

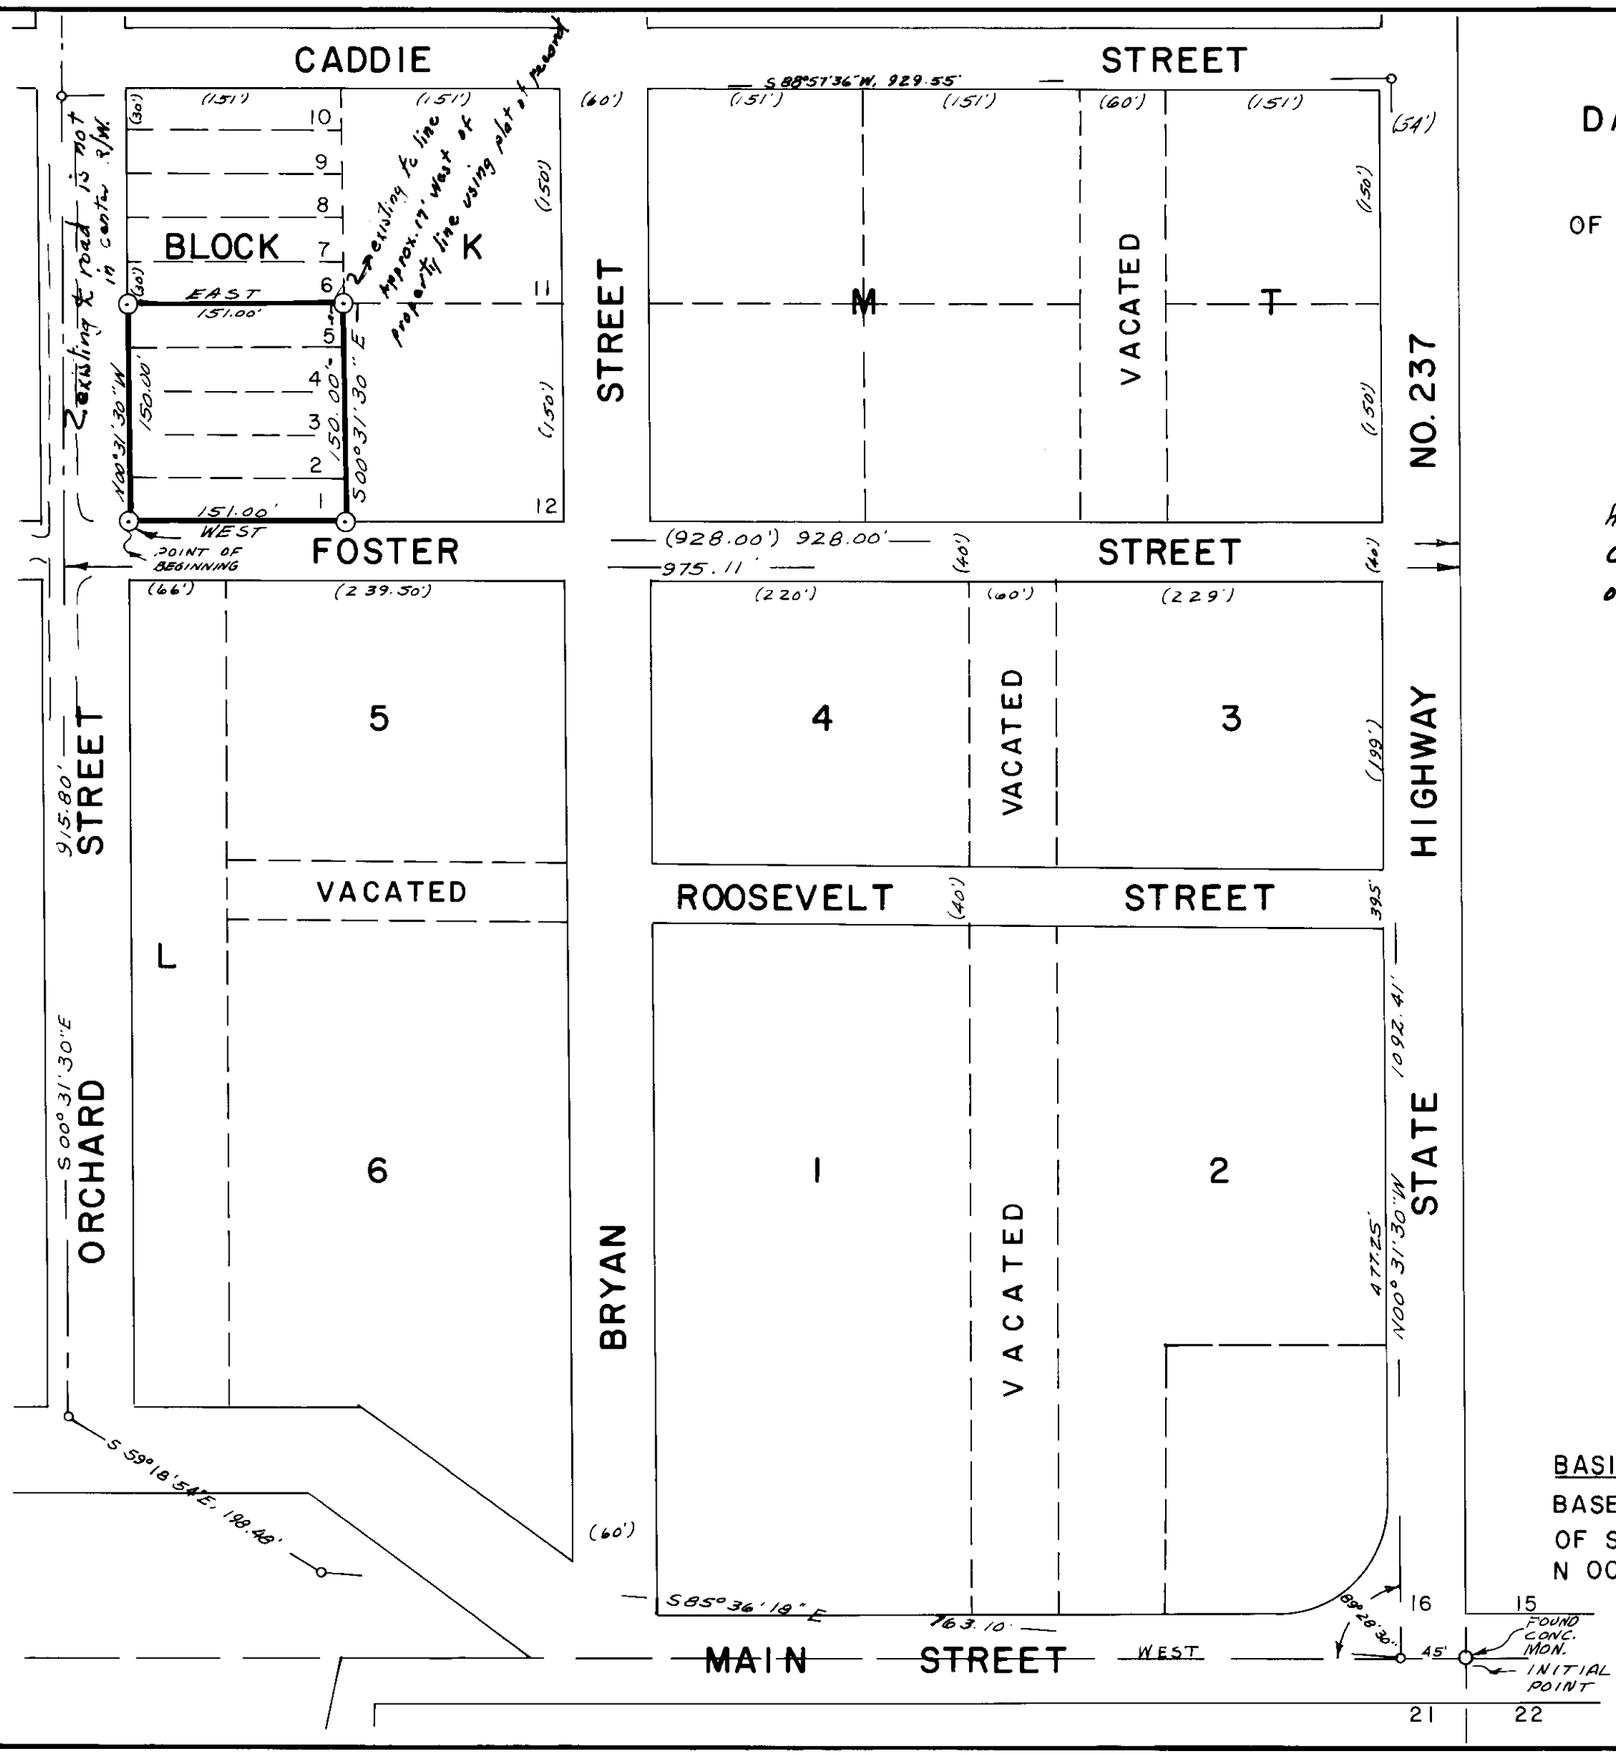

BASIS OF BEARINGS
BASED ON EAST L.I.
OF SEC 16 BEING
N 00° 31' 30" W.

LEGEND
SCALE 1" = 100'

- ○ Found monuments as indicated.
- ⊙ Set 5/8" X 30" steel rods.
- ∘ Transit stations.
- ( ) Data of record.
- —·— Center line of traveled street.

REGISTERED PROFESSIONAL LAND SURVEYOR
OREGON
MAY 4, 1956
JAMES G. VOELZ
381

94-74