PLAT
of survey for

VERN CARPENTER

1301 5th STREET
LA GRANDE, OREGON
DECEMBER 18, 1974
BEING LOT 2 BLOCK 22 OF CHAPLIN'S ADDN. TO LA GRANDE OREGON

LEGEND
SCALE 1" = 40'

- o Found monuments as indicated.
- ⊙ Set 5/8" X 30" steel rods.
- —·— Center line of streets.
- ( ) Data of record.
- o Lead plugs.

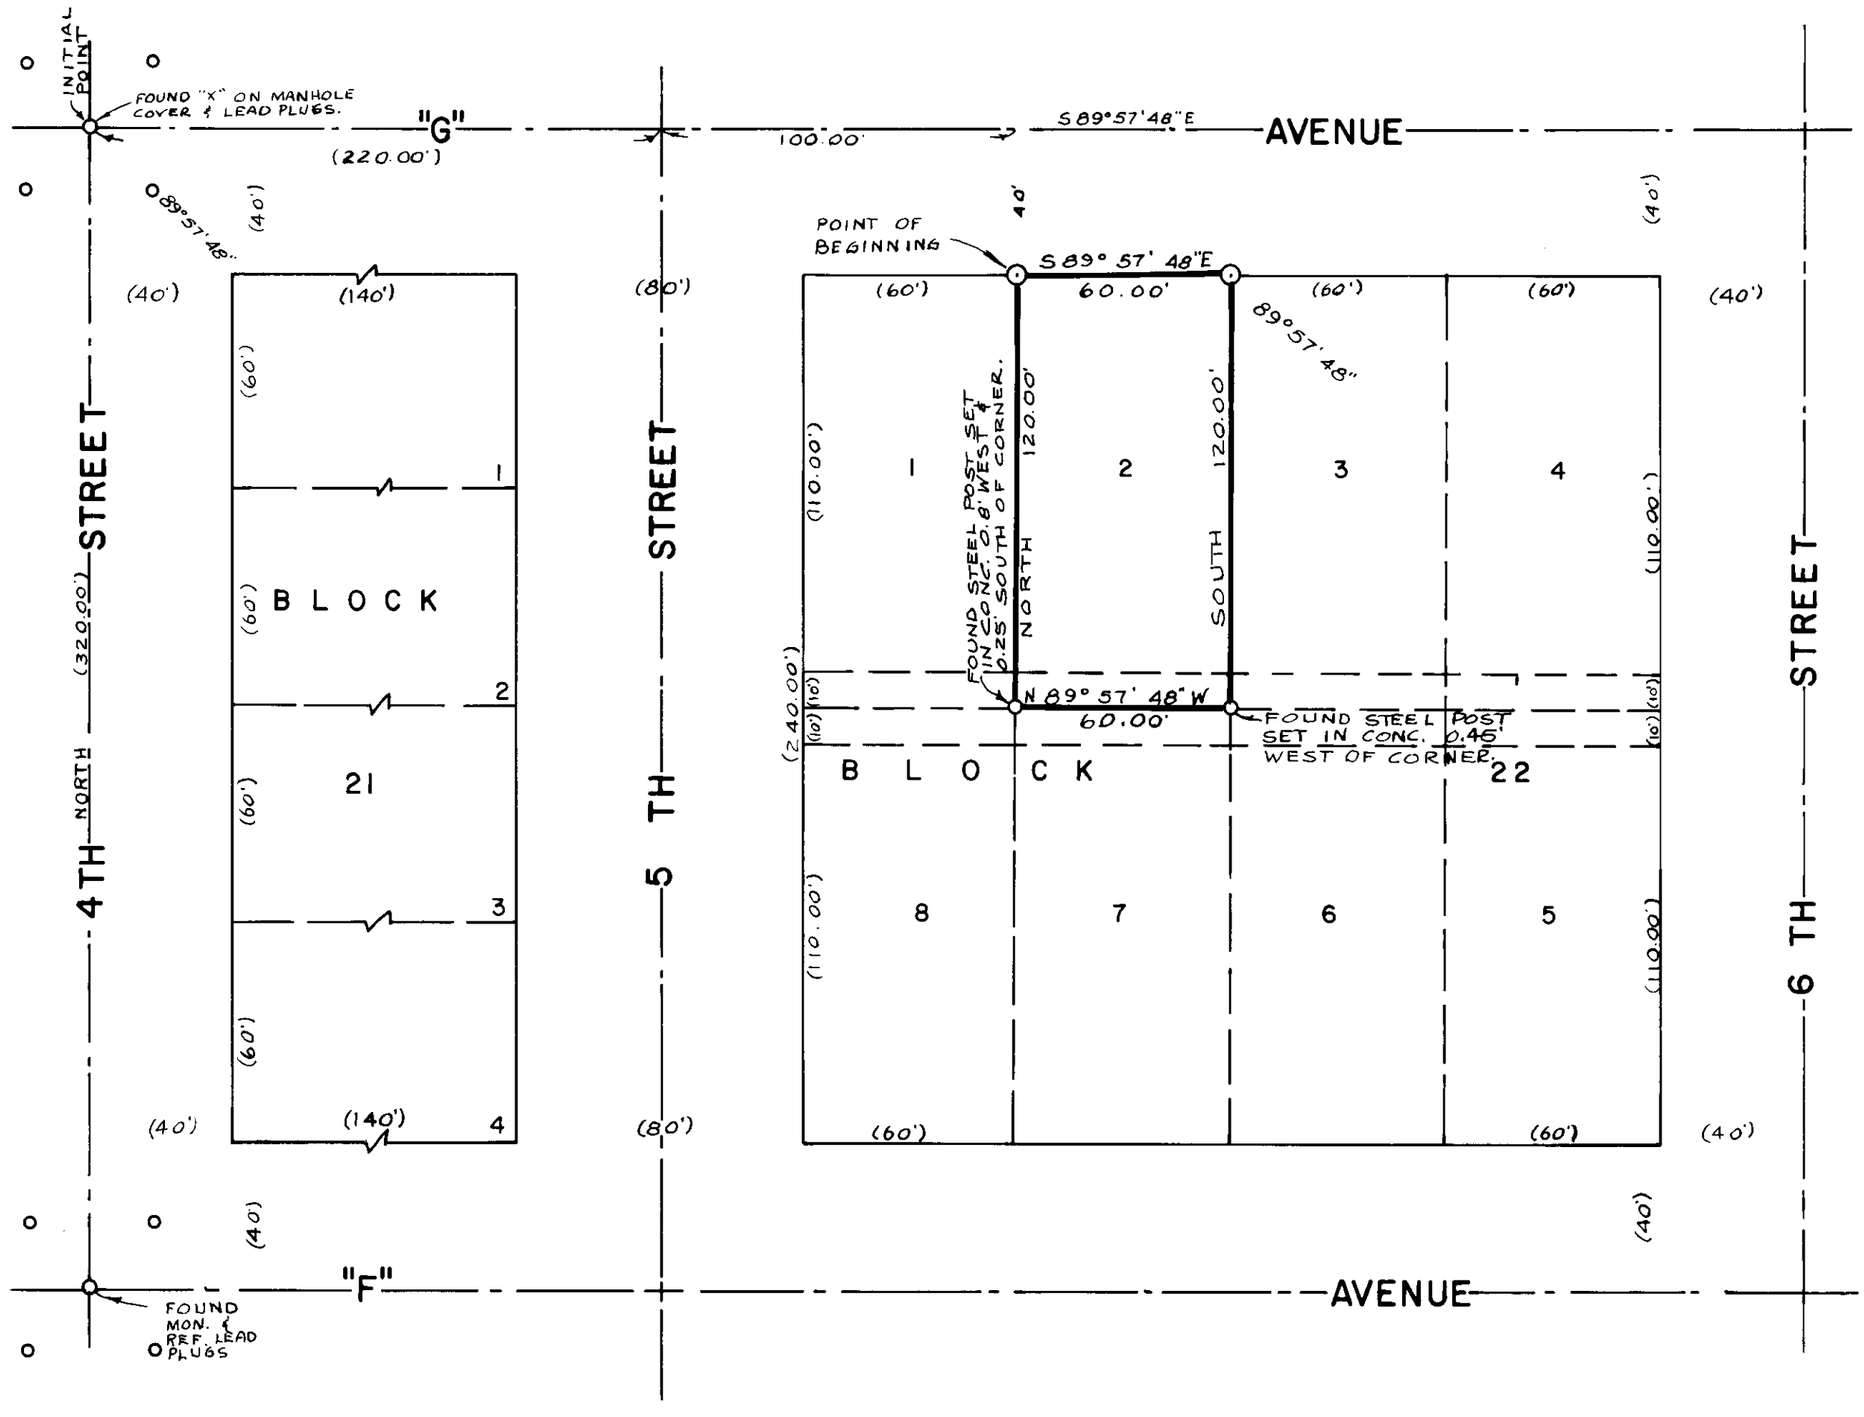

BASIS OF BEARINGS
BASED ON ℄ OF
4th ST BEING NORTH

REGISTERED PROFESSIONAL LAND SURVEYOR
OREGON
JAMES G. NOBLE