CORRECTED PLAT
of survey for

LESTER A. MASTERTON

ISLAND CITY, OREGON

LOCATED IN THE NE1/4 NW1/4 OF SECTION 3 T3S R38E. W.M.

DECEMBER 10, 1974

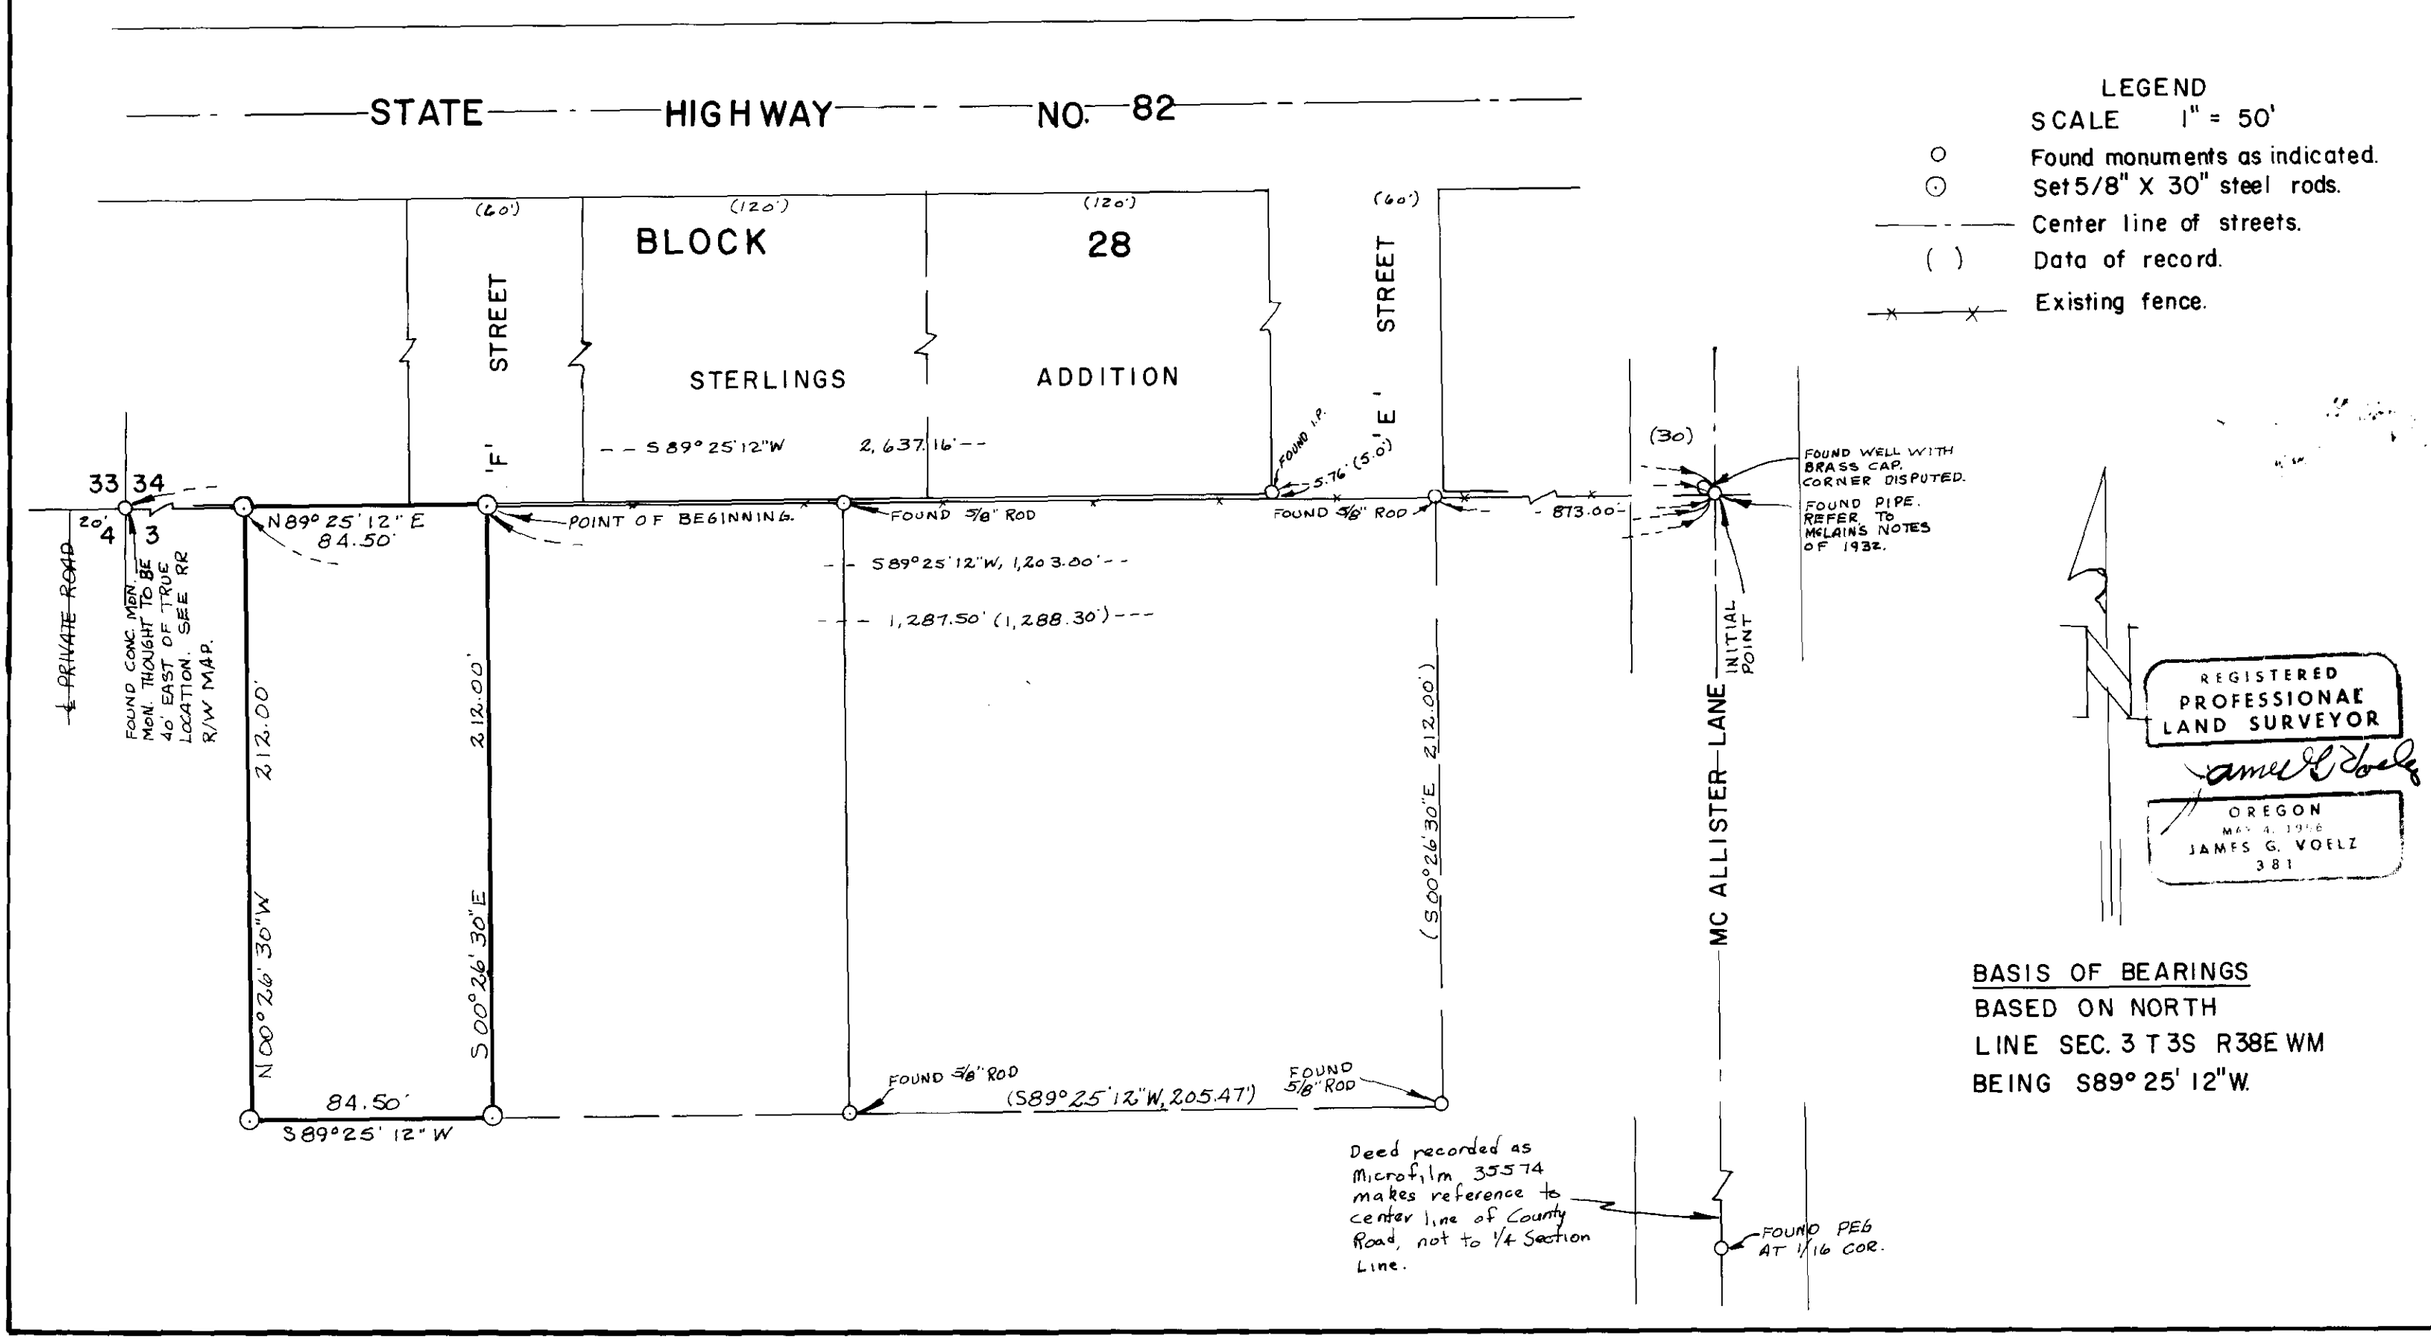

101-74