Ref: JN 215

SKETCH MAP of TRACT of LAND

Conveyed to KOOPMAN, Rodney D.

Located: North 150 feet of Lot 8, of the unrecorded Russell Tracts, being situate in the S.E. ¼ of Section 8, Twp. 3 S., R. 38E.; W.M., of Union County, Oregon

Reference: Recorded surveys, #53-70 and 39-67, all bearings True as recorded.

Scale: 1" : 200'

Dated: April 28, 1975

Prepared by Eastern Oregon Land Surveys - La Grande

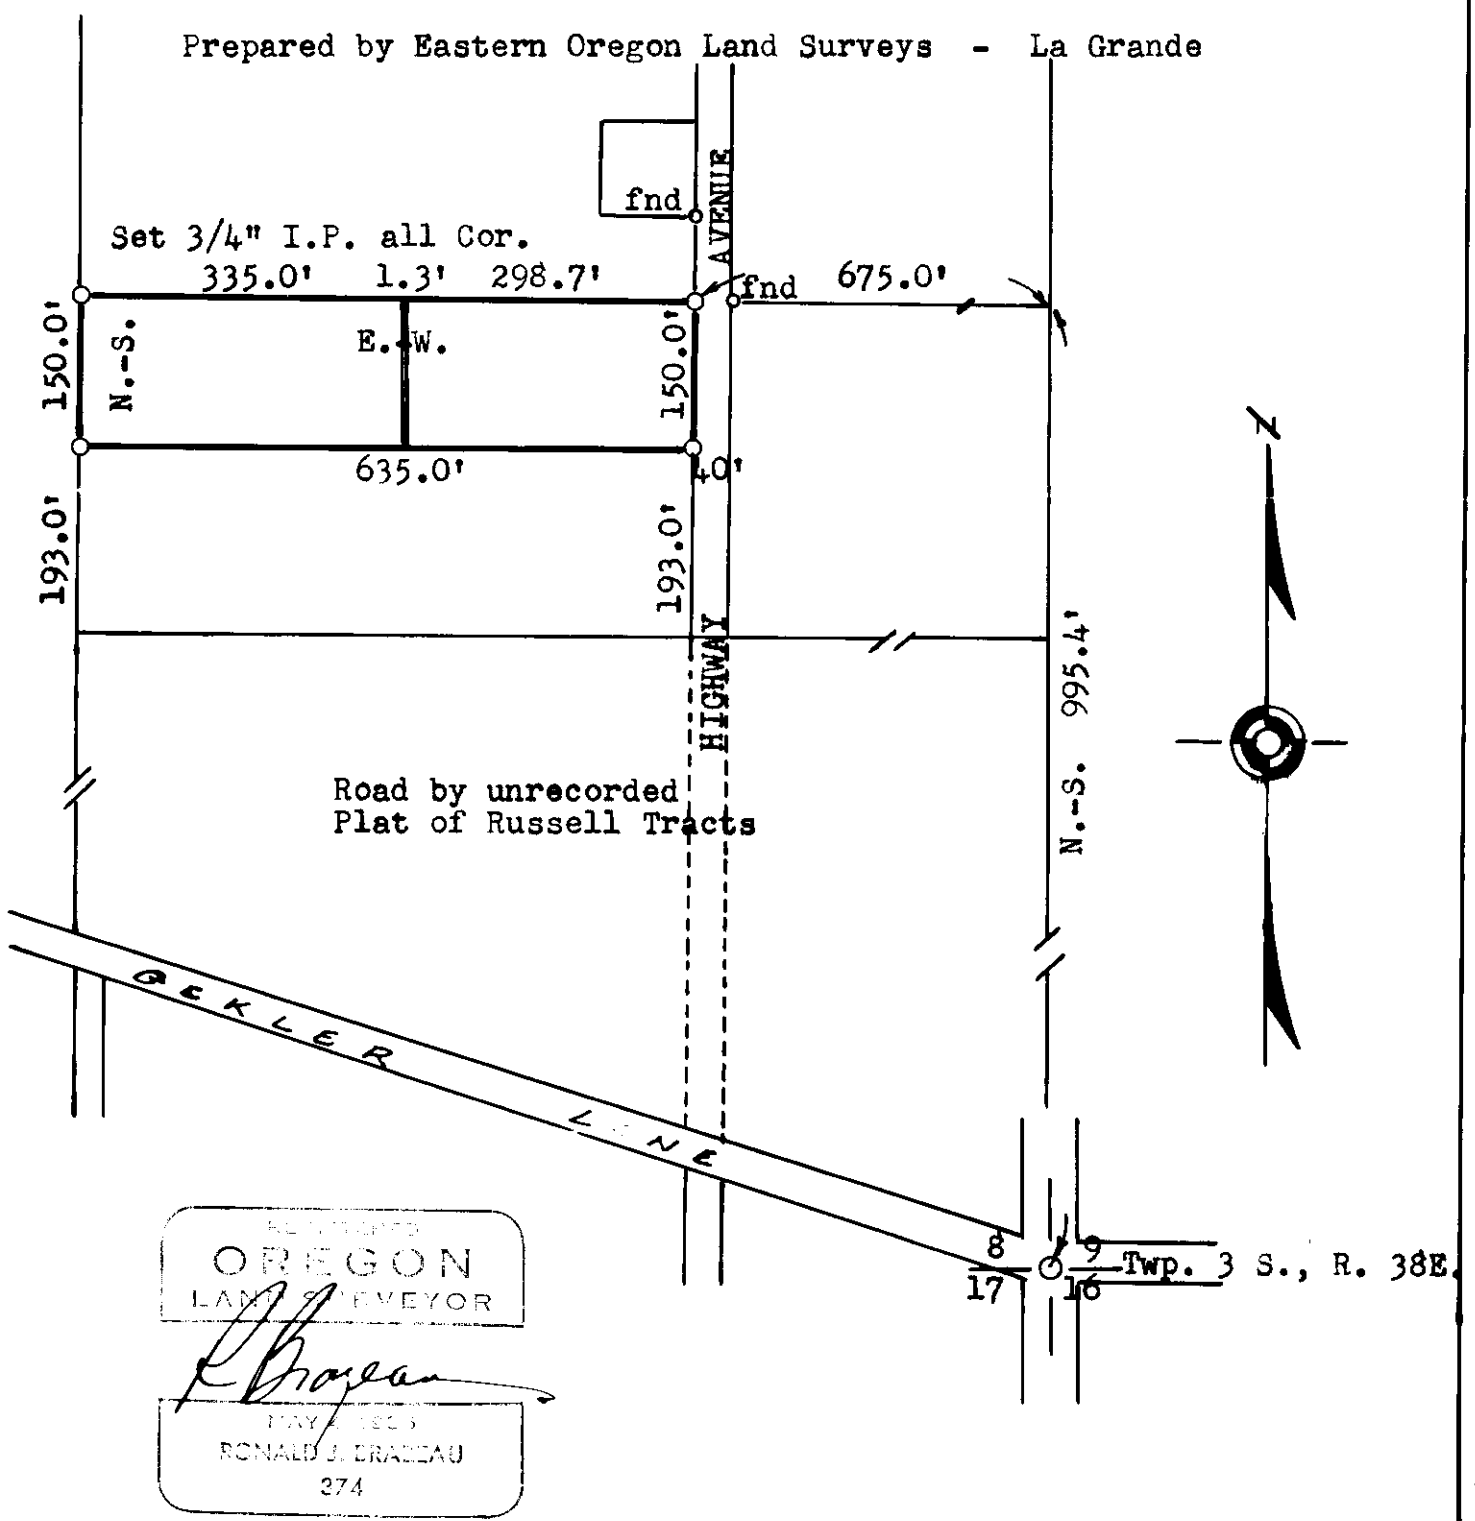

REGISTERED
OREGON
LAND SURVEYOR
RONALD J. BRAZEAU
374