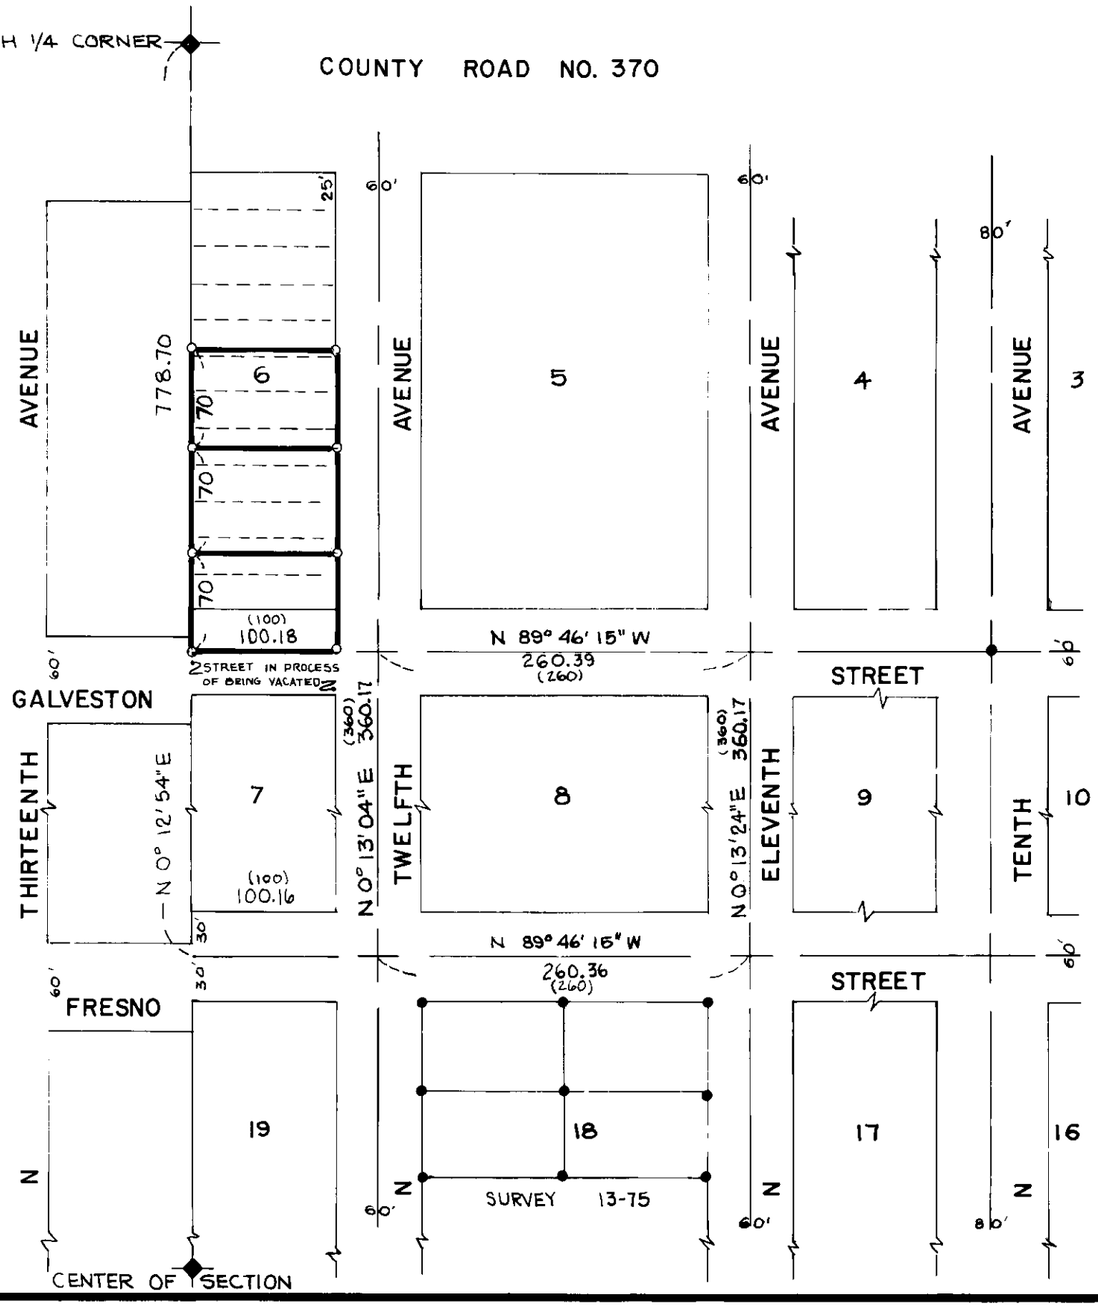

BASIS OF BEARING

SURVEY #13-75

LEGEND

- ● FOUND MONUMENT OF RECORD
- o SET IRON PIN
- ( ) RECORD BEARING AND DISTANCE

REFERENCE MATERIAL

SURVEY #13-75

Howard A. Perry

MAP OF SURVEY
SOUTHERLY PORTION OF BLOCK 6 IN HINDMAN'S ADDITION TO ELGIN
UNION COUNTY, OREGON

FOR: WALT WEBB

SCALE	ANDERSON · PERRY & ASSOCIATES, INC.	SHEET NO
1" = 100'	ENGINEERING SURVEYING AND MATERIALS TESTING	1
DATE		
AUG. 1975	LA GRANDE & ENTERPRISE, OREGON	

21-75