


PLAT
of survey for
J. W. FLEET
COVE, AVENUE
LA GRANDE, OREGON

LOCATED IN NW 1/4 NW 1/4 OF SECTION. 9, T3 S R38E. W.M. AT LA GRANDE, UNION COUNTY, OREGON.

- LEGEND
SCALE 1" = 60'
- Found monuments as indicated.
 - Set 5/8" X 30" steel rods.
 - Center line of streets.
 - () Data of record.

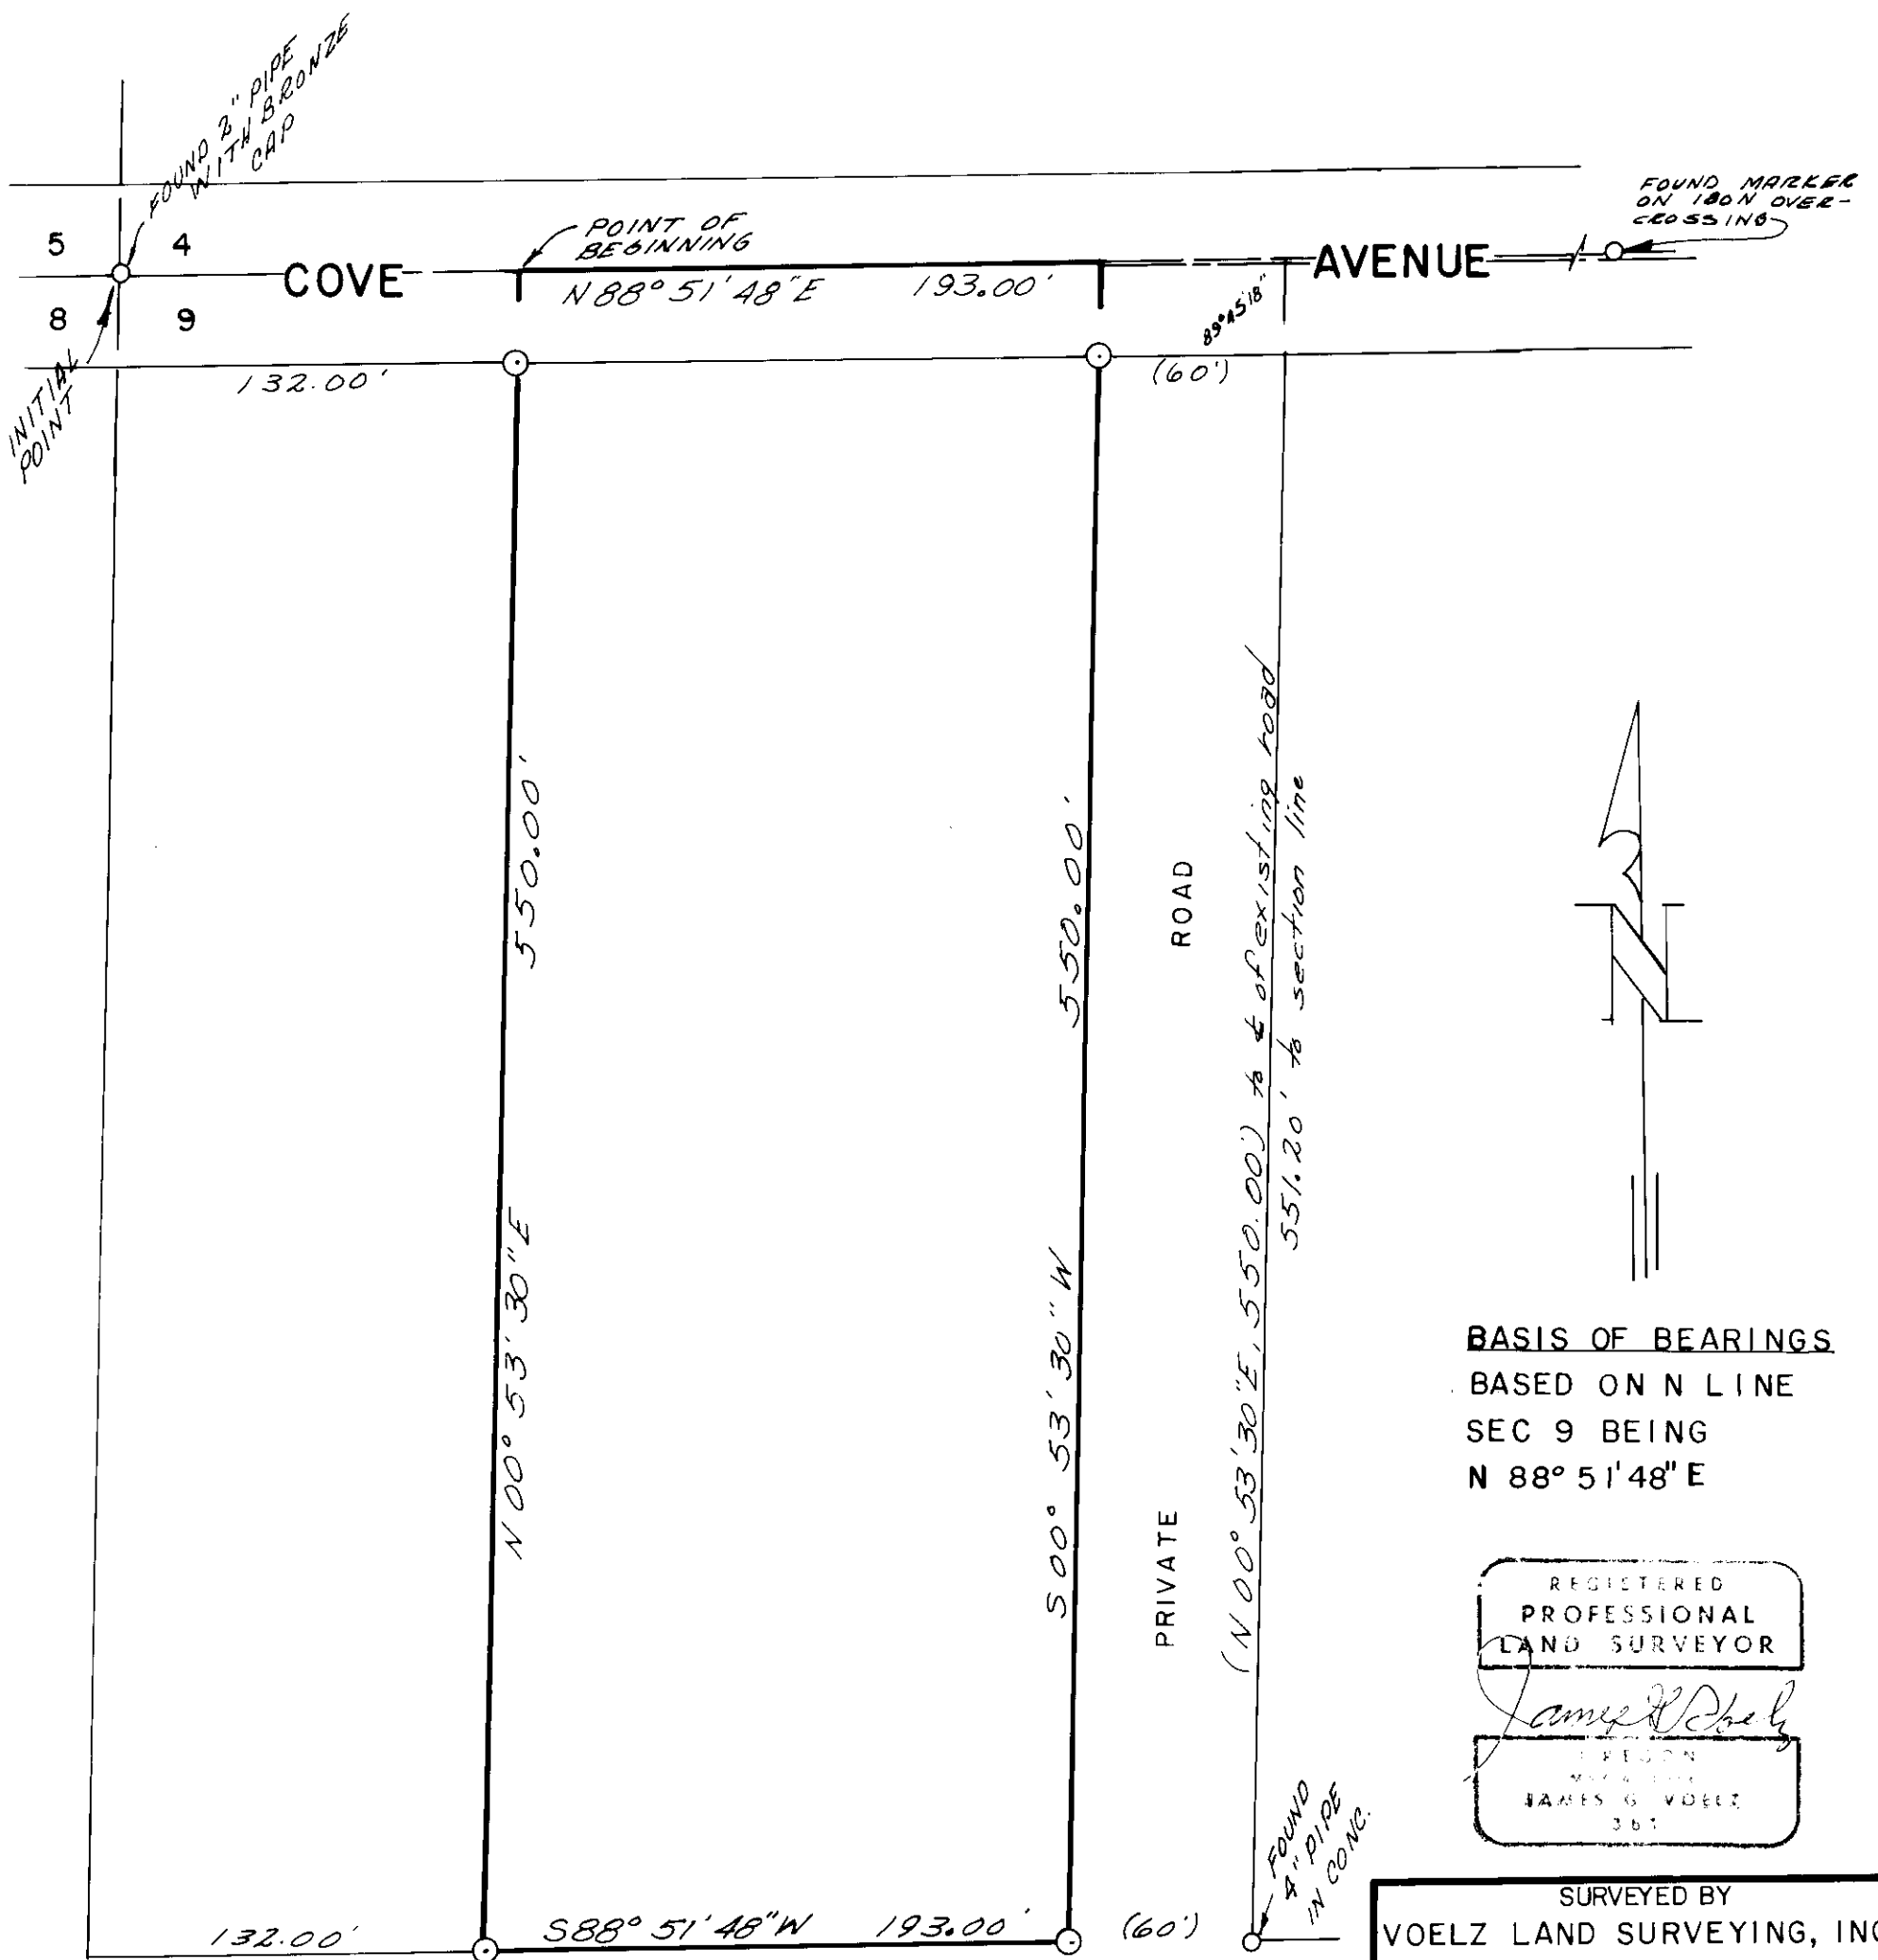

BASIS OF BEARINGS
BASED ON N LINE
SEC 9 BEING
 $N 88^{\circ} 51' 48'' E$

REGISTERED
PROFESSIONAL
LAND SURVEYOR

James G. Voelz

OREGON
MAY 19 1975
JAMES G. VOELZ
351

SURVEYED BY VOELZ LAND SURVEYING, INC.	
SURVEYED FOR J. W. FLEET	
DATE JULY 29, 1975	SCALE 1" = 60'

32-76