



PLAT  
of survey for  
**ORAL EVANS**  
ROUTE 1 BOX 104  
COVE, OREGON

LOCATED IN THE SW1/4 NW1/4 OF SECTION 14, T3S R40E WM.

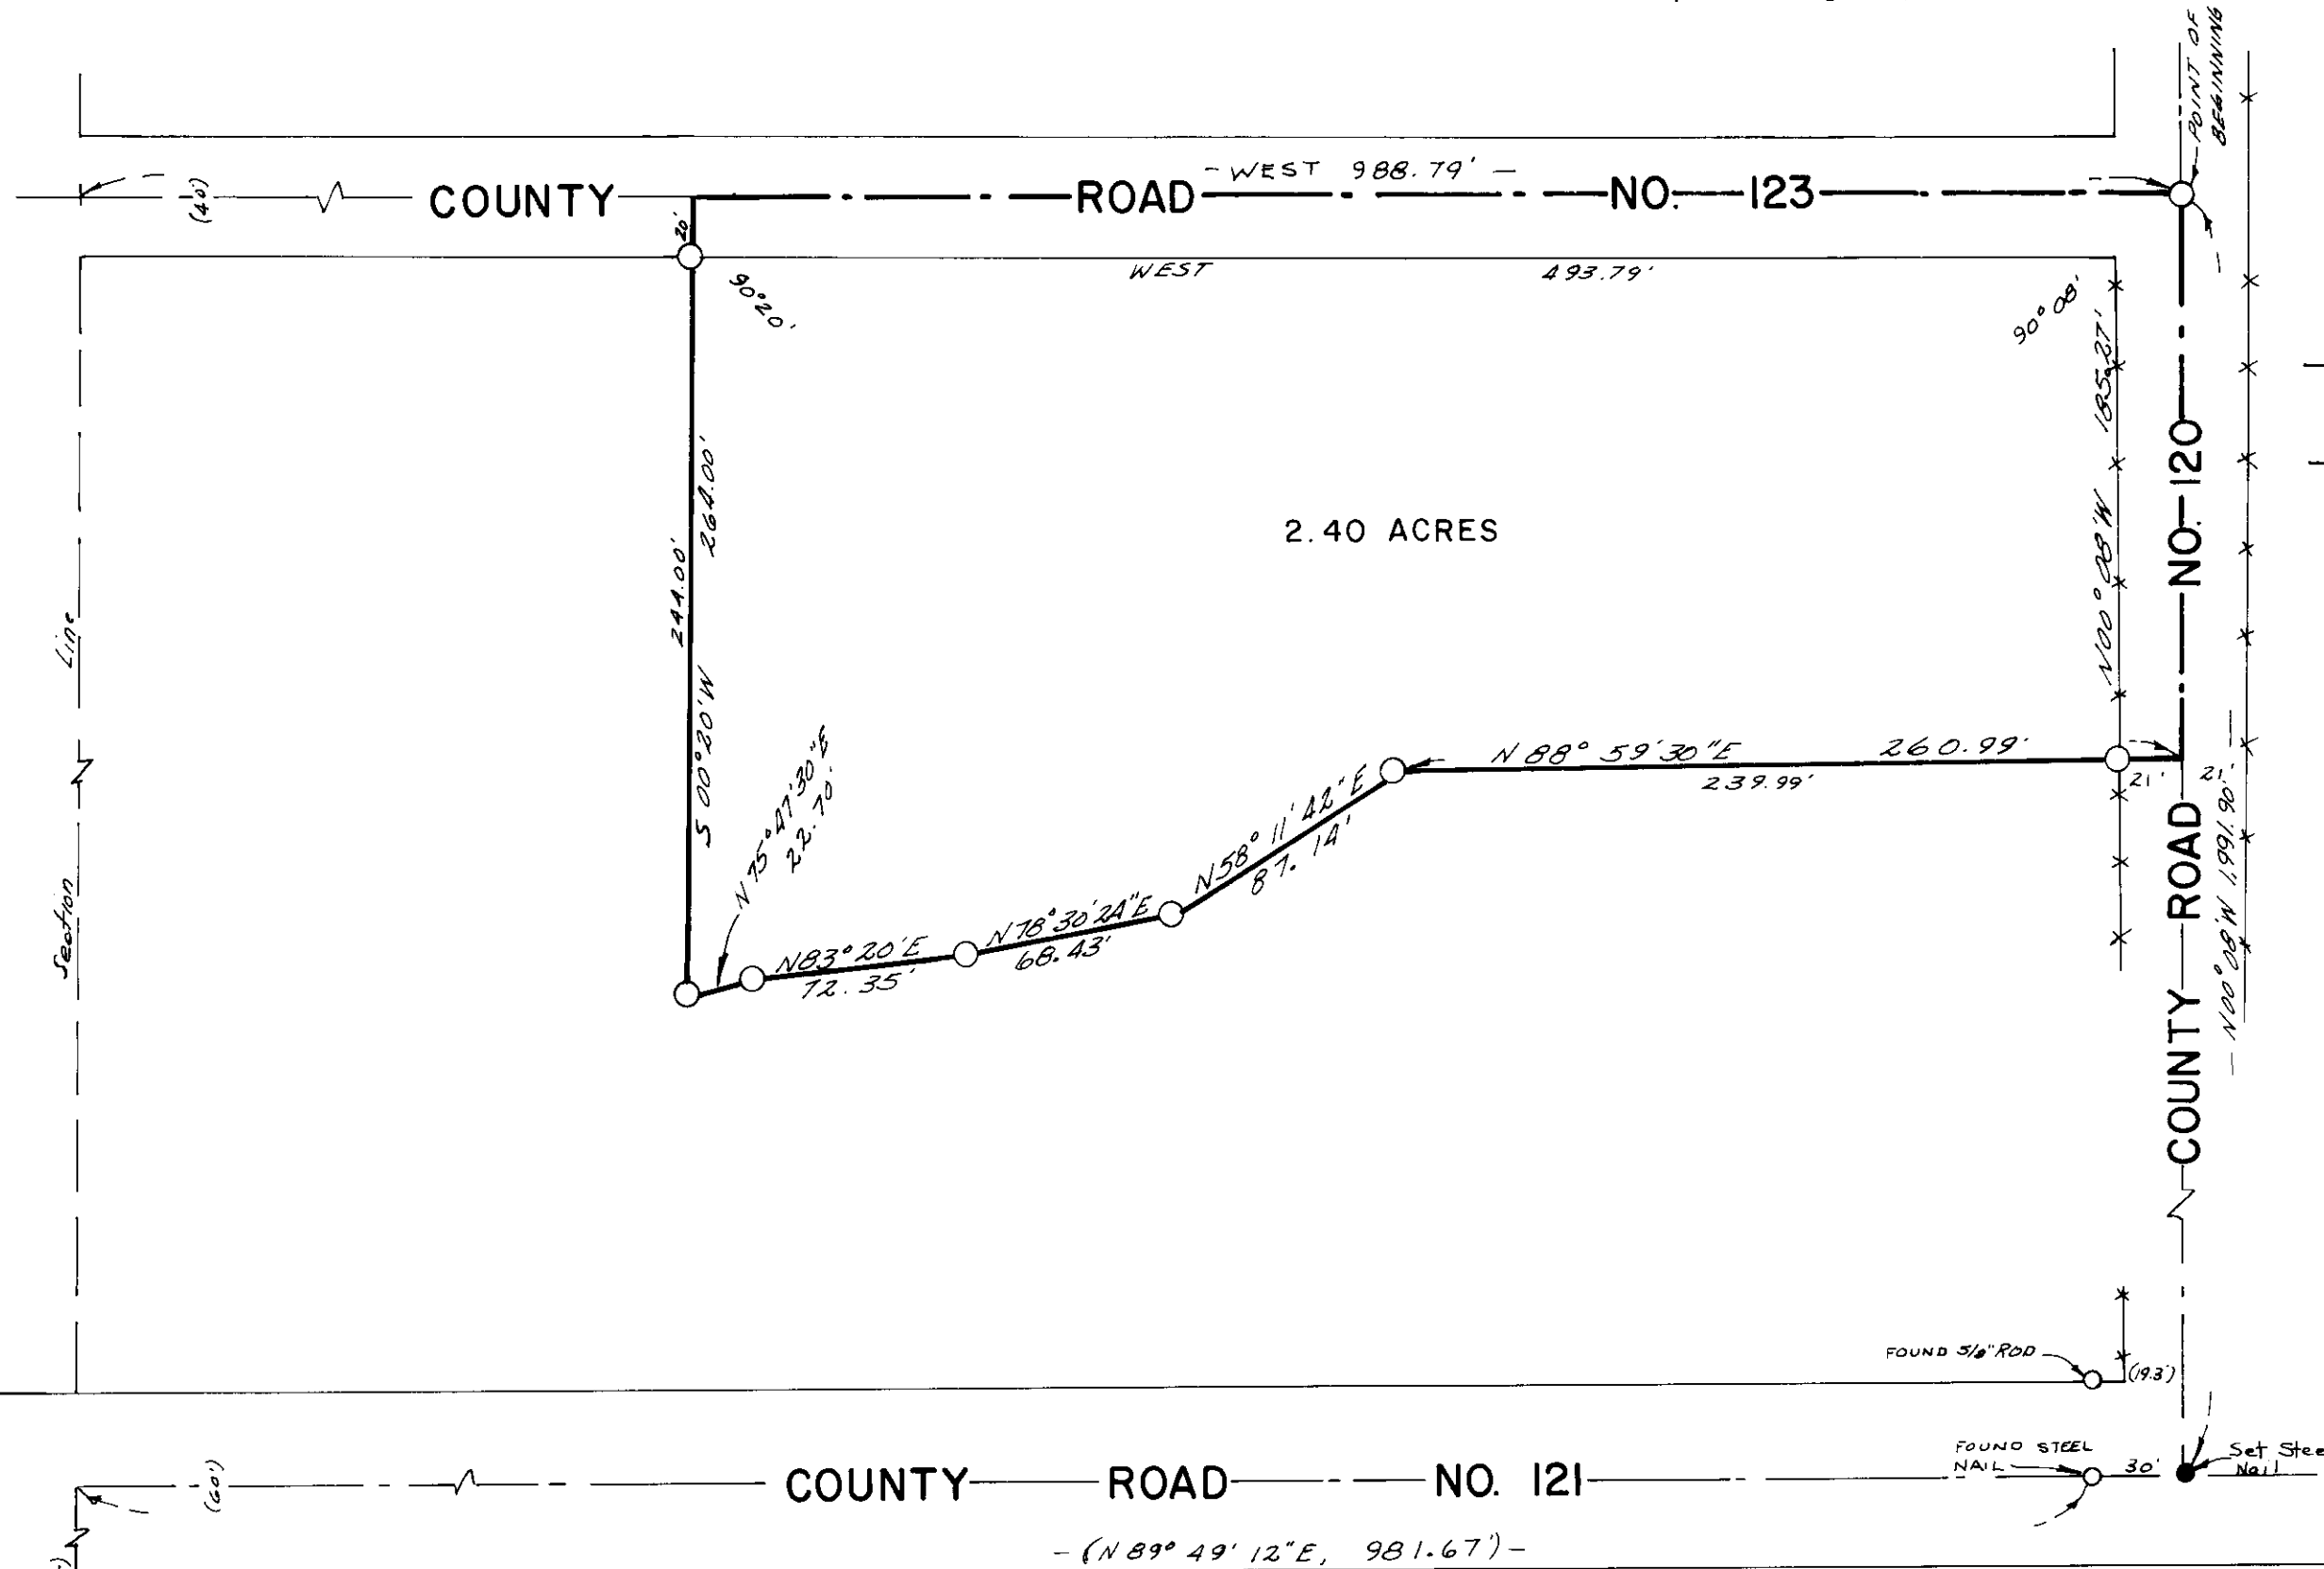


- LEGEND  
SCALE 1" = 60'
- Found monuments as indicated.
  - Set 5/8" X 30" steel rods.
  - Center line of roads.
  - ( ) Data of record.
  - \*-\*-\* Existing fences

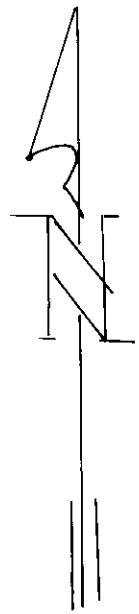

BASIS OF BEARINGS  
BASED ON C OF CO.  
RD. NO. 120 BEING  
N 00° 08' W.

*Emil Voelz*

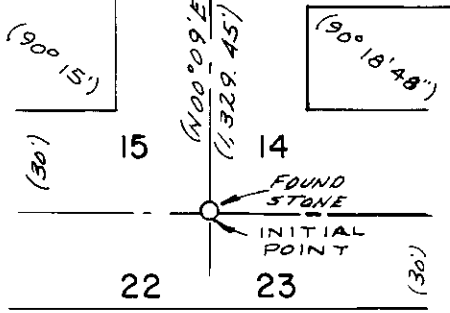

SURVEYED BY VOELZ LAND SURVEYING, INC.	
SURVEYED FOR ORAL EVANS	
DATE MAY 19, 1975	SCALE 1" = 60'

28.75