PLAT
of survey for

DALE YOUNG

508 SUNSET DRIVE
LA GRANDE, OREGON
DECEMBER 23, 1974
LOCATED IN THE N1/2 NW1/4 OF SECTION 3 T3S R38E W.M., UNION COUNTY, OREGON

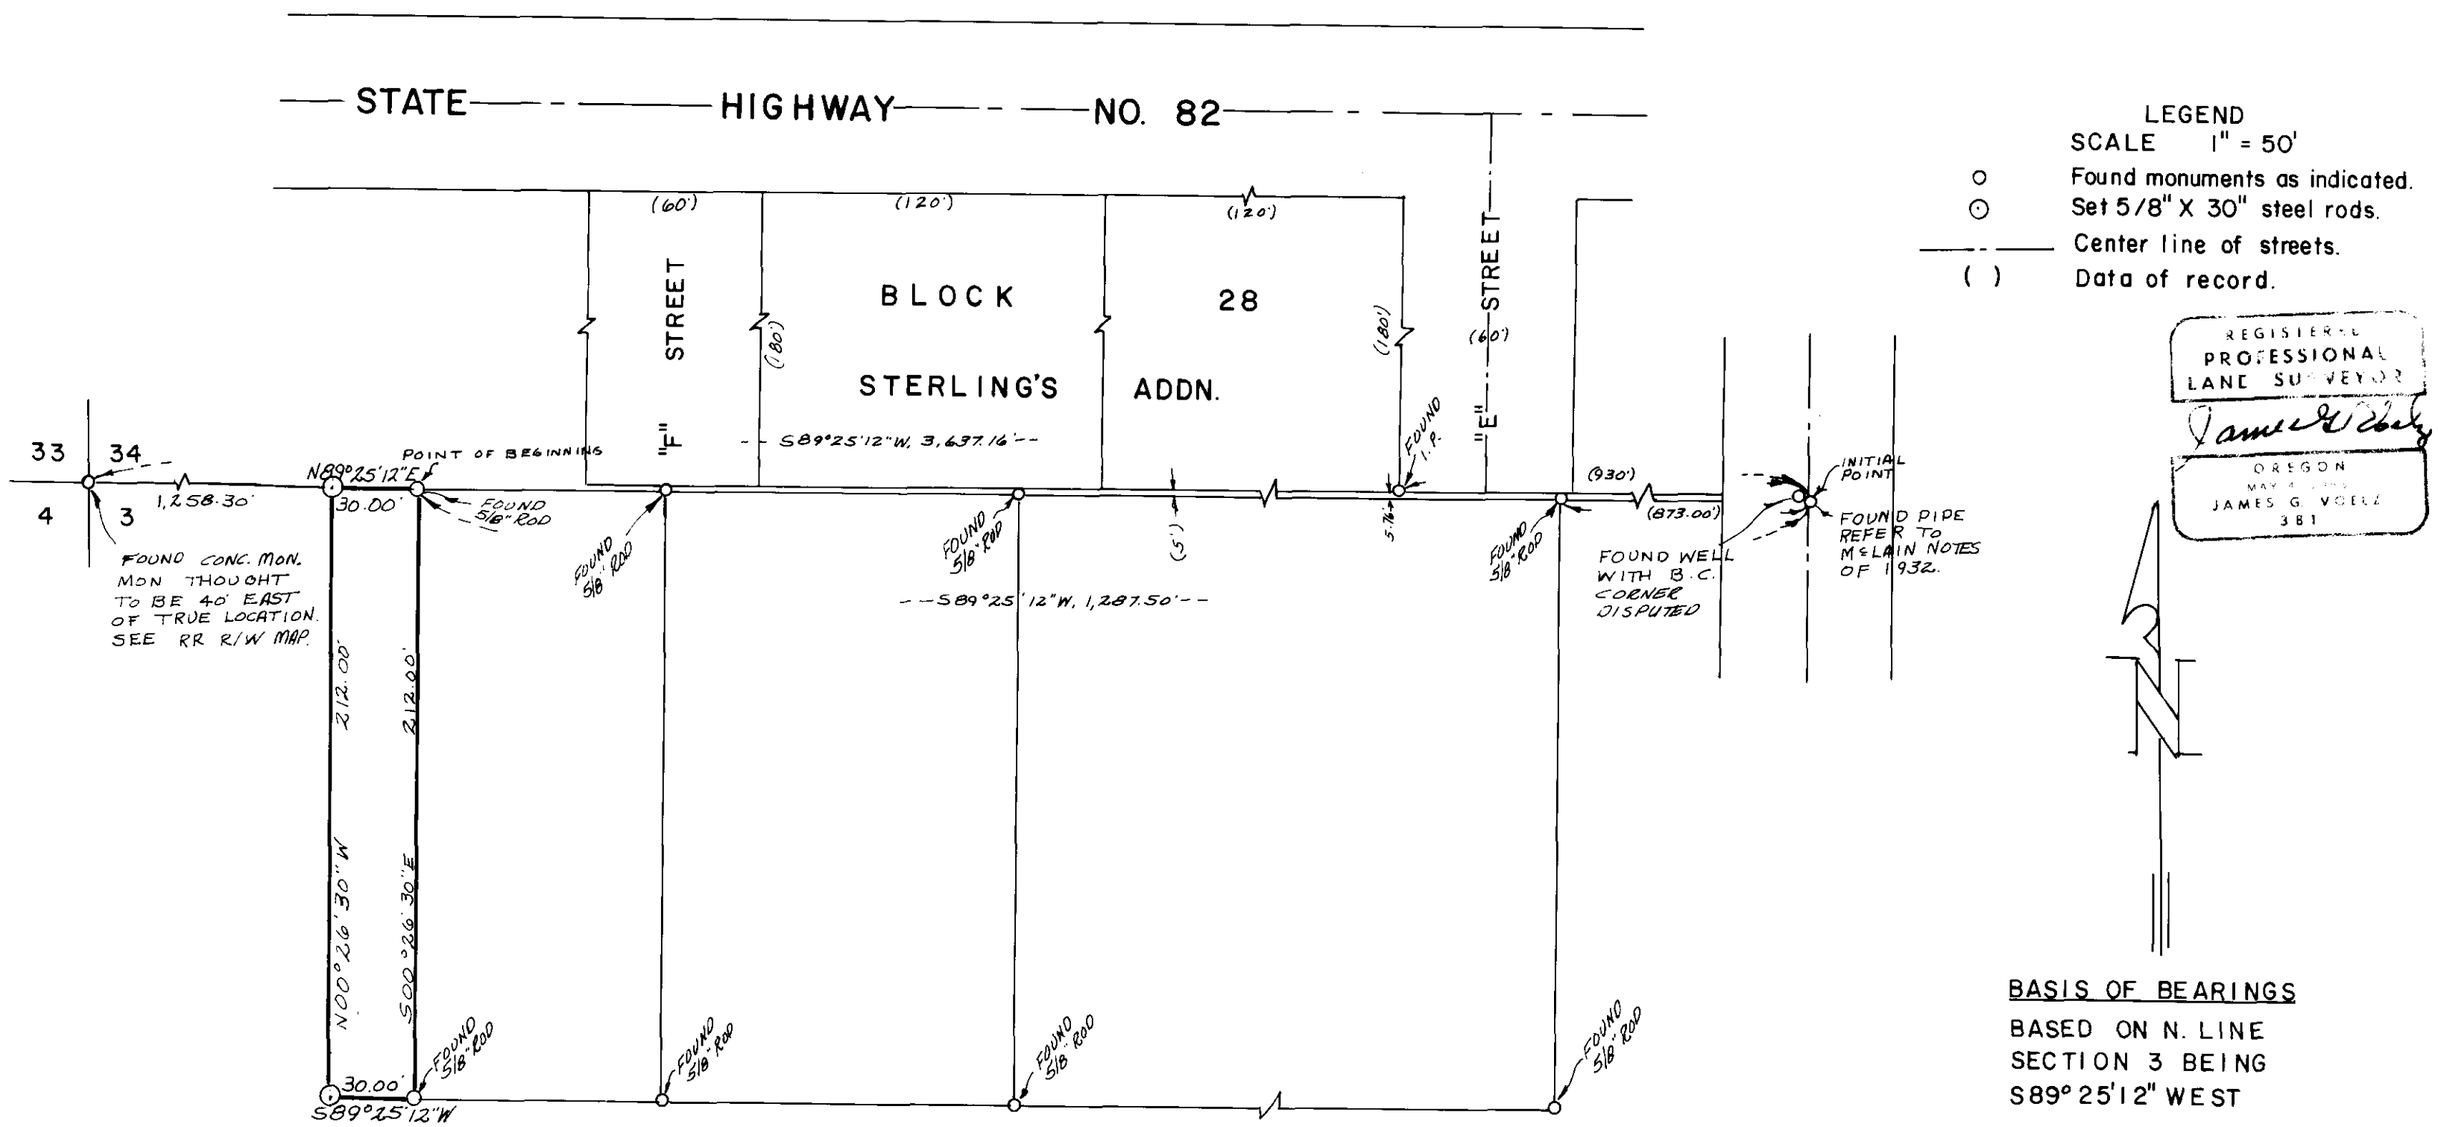

46-75