


PLAT
of survey for
ETTA RUBERG
UNION, OREGON

LOCATED IN BLOCK 4, McCULLY ADDITION TO UNION, UNION COUNTY, OREGON

LEGEND
SCALE 1" = 60'

- Found monuments as indicated.
- ⊙ Set 5/8" X 30" steel rods.
- Center line of streets.
- () Data of record.

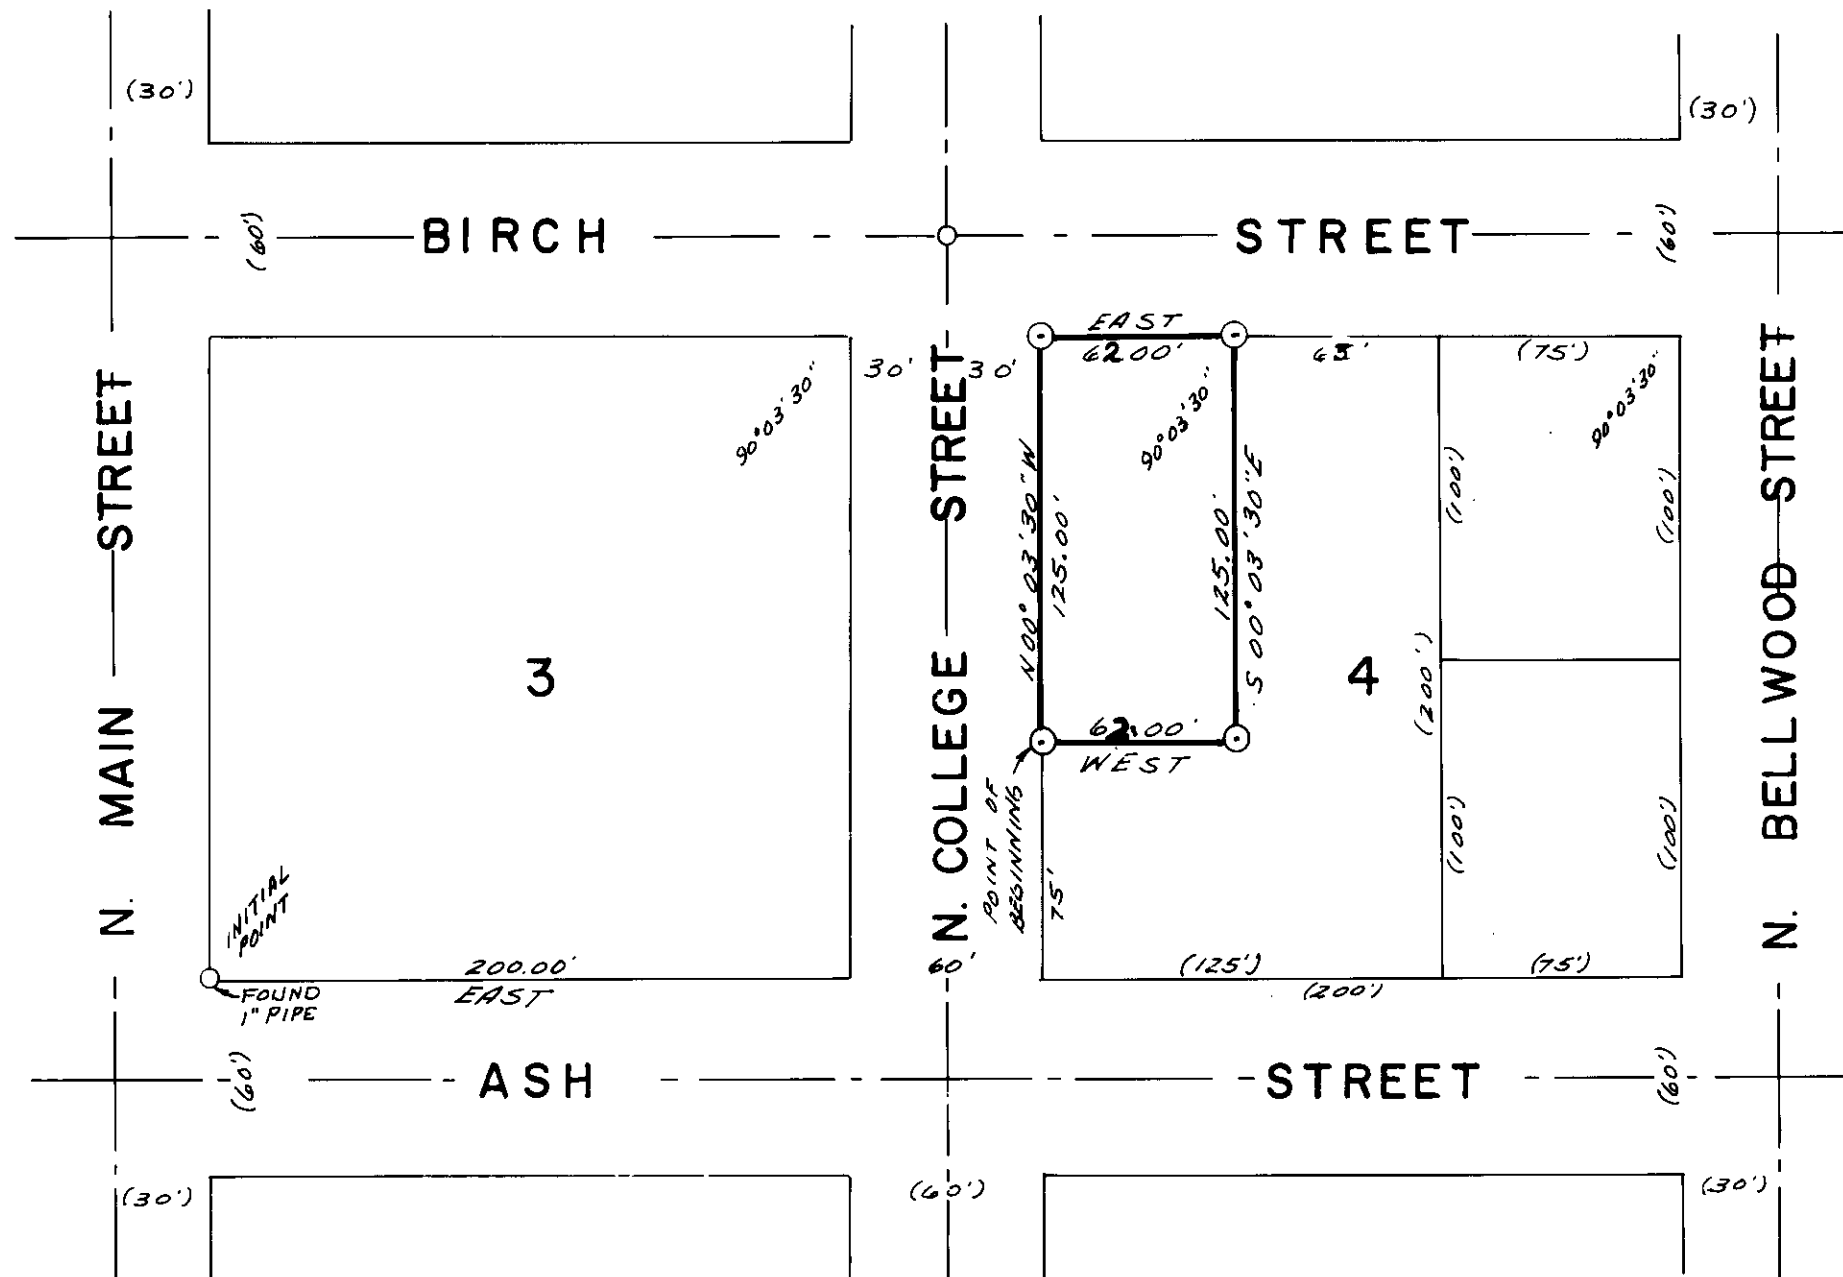

BASIS OF BEARINGS
BASED ON SOUTH
LINE BLOCK 3
BEING EAST

[Handwritten signature and date]

SURVEYED BY VOELZ LAND SURVEYING, INC.	
SURVEYED FOR ETTA RUBERG	
DATE DECEMBER 29, 1975	SCALE 1" = 60'

67-7-8