


PLAT
of survey for
WALTER GRESHAM
BOX 626
ELGIN, OREGON
PORTIONS OF LOTS 15 THRU 20 BLOCK 71
HINDMAN'S ADDITION TO ELGIN, OREGON

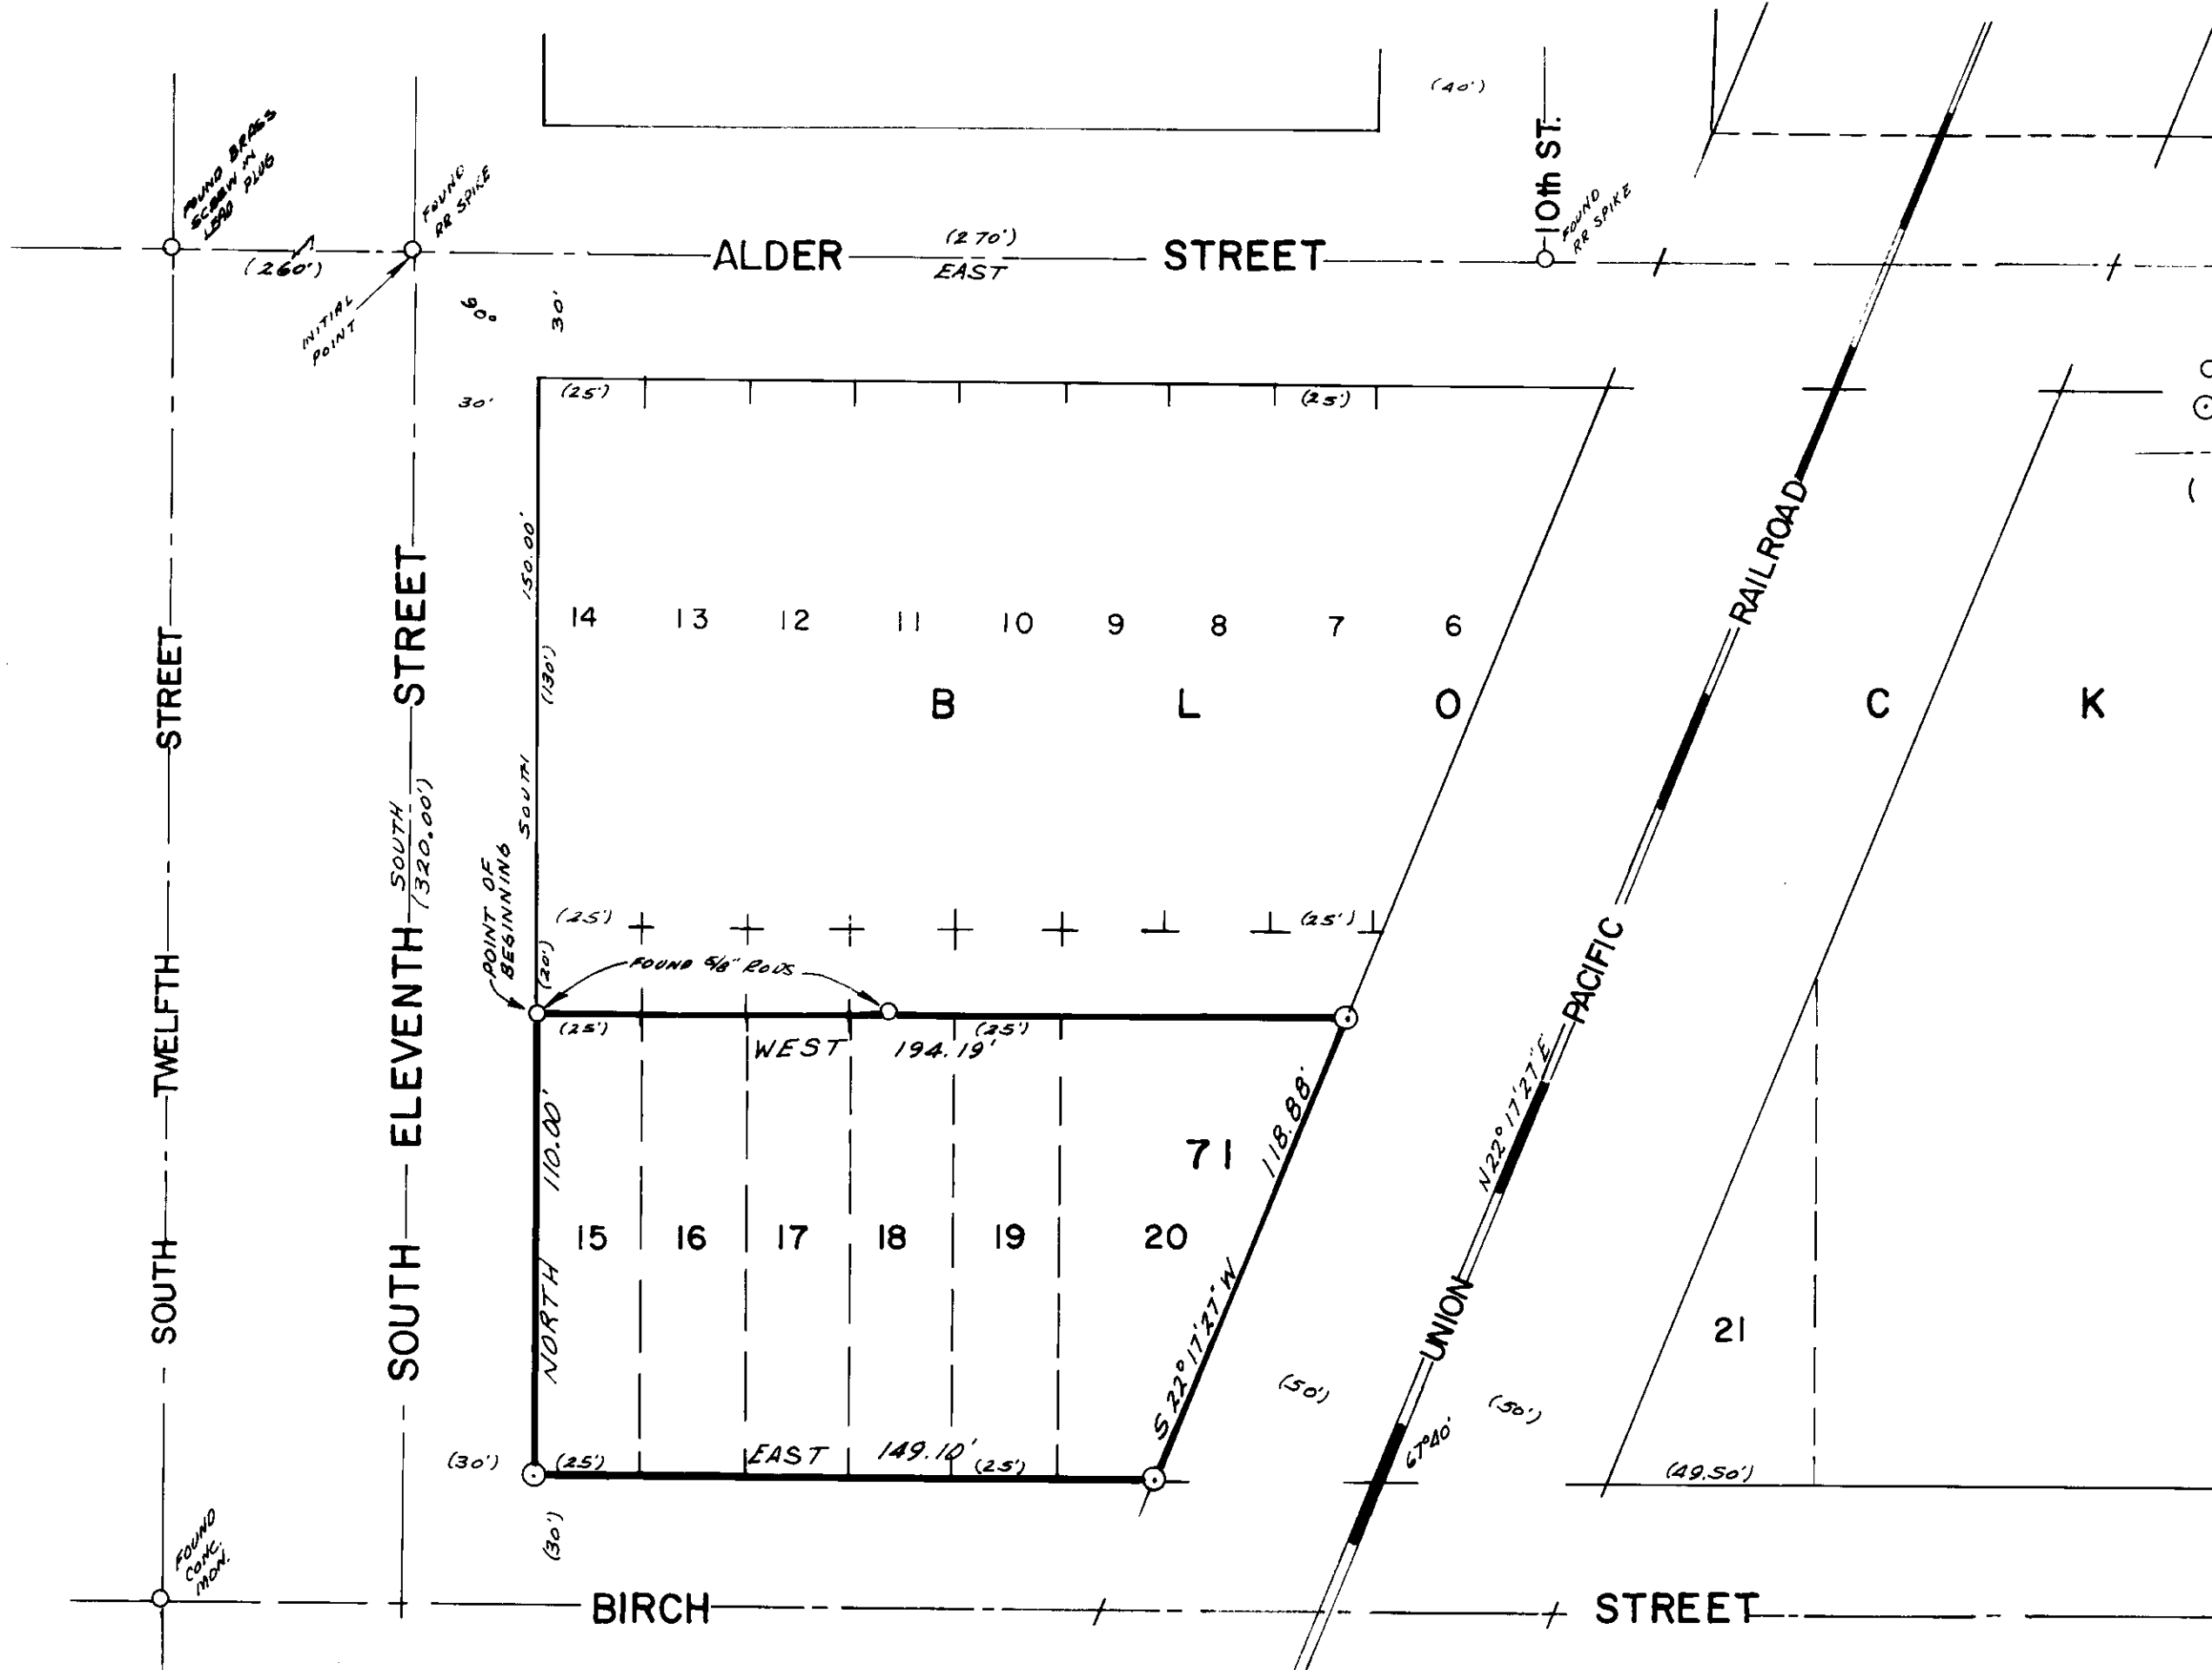

LEGEND
SCALE 1" = 40'
○ Found monuments as indicated.
⊙ Set 5/8" X 30" steel rods.
--- Center line of streets.
() Data of record.

James W. Voelz
N

BASIS OF BEARINGS
BASED ON \hat{c}
OF ALDER STREET
BEING EAST

SURVEYED BY VOELZ LAND SURVEYING, INC.	
SURVEYED FOR WALTER GRESHAM	
DATE OCTOBER 13, 1975	SCALE 1" = 40'

63-7-6