PLAT
of survey for

MRS VERNA BUTLER

3103 N. 4TH. STREET
LA GRANDE, OREGON 97850

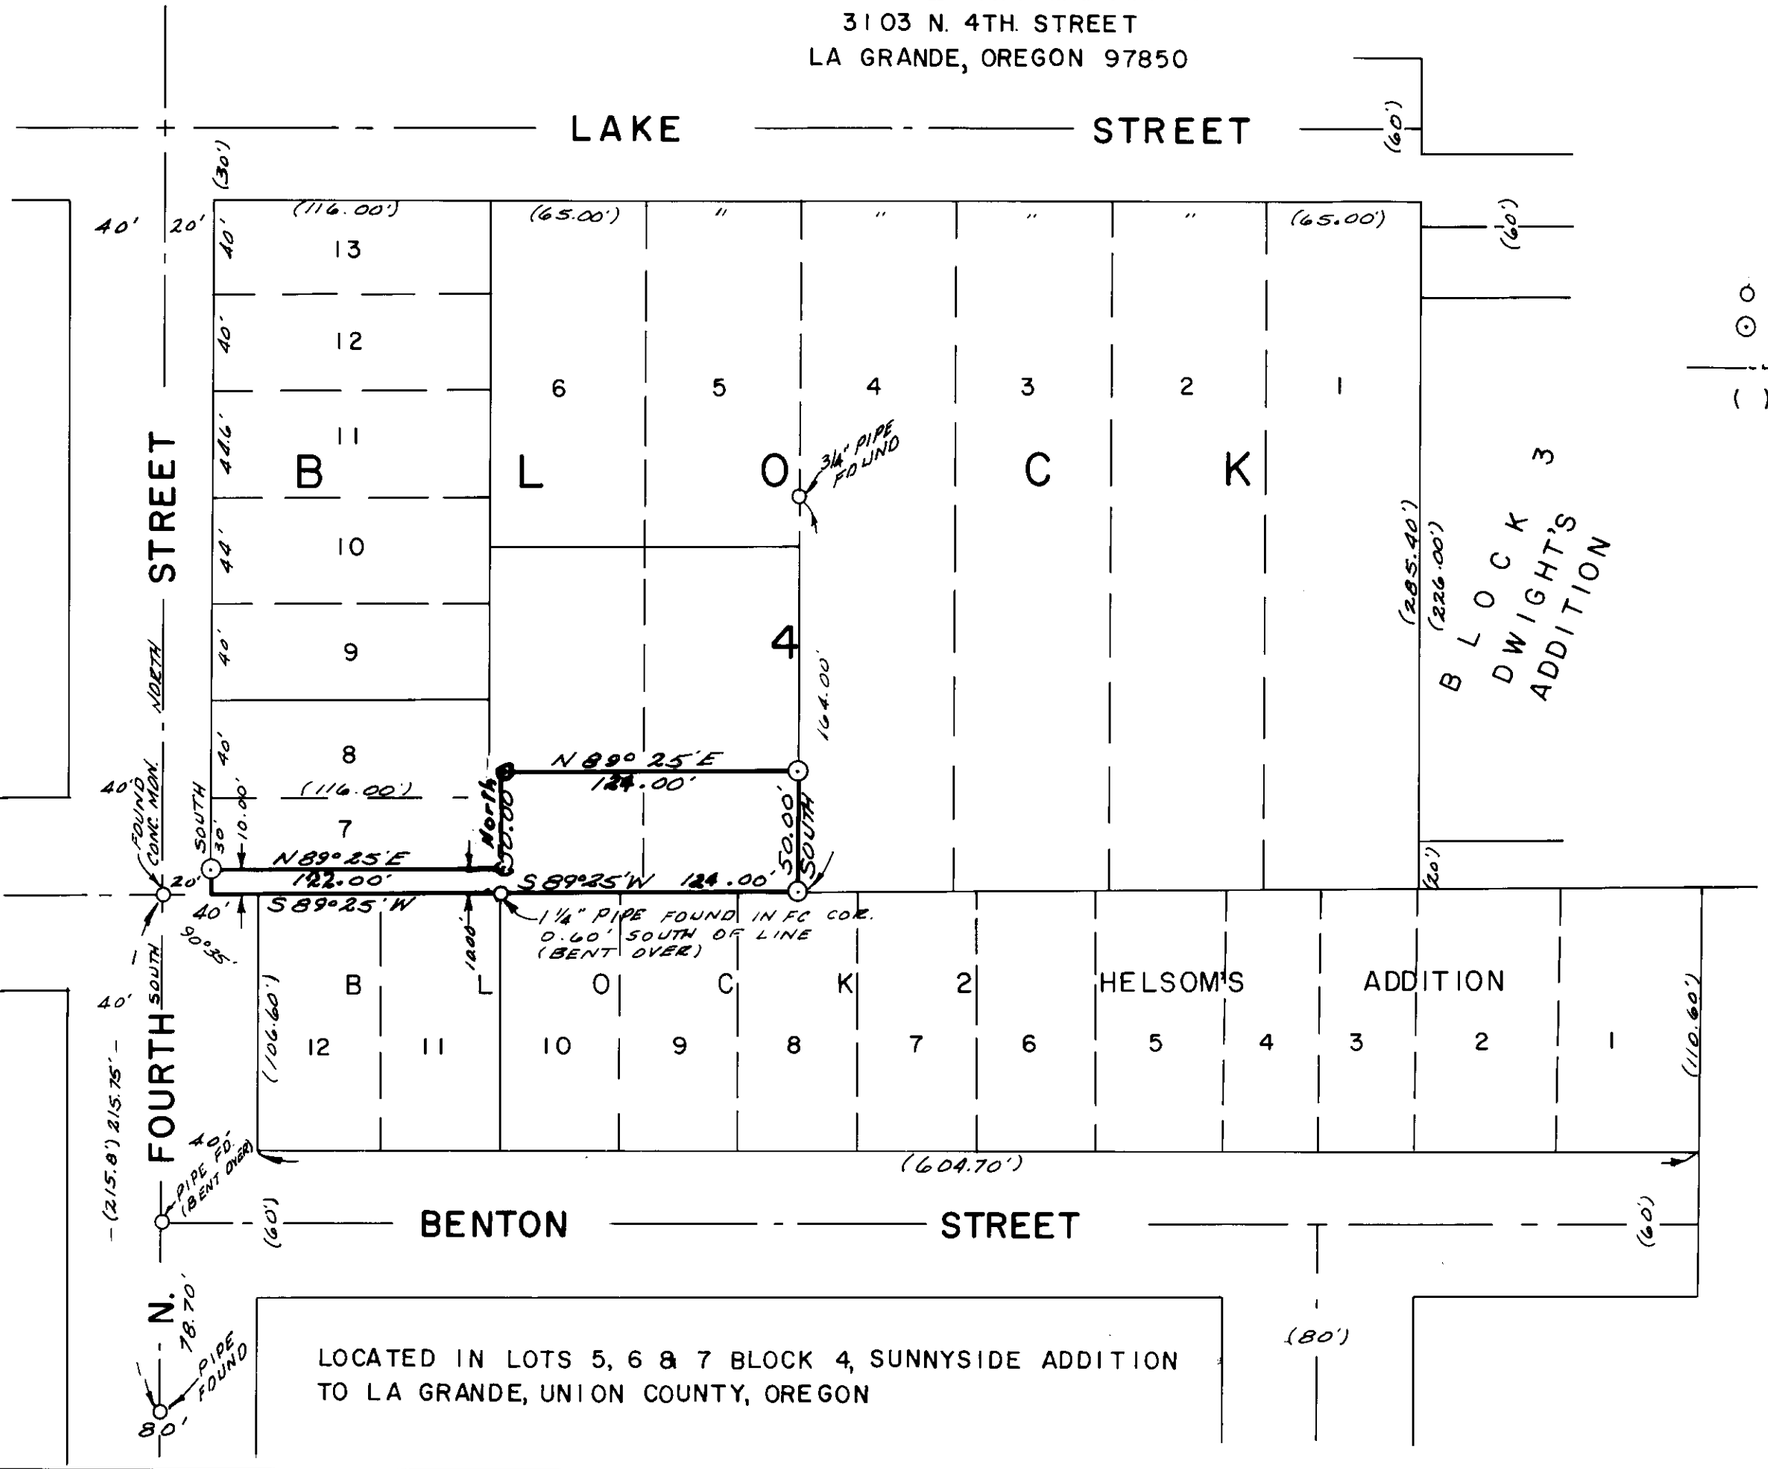

LEGEND
SCALE 1" = 60'

- ○ Found monuments as indicated
- ⊙ Set 5/8" X 30" steel rods
- —·—·— Centerline of streets.
- ( ) Data of record.

BASIS OF BEARINGS
BASED ON FOURTH STREET, LINE OF MON., BEING NORTH

LOCATED IN LOTS 5, 6 & 7 BLOCK 4, SUNNYSIDE ADDITION TO LA GRANDE, UNION COUNTY, OREGON

SURVEYED BY	
VOELZ LAND SURVEYING, INC.	
SURVEYED FOR	
MRS. VERNA BUTLER	
DATE	SCALE
DEC. 14, 1975	1" = 60'