




80'

G AVE.

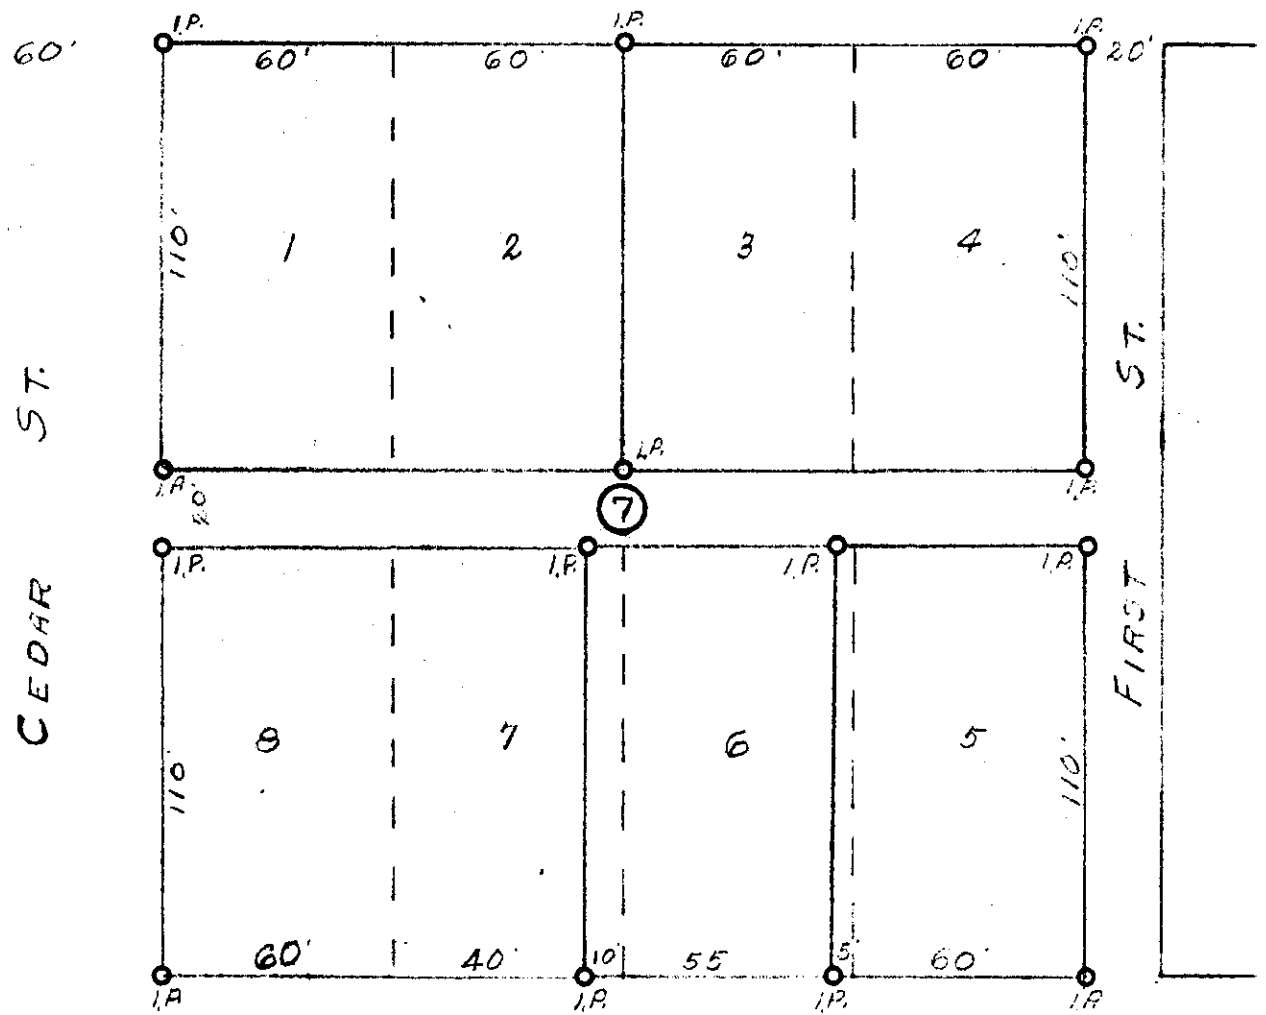


CEDAR ST.

FIRST ST.

80'

F AVE.

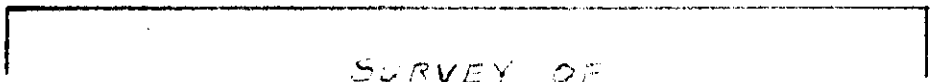

SURVEY OF
 BLOCK 7-ARNOLD & DRAY ADD.
 LAGRANDE-UNION, CO. - OREGON
 scale 1" = 50' June 1-58

