



JEFERSON AVE.

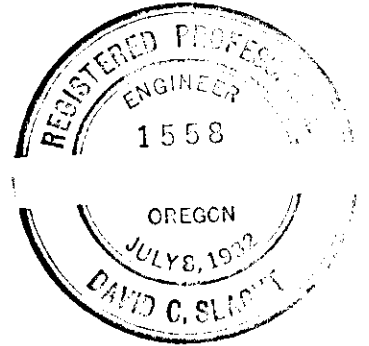

4TH STREET

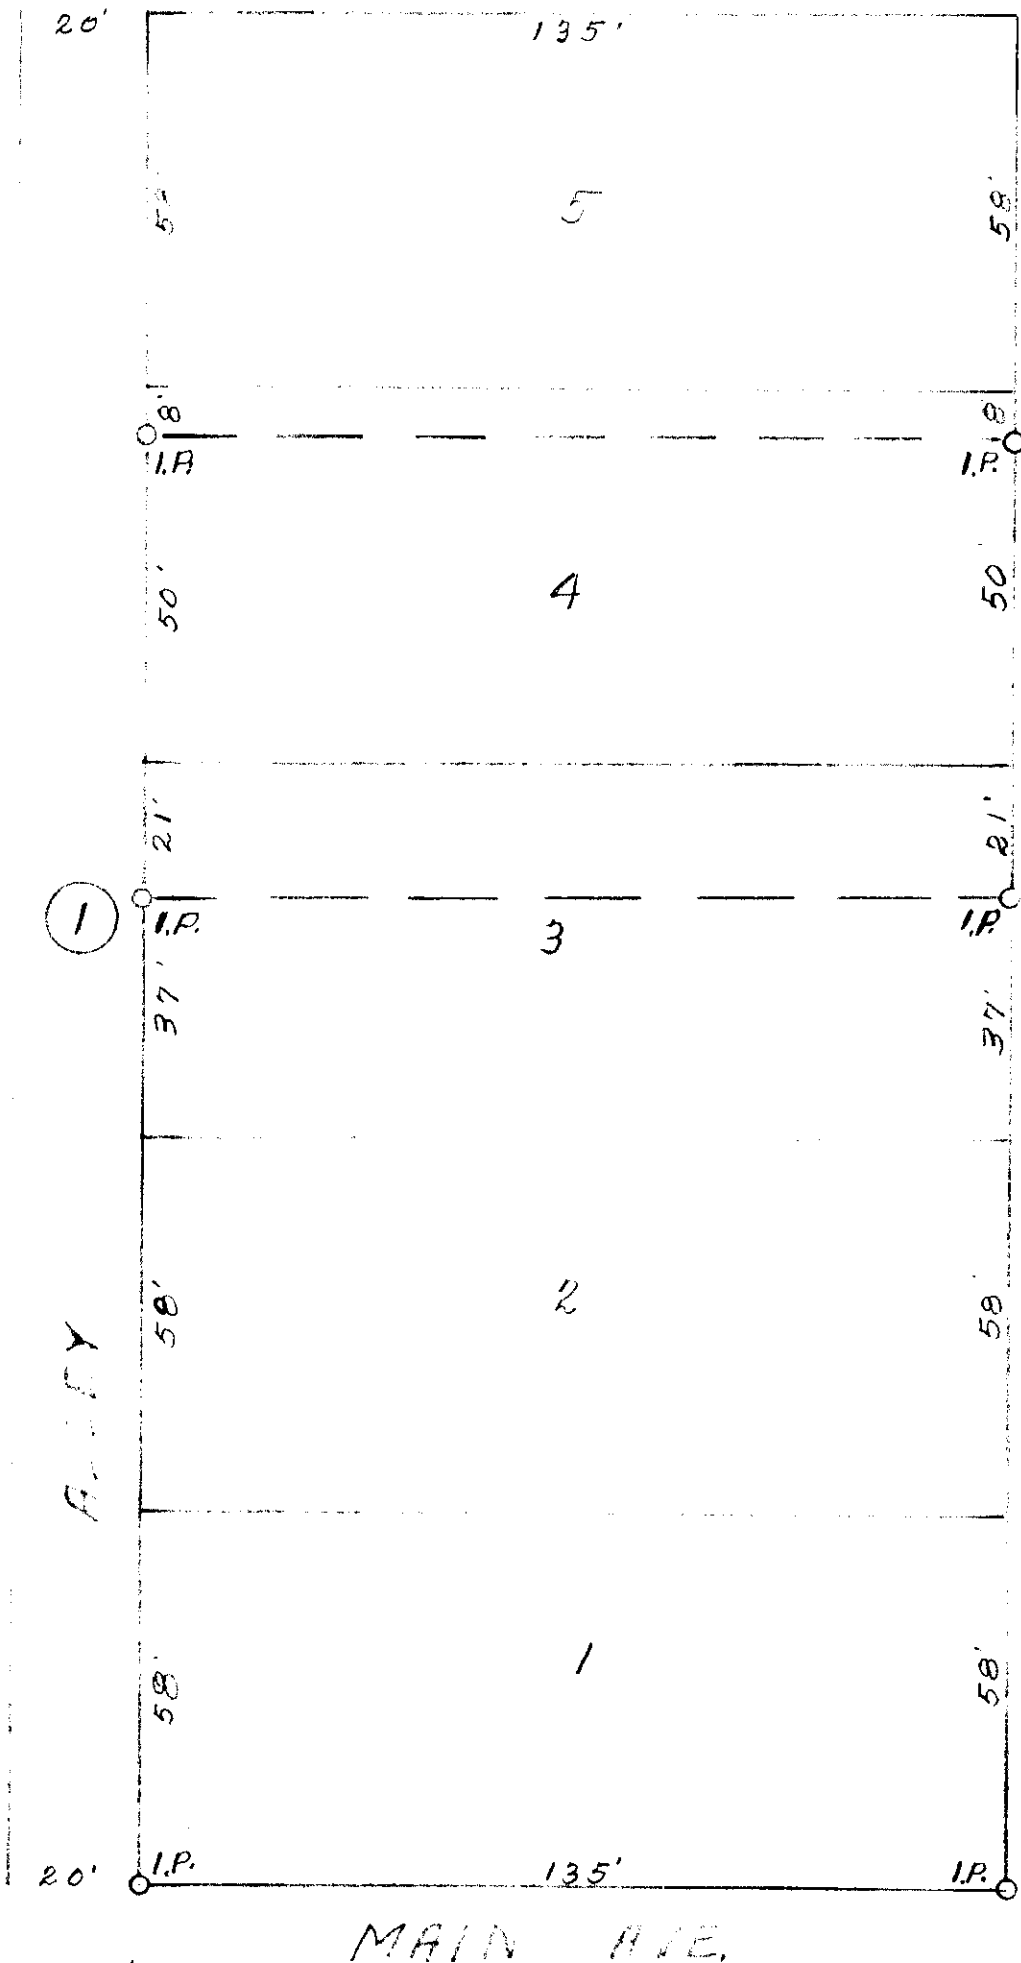

SURVEY OF THE EAST 1/2 OF BLOCK 1 GRANDY'S ADDITION TO CITY OF GRANDER UNION CO. OREGON Scale 1"=30' Feb 1955

SL 78 75