


Survey of
 California-Pacific Utilities Co. Property
 in
 Lot 5 Block 10 of Chaplin's Addition
 La Grande, Union County, Oregon
 Deed Recorded in Book 139 Page 384
 Scale 1" = 100' August 1957

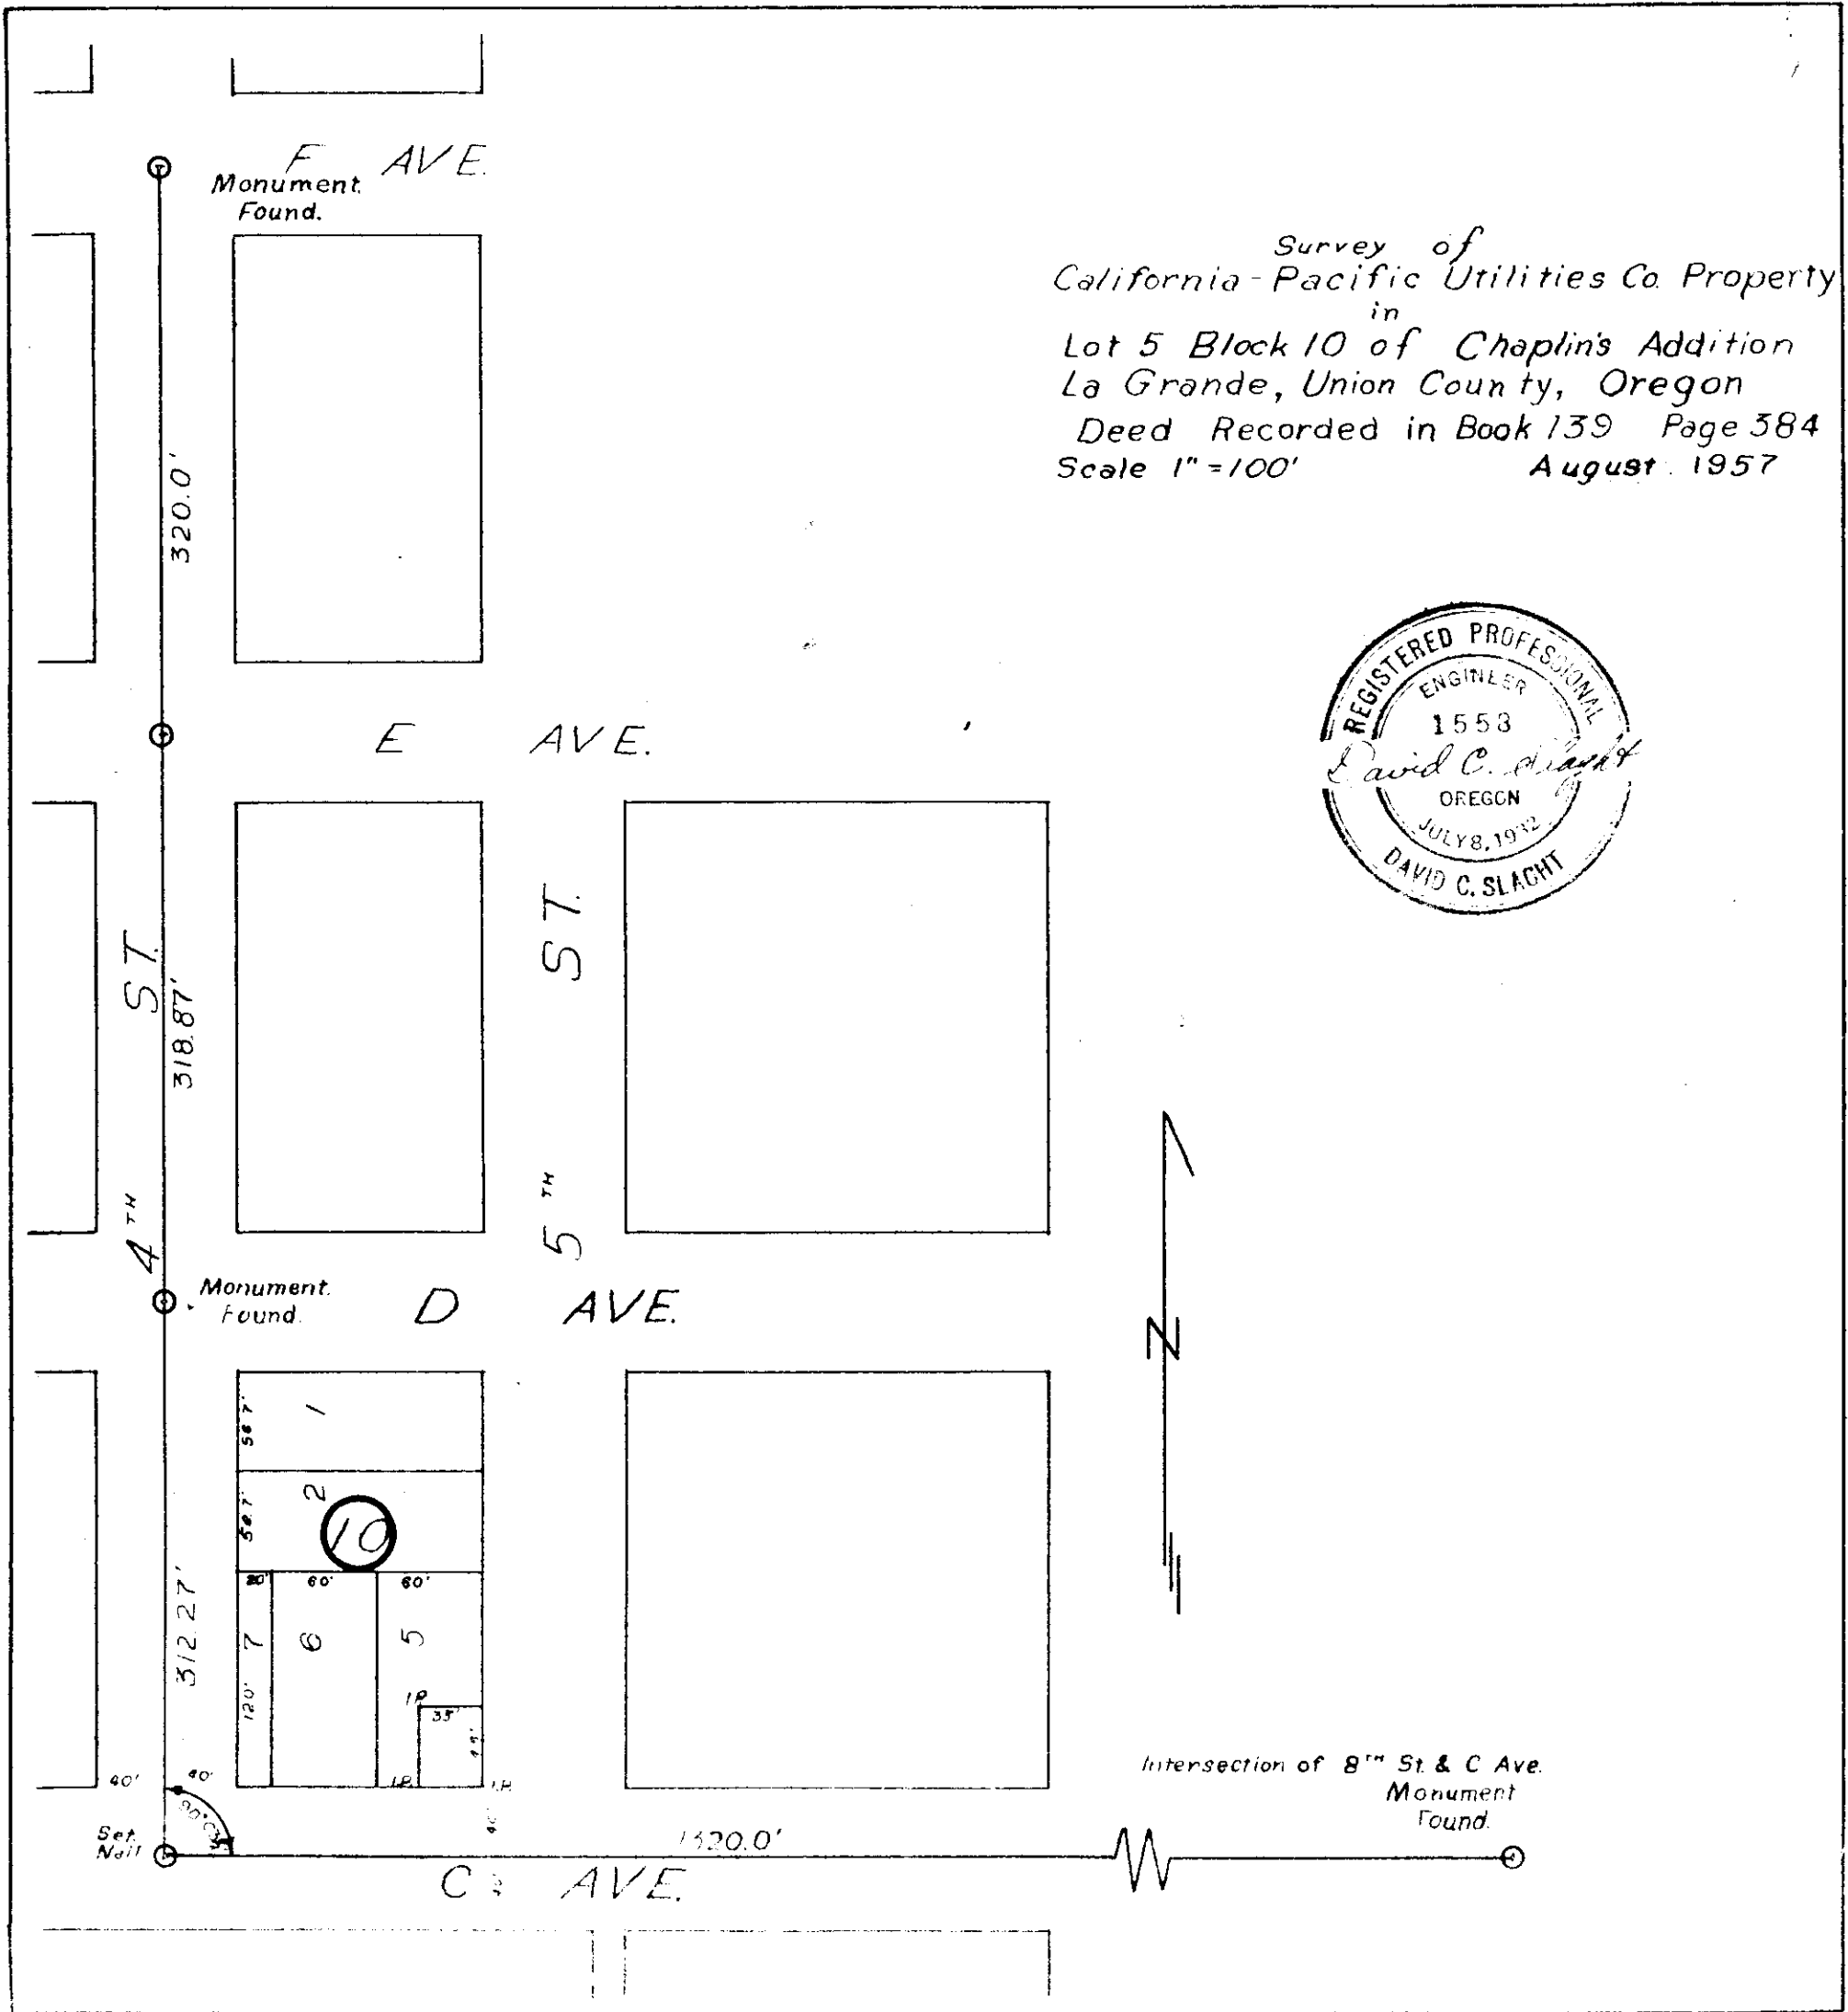

Intersection of 8TH St & C Ave.
 Monument Found.

80-75