


SE 1/4 NW 1/4  
 Section 6, Township 3 South,  
 Range 38 East of

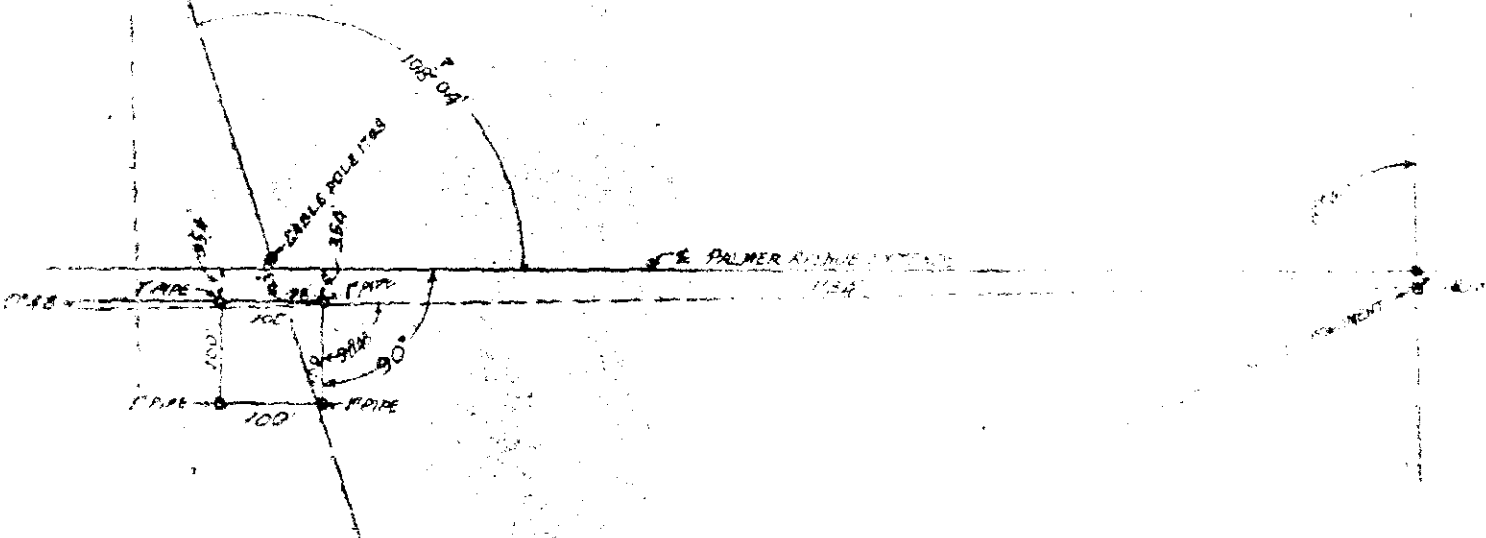

Beginning at a concrete monument which is the southeast corner of the Southeast Quarter of the North West Quarter of Section 6, Township 3 South, Range 38 East of the Willamette Meridian, Union County, Oregon; thence Righty Nine degrees and Forty five Minutes left of the line to the concrete monument at the northeast corner of the said SE 1/4 NW 1/4 section 6, T. 3 S., R. 38 E. W. M.,) and a distance of Eleven Hundred Thirty four (134') feet; thence North and Forty Eight Minutes right, One Hundred feet; thence Ninety (90) degrees left, One Hundred (100') feet; thence Ninety (90) degrees left, One Hundred (100') feet; thence Ninety (90) degrees left, One Hundred (100') feet to the above described point which is Eleven Hundred Thirty four feet westerly from the said southeast corner of the said Southeast Quarter of the Northwest Quarter, section 6, T. 3 S. R. 38 E. W. M., Union County, Oregon, and consisting of a tract of Land One Hundred (100) foot square.

SCALE 1"=200'

DATE APRIL 5, 1941.