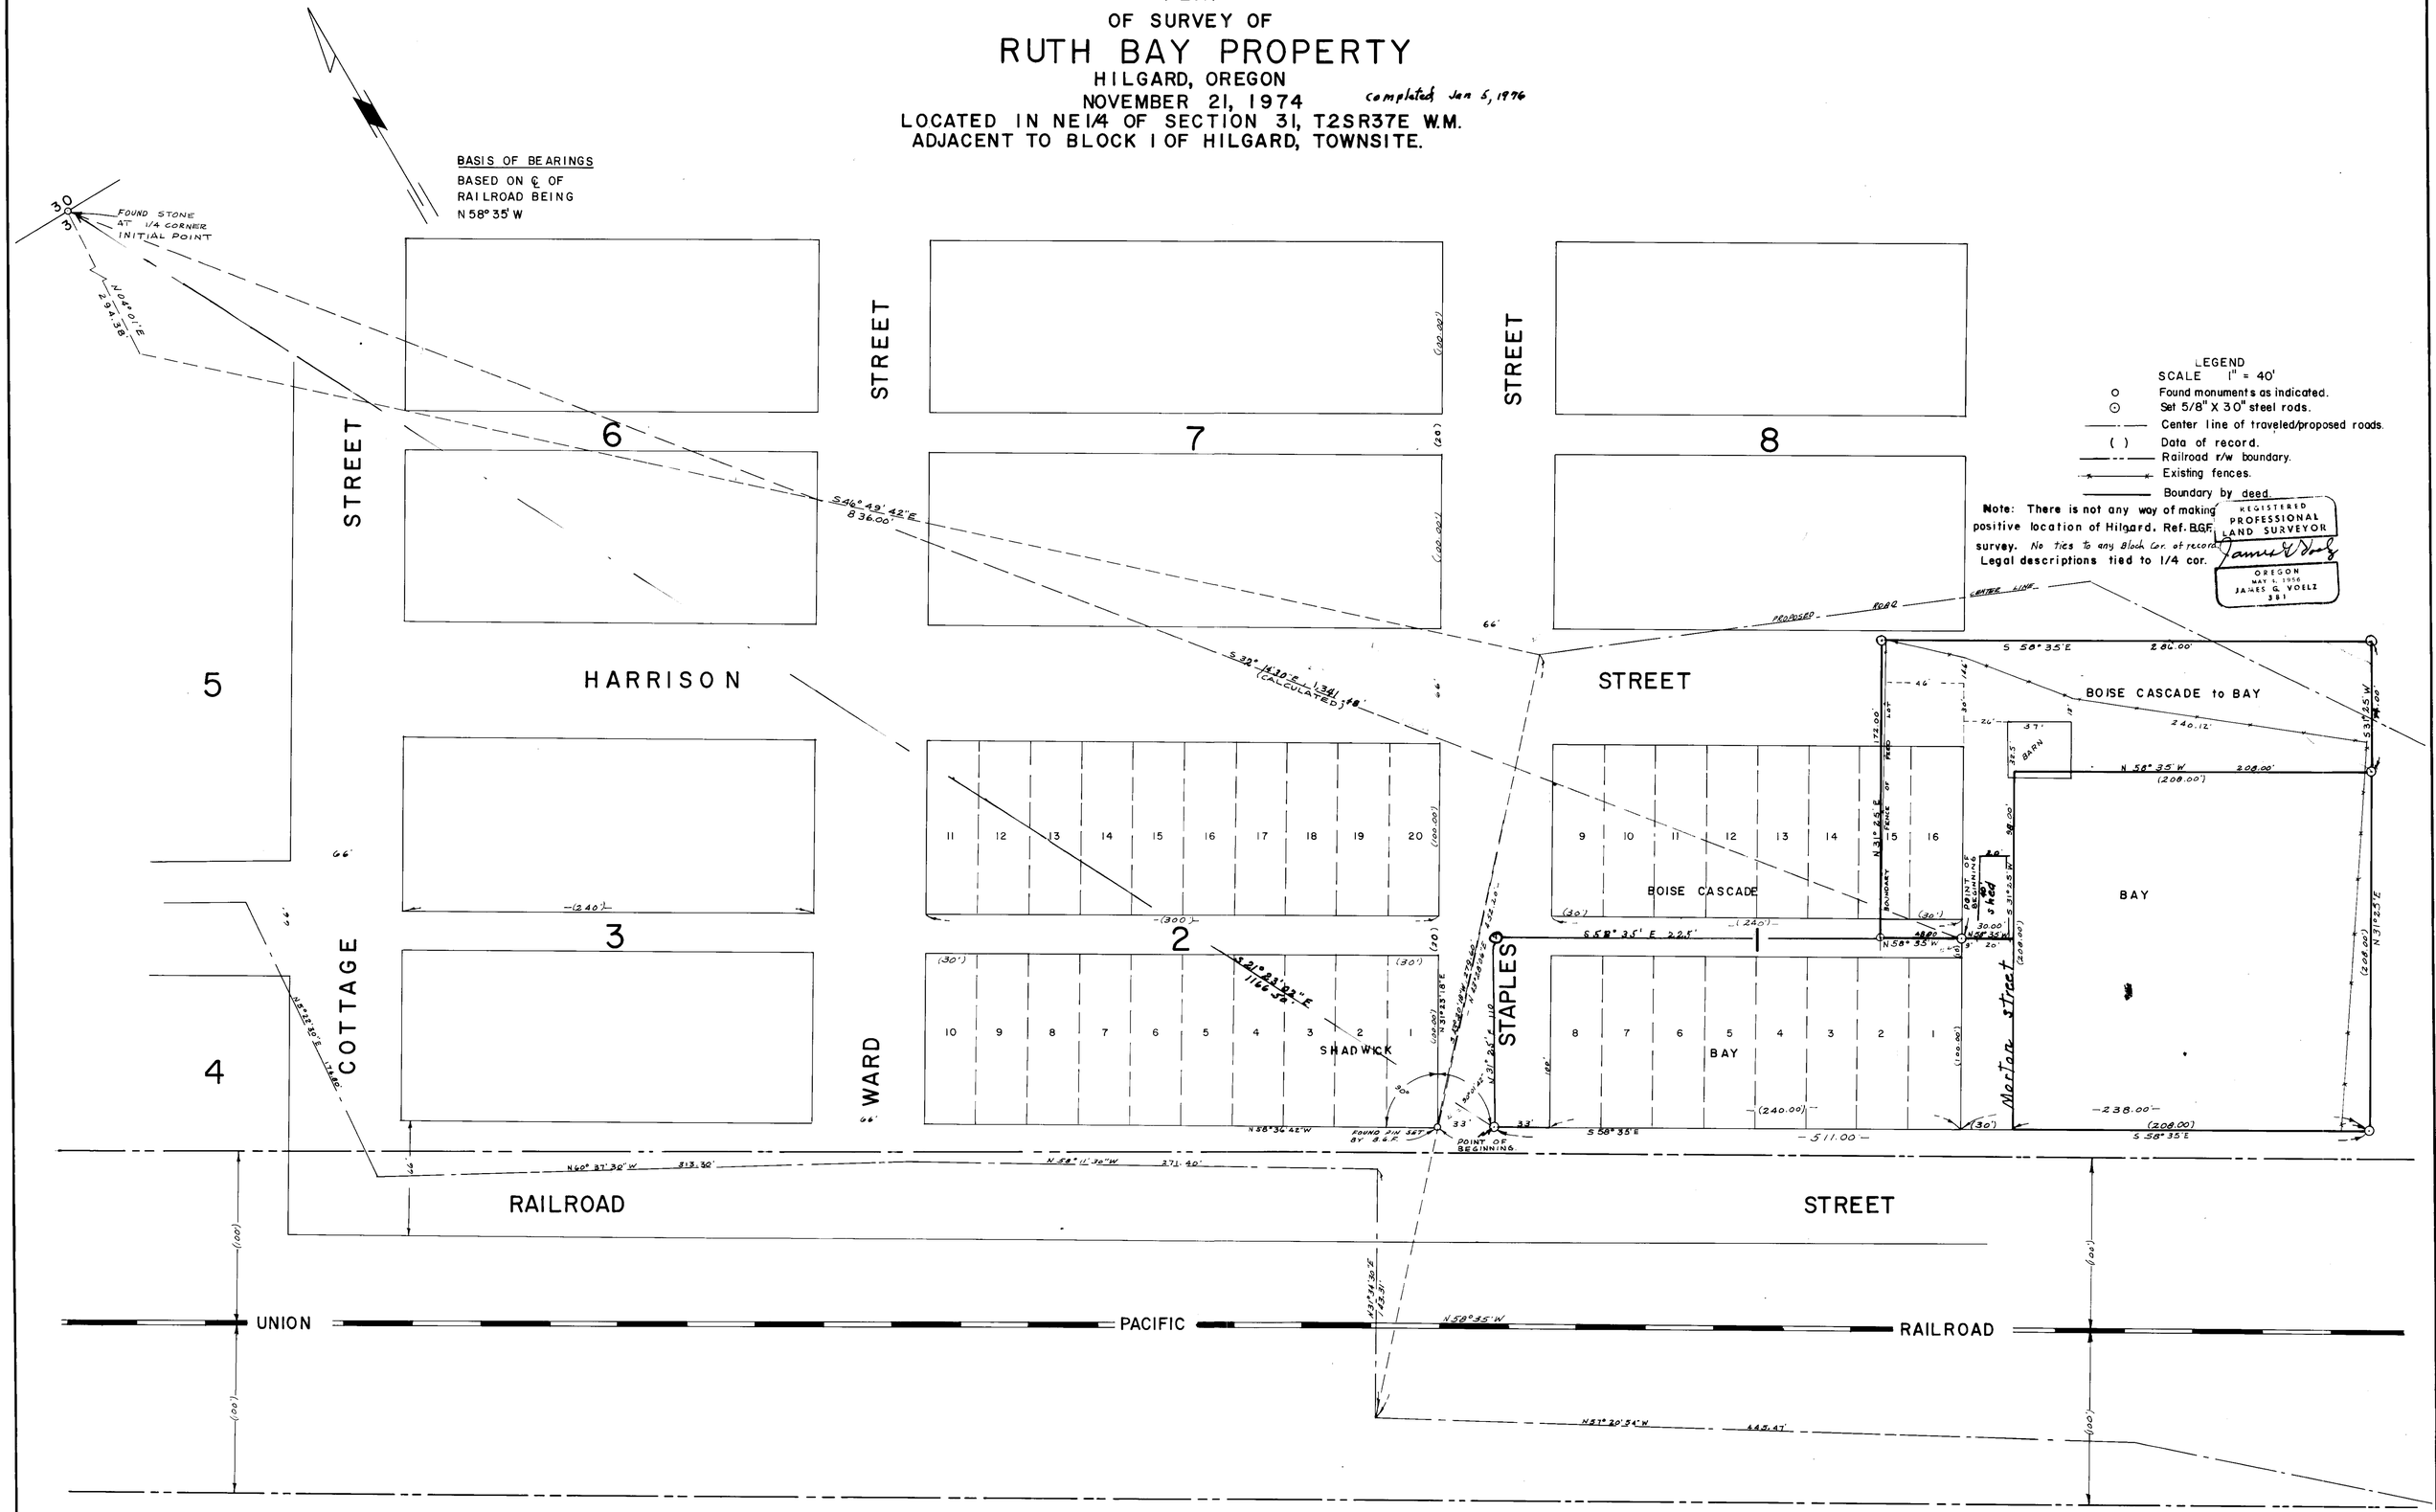# PLAT
## OF SURVEY OF
# RUTH BAY PROPERTY
HILGARD, OREGON
NOVEMBER 21, 1974 completed Jan 5, 1976
LOCATED IN NE1/4 OF SECTION 31, T2SR37E W.M.
ADJACENT TO BLOCK I OF HILGARD, TOWNSITE.