


PROPOSED ROCK PIT SITE

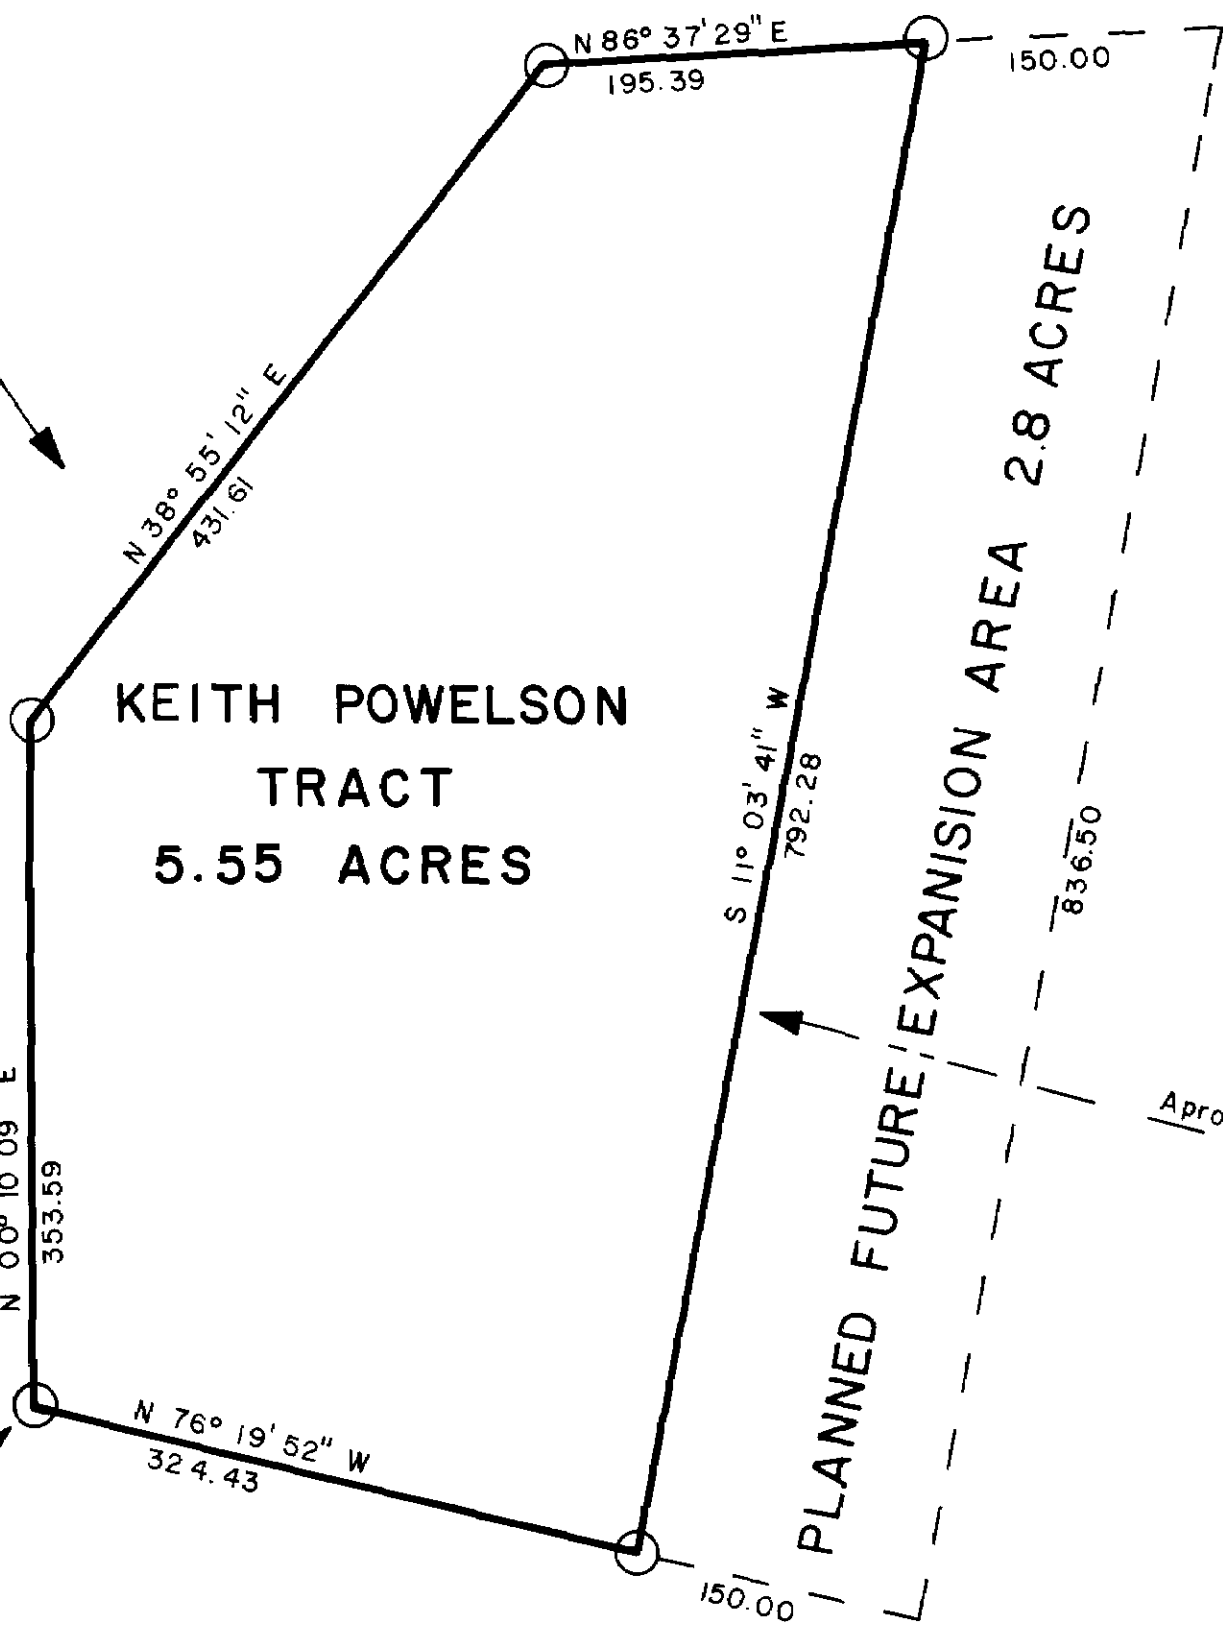

BASIS OF BEARINGS  
SOLAR OBSERVATIONS




RECORD OF SURVEY FOR  
KEITH POWELSON  
OF A TRACT OF LAND IN  
SEC 18, T. 1 N., R. 39 E. W. M.

13/18  
24/5  
S.W. COR. SEC. 18, T. 1 N., R. 39 E. W. M.  
FOUND U. S. F. S. REF. PLAQUE,  
SET 5/8" X 30" IRON ROD

SCALE 1" = 100'

Aprox Dist To County Road 800. Feet.

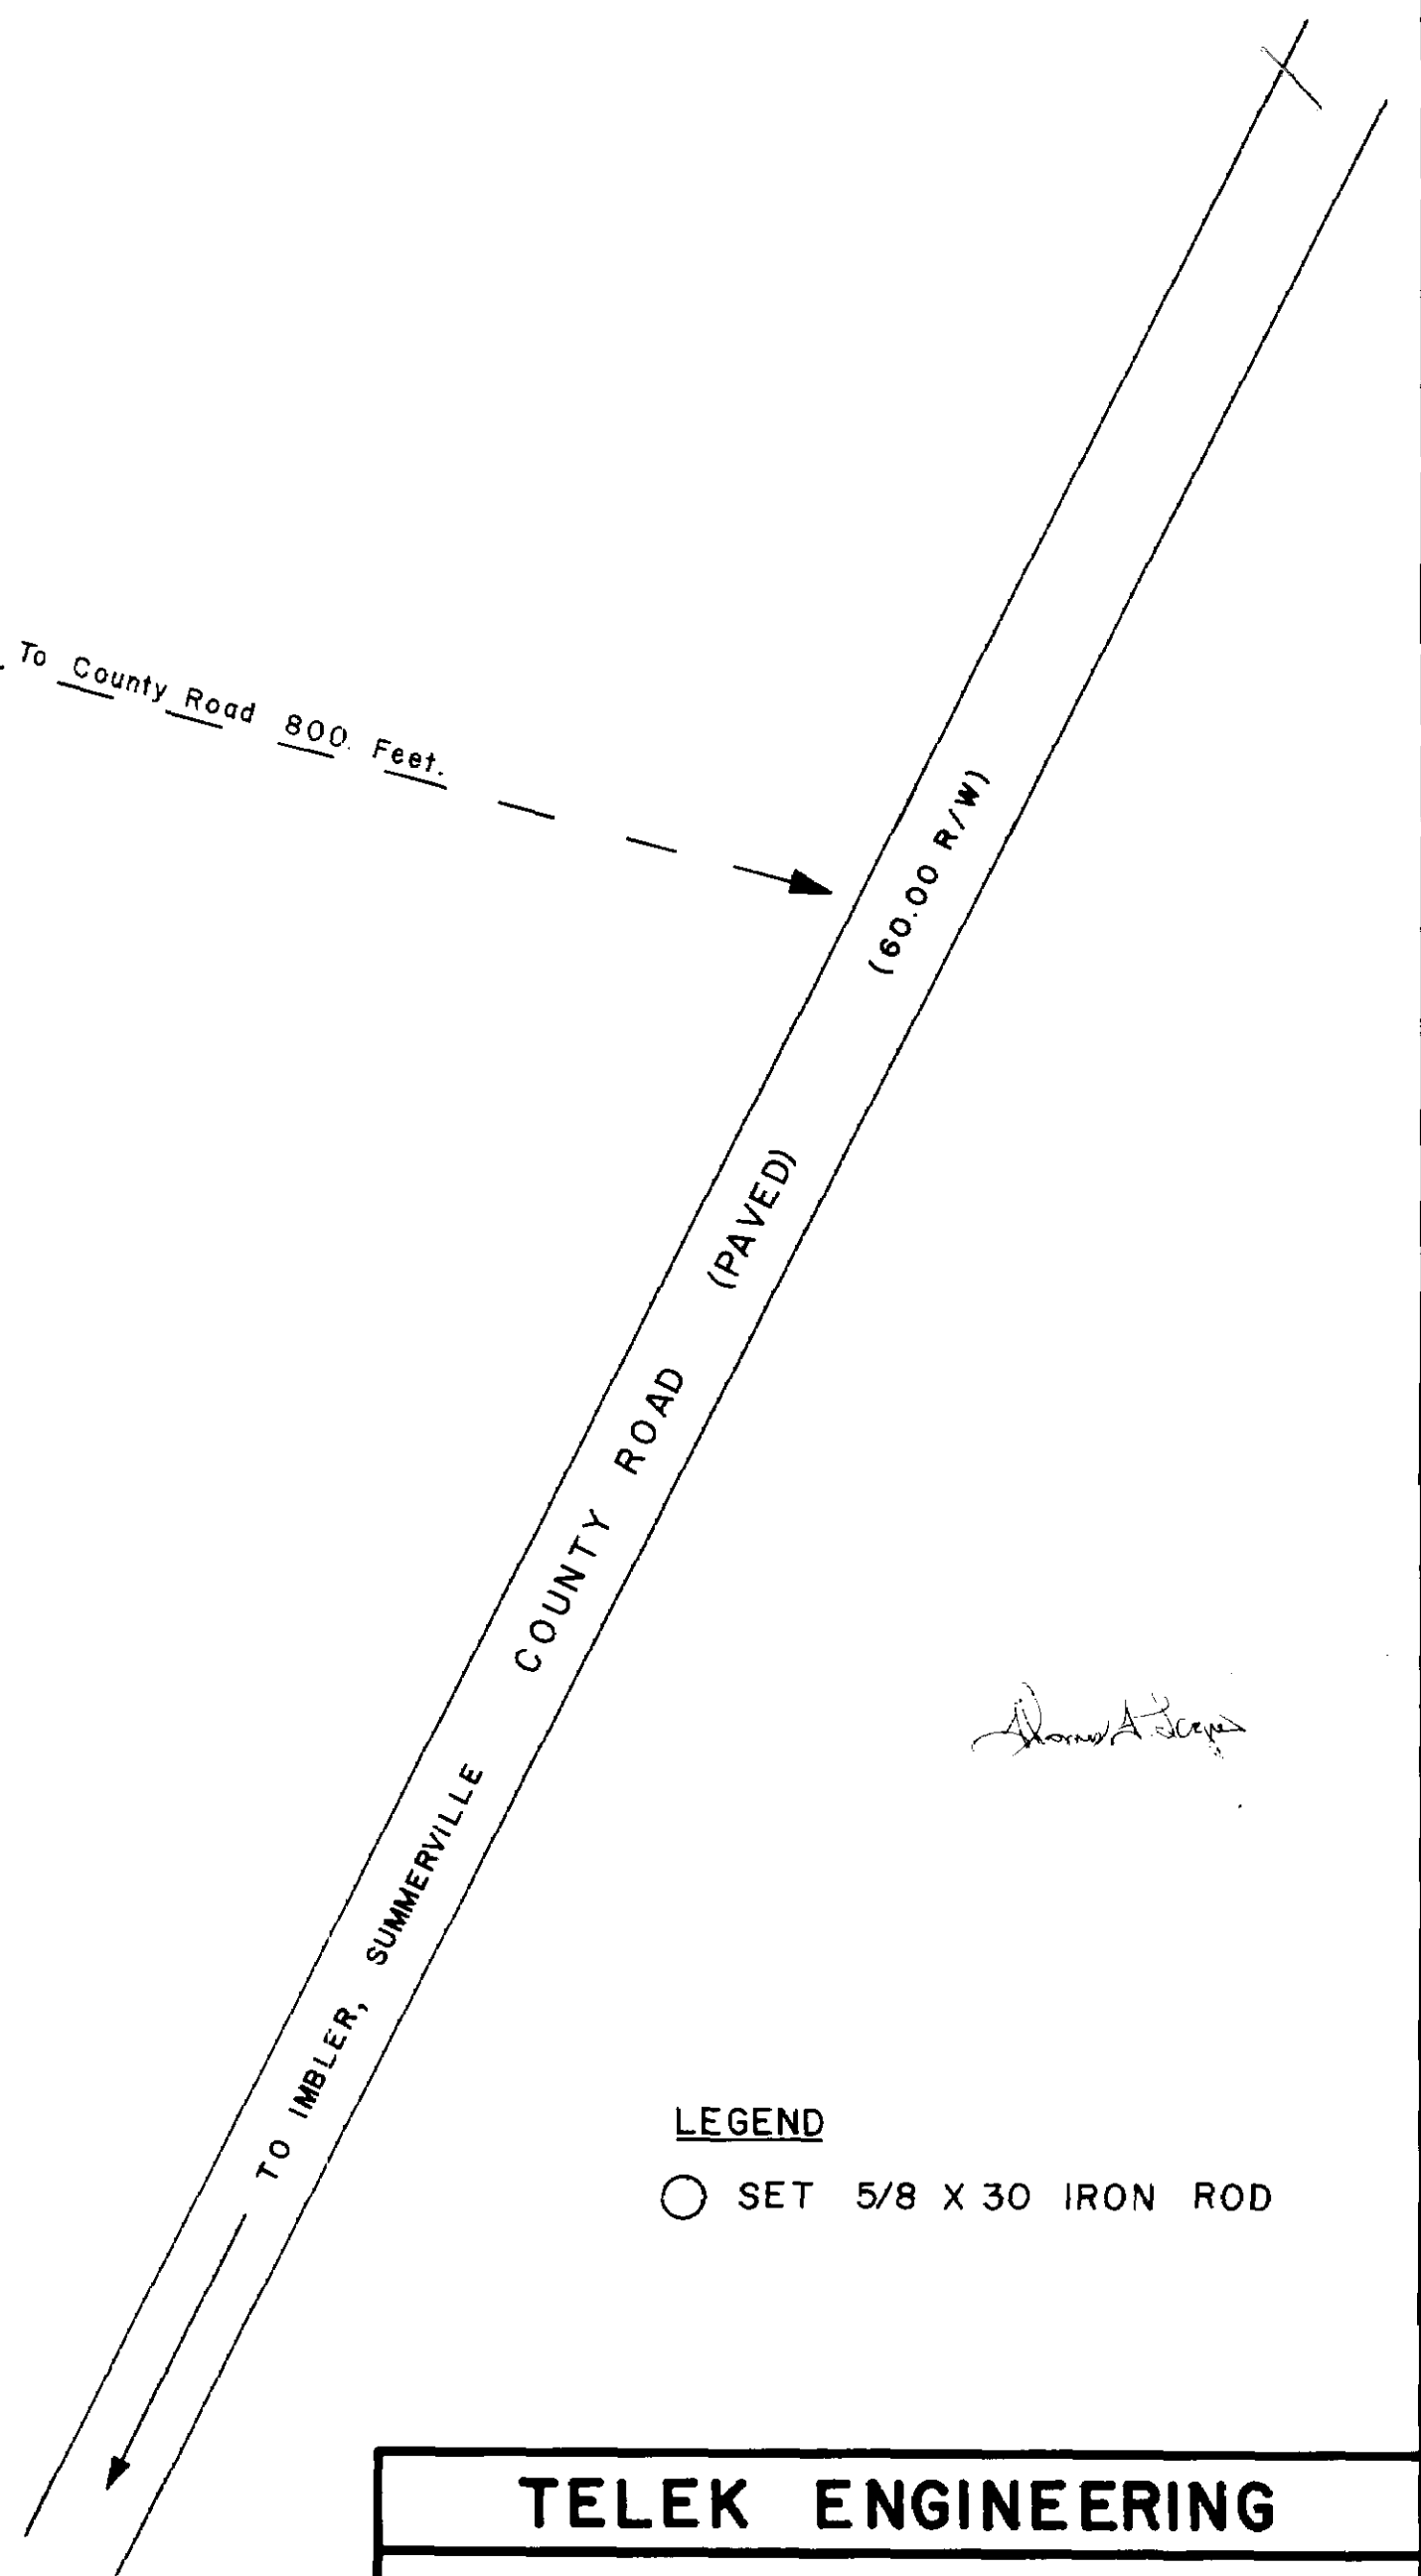

*Handwritten signature*

LEGEND  
○ SET 5/8 X 30 IRON ROD

TELEK ENGINEERING			
RECORD OF SURVEY SEC.18 T.IN. R.39E.			
DATE	25 NOV 75	DRAWN BY	P.L.M.
SCALE	1" = 100'	CK'D BY	T.F.L.
SHEET 1 OF 1		DRAWING NO 75-1	

6-76