

SKETCH MAP: TRACT # 56 (tax lot #1800) of PARK ADDITION TO THE CITY OF LA GRANDE, UNION COUNTY, OREGON

FOR: CHARLES F. AND LINDA C. CREEL

RECORDED U.C.R. DEEDS - MF #53086 to JOHN L. AND EVELYN DUPUIS, owners.



Date: March 23, 1976

Scale: 1" = 100'

Basis of Bearings and measurements: TRUE, from former survey and re-established corners of lot #24 of said Addition as shown.

Filed: County Surveyor, March 23, 1976

Prepared by Eastern Oregon Land Surveys

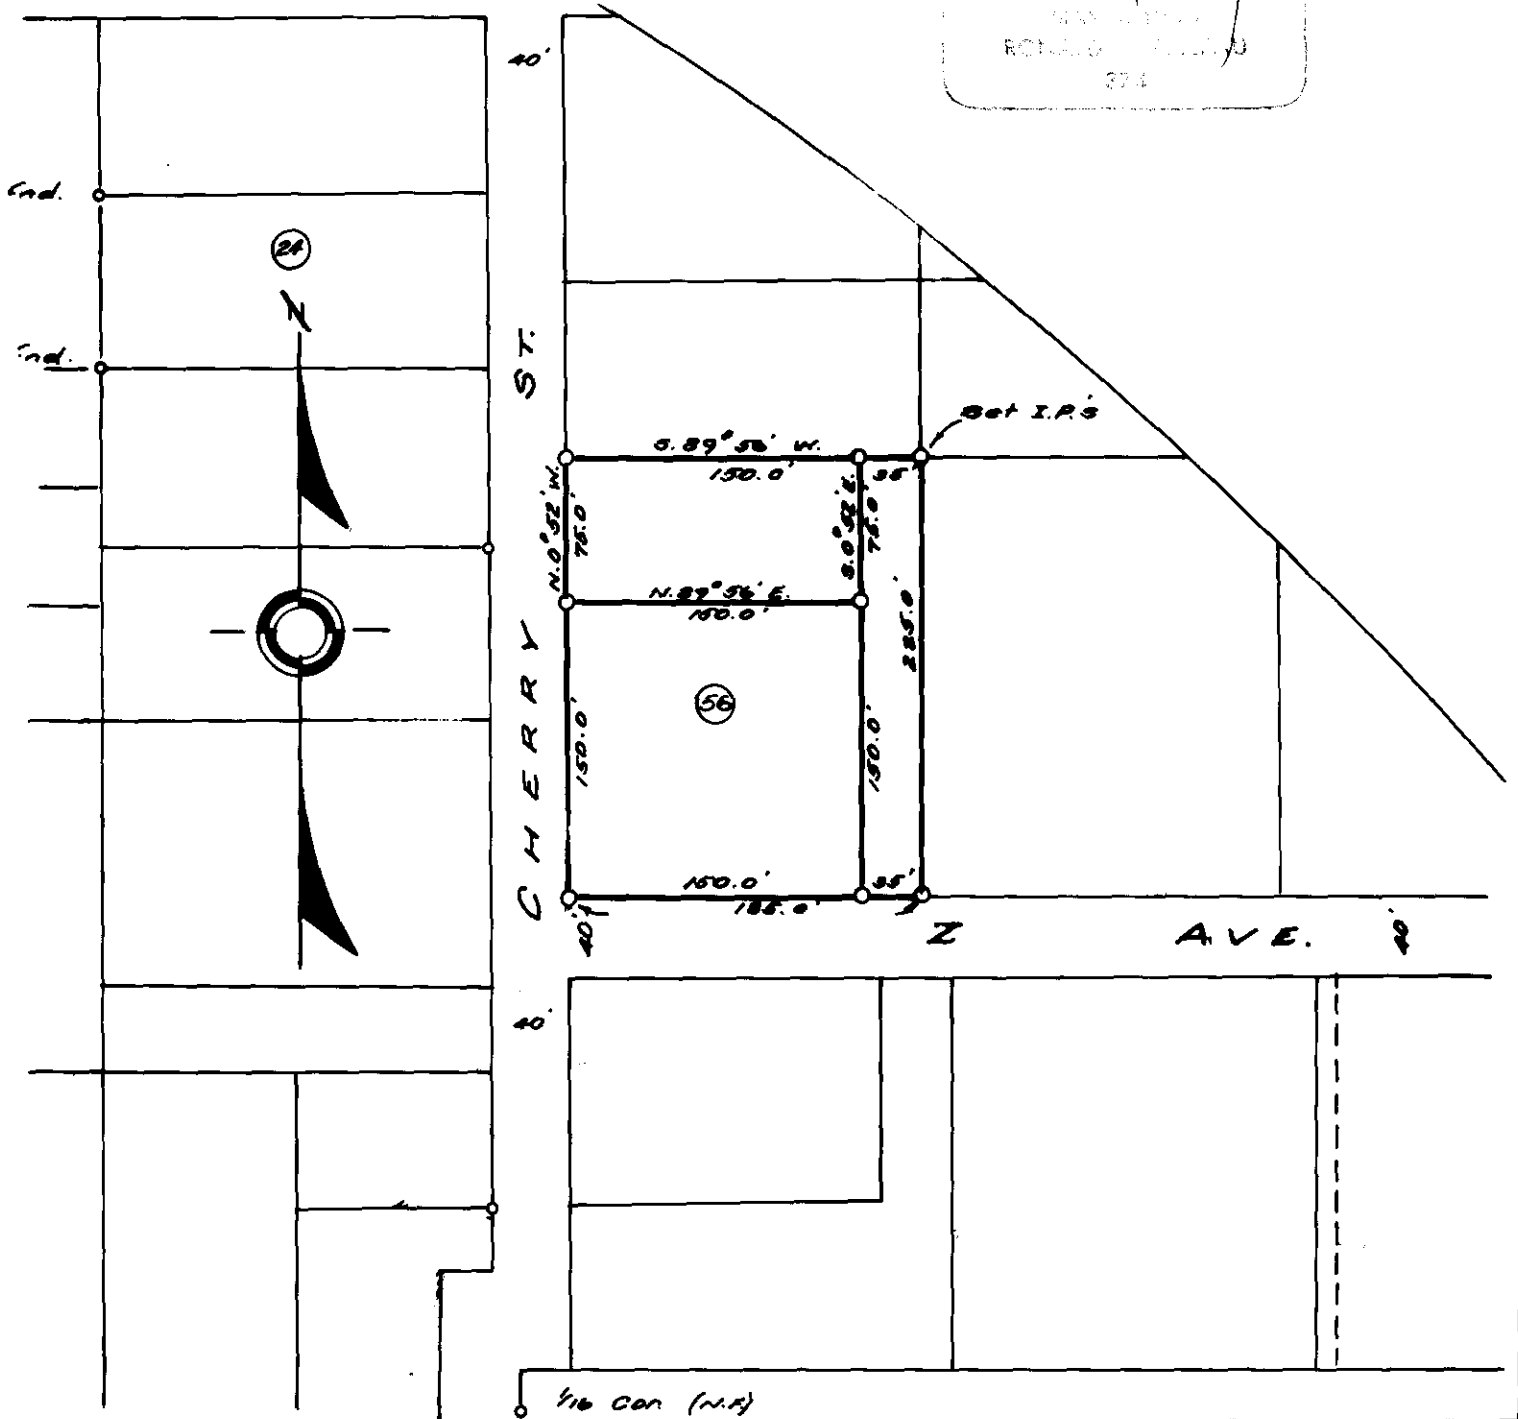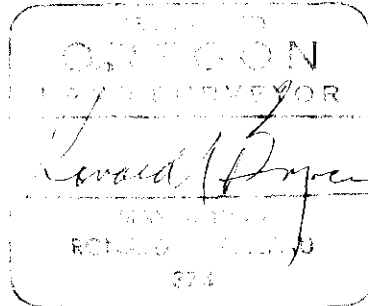

8-76