


- LEGEND**
- ▲ FND. MONUMENTS OF RECORD
  - SET 5/8" REBAR
  - FND. 1/2" RODS
  - SET P.K. NAILS

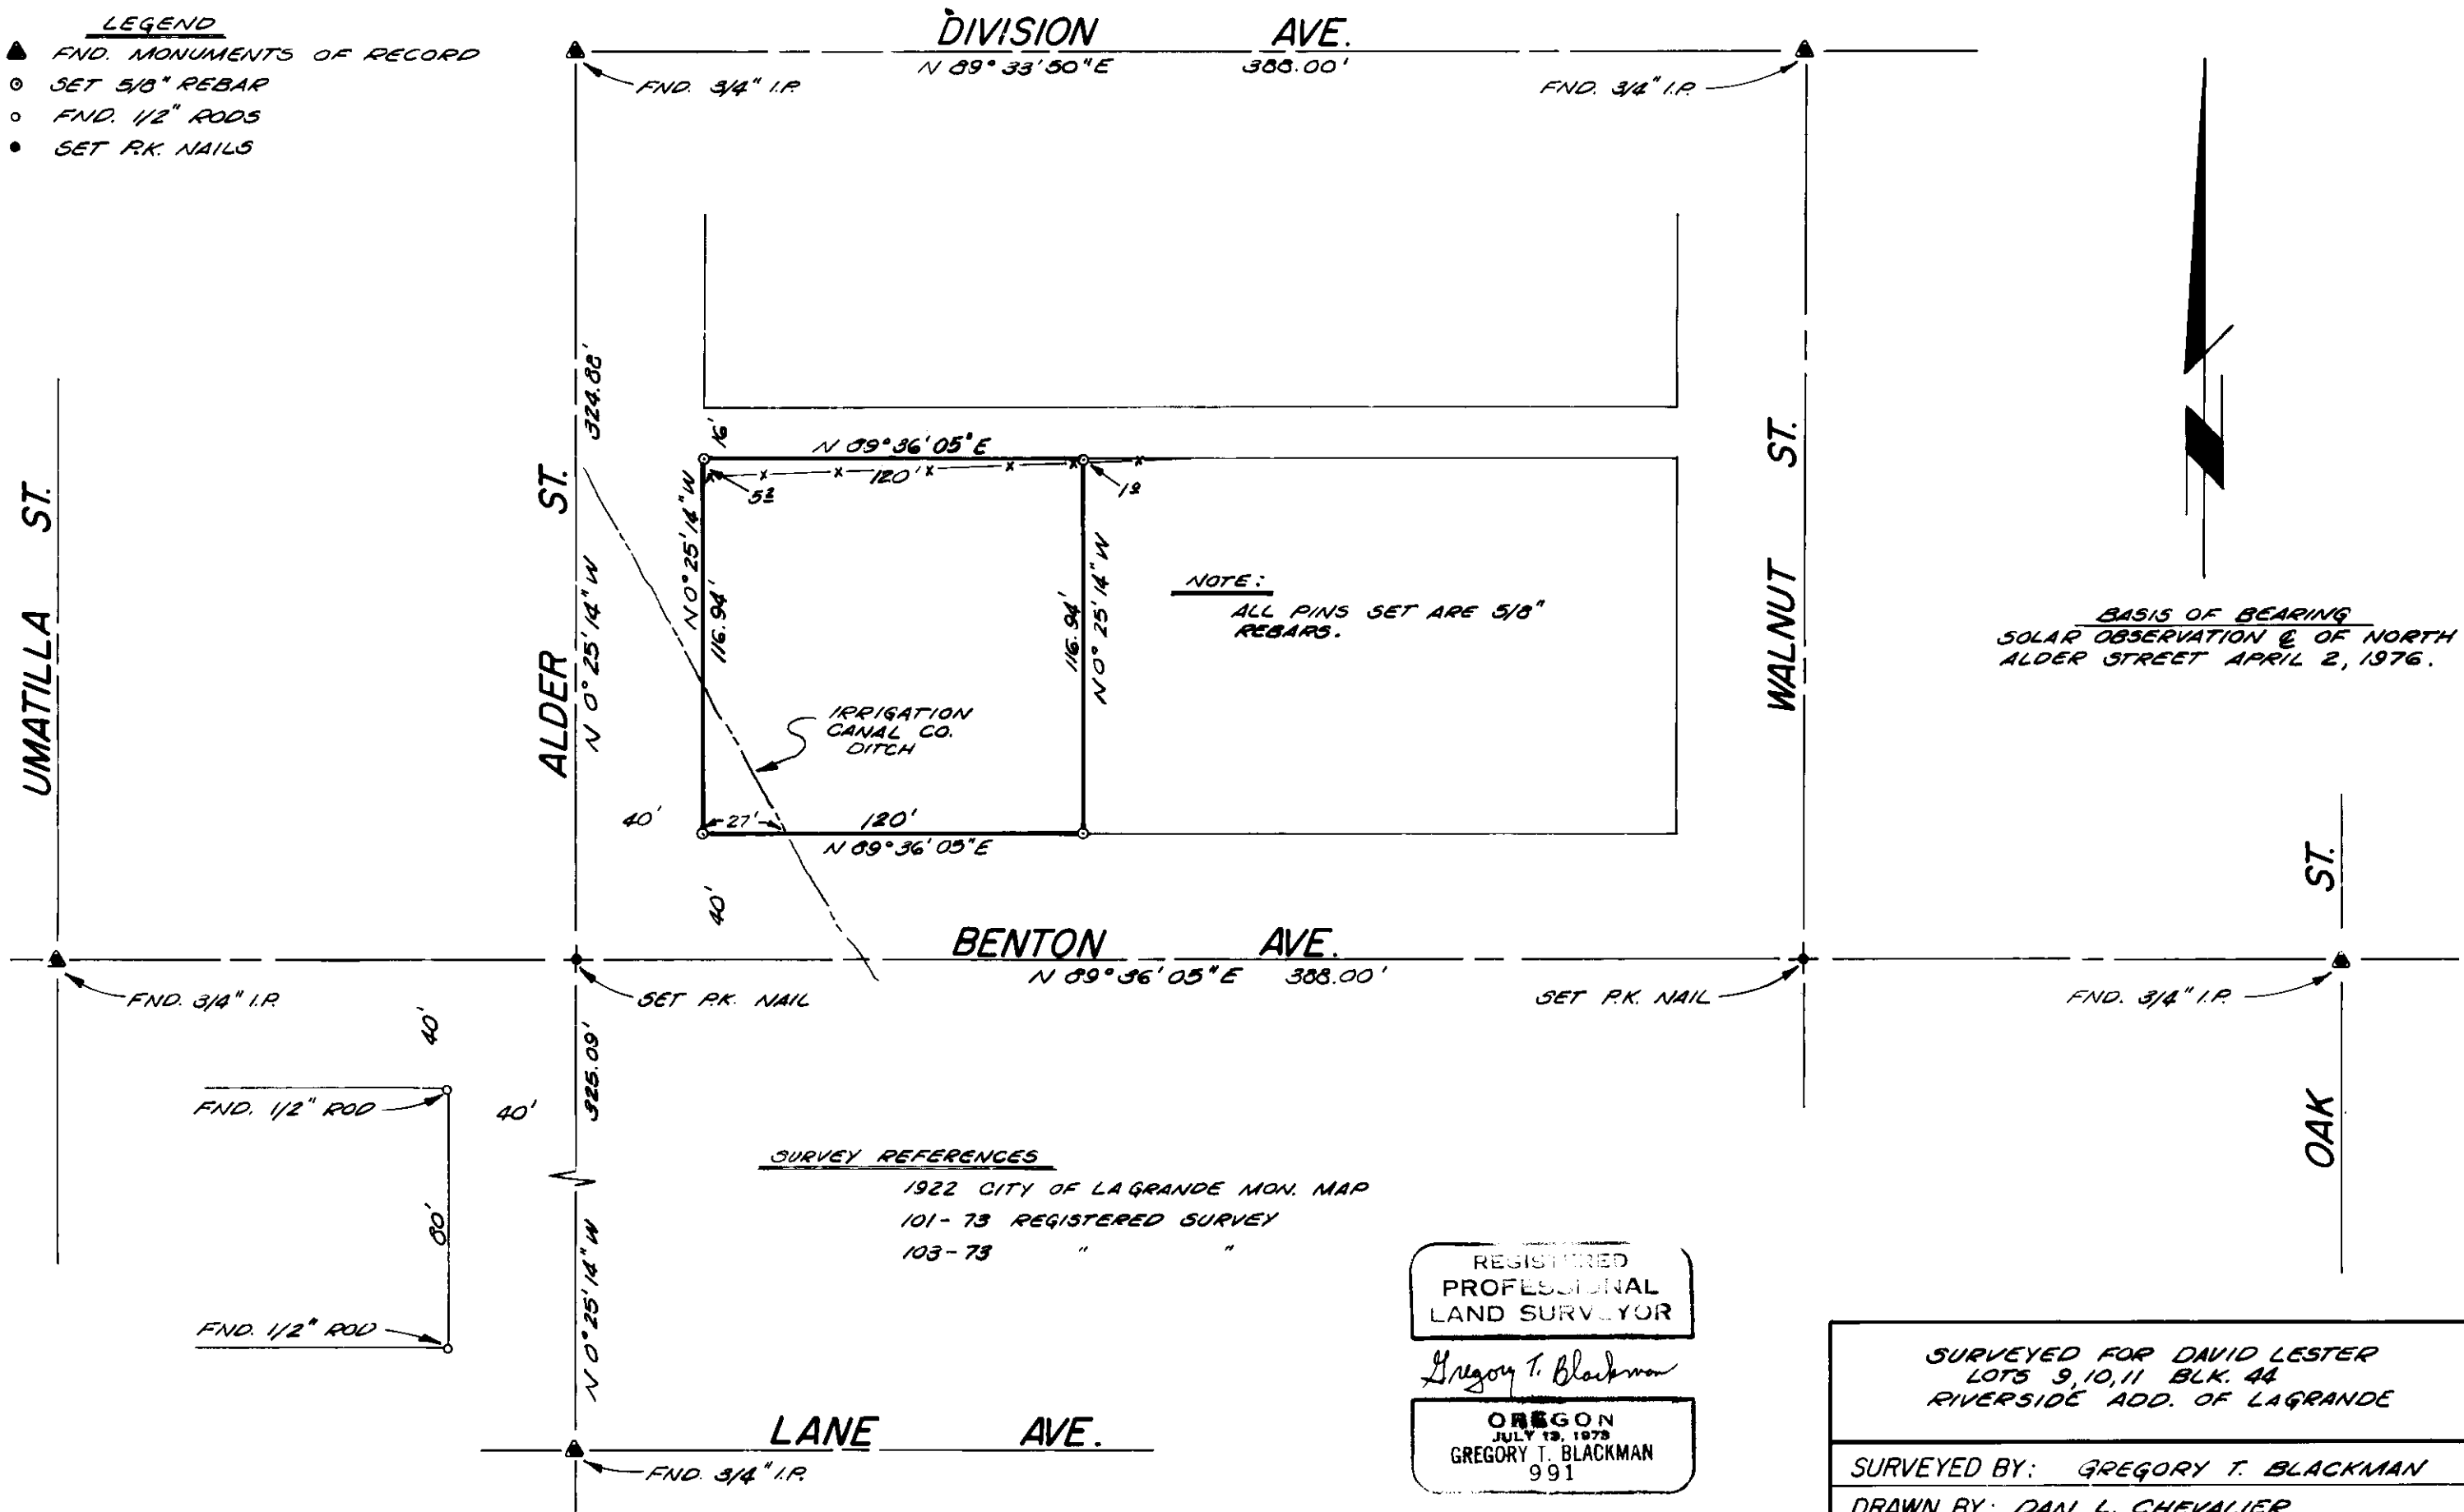

**BASIS OF BEARING**  
 SOLAR OBSERVATION E OF NORTH  
 ALDER STREET APRIL 2, 1976.

REGISTERED  
 PROFESSIONAL  
 LAND SURVEYOR

*Gregory T. Blackman*

OREGON  
 JULY 19, 1973  
 GREGORY T. BLACKMAN  
 991

SURVEYED FOR DAVID LESTER LOTS 9,10,11 BLK. 44 RIVERSIDE ADD. OF LA GRANDE	
SURVEYED BY: GREGORY T. BLACKMAN	
DRAWN BY: DAN L. CHEVALIER	
SCALE 1" = 50'	DATE: 4-5-76