
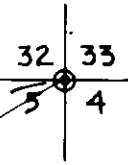



REFERENCES

SURVEY - 2-1973
 SURVEY -39-1972

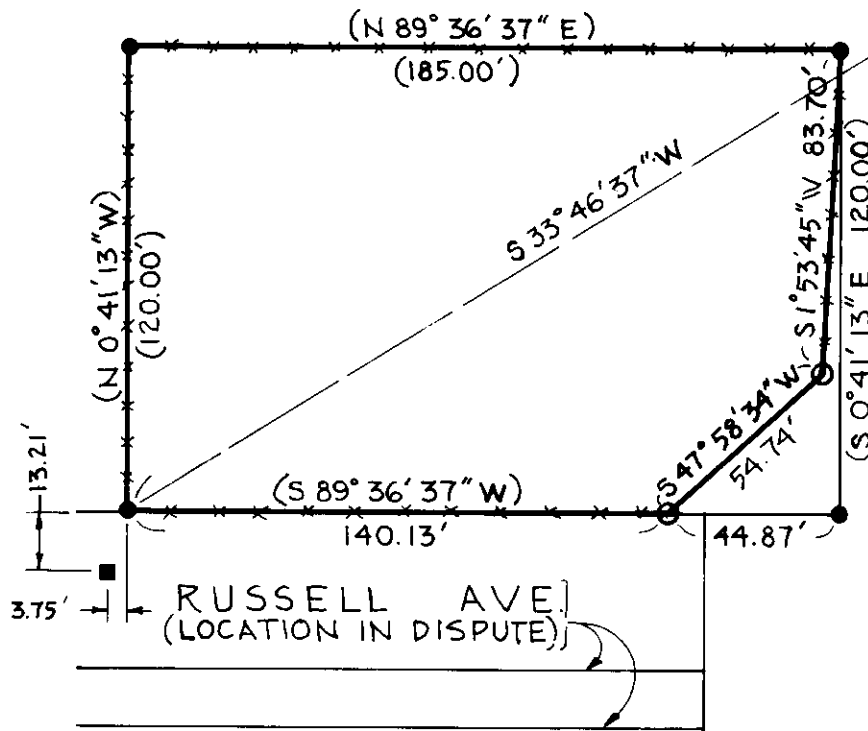


LEGEND

- FOUND 5/8" PIN, SURVEY 2-1973
- FOUND PIN, SURVEY 39-1972
- SET 5/8" x 30" PIN
- ⊙ FOUND SECTION CORNER
- () RECORD BEARING AND DISTANCE
- EXISTING FENCE

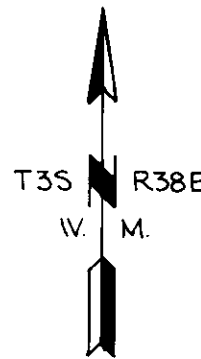

BASIS OF BEARING
 SURVEY 2-1973

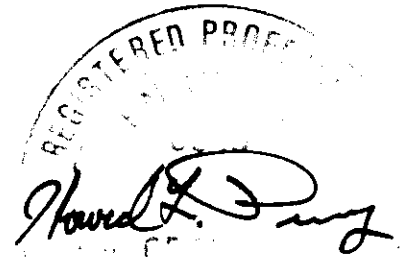

**LOT D PARK ADDITION
 TO LA GRANDE**

FOR: FRANK LOVELY & MIKE RUTH

SCALE
 1" = 50'
 DATE
 4/8/76

**ANDERSON · PERRY
 & ASSOCIATES, INC.**

ENGINEERING SURVEYING AND MATERIALS TESTING
 LA GRANDE & ENTERPRISE, OREGON

SHEET NO
 1