



**BASIS OF BEARING**

FORWARD BEARING AS PUBLISHED BY U.S.C. & G.S. FROM Δ COLLEGE TO A VALLEY.

**REFERENCE MATERIAL**


SURVEY # 7-67  
# 36-71  
# 1-73  
# 65-73

**DEED DESCRIPTION**

BOOK	PAGE	617
154	126	500
103	118	488
85	92	291
		232
		172

**LEGEND**

- FOUND MONUMENT OF RECORD
- SET 5/8" X 30" IRON PIN
- FOUND UNRECORDED 3/4" PIPE
- ( ) RECORD BEARING & DISTANCE IF OTHER THAN TRUE
- EXISTING FENCE LINE

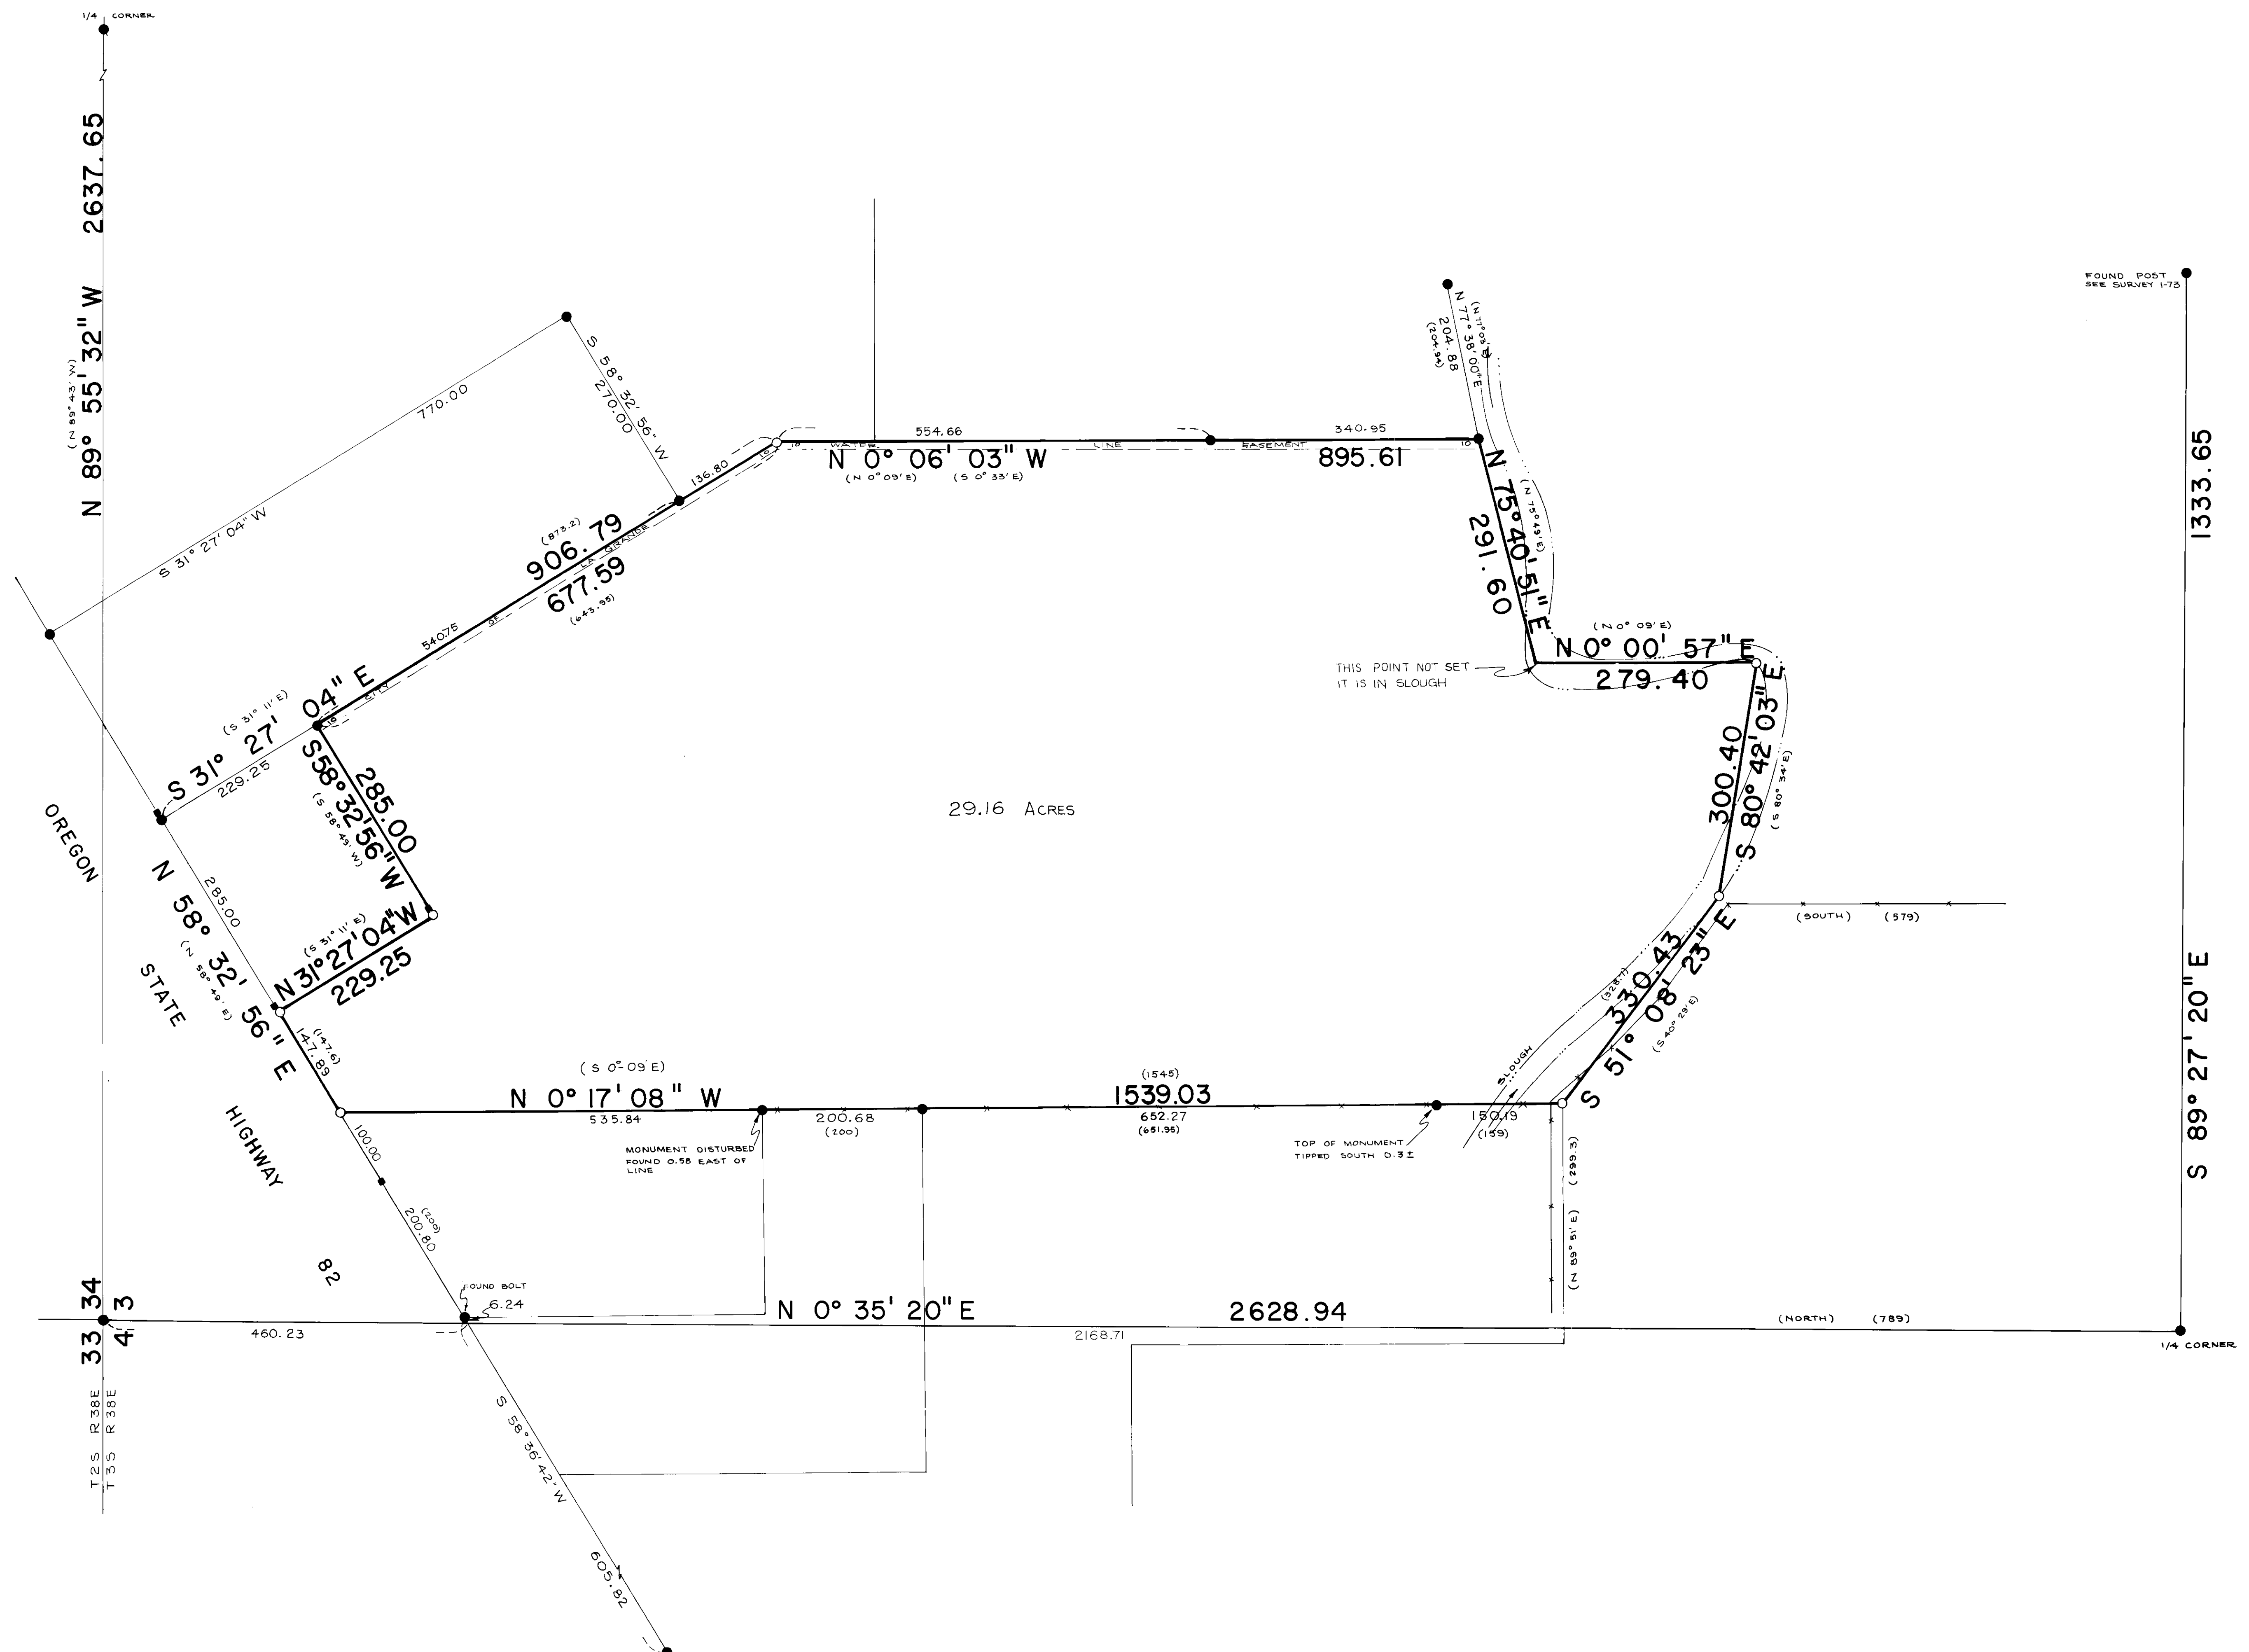

29.16 ACRES

REGISTERED  
PROFESSIONAL  
LAND SURVEYOR  
*Duane L. Griffith*  
OREGON  
MAY 16, 1961  
DUANE L. GRIFFITH  
644

<b>BAGETT, GRIFFITH &amp; ASSOCIATES</b> La Grande, Oregon		
Map of Survey		
A PARCEL IN THE NW 1/4 SECTION 3 T 3S R 38E W.M.		
UNION COUNTY, OREGON		
SURVEYED FOR	RUSSELL HIATT	
SURVEYED BY	D. I. G.	4 - 1976
Scale: 1" = 100'	Drawn by: t.d.g.	4 - 1976