PLAT
of survey for

DEWAYNE PFEASTER

1806 'X' AVENUE
LA GRANDE OREGON 97850

IN LOTS 2 & 3 BLOCK 2 of PLEASANT HOME ADDN. (1902)

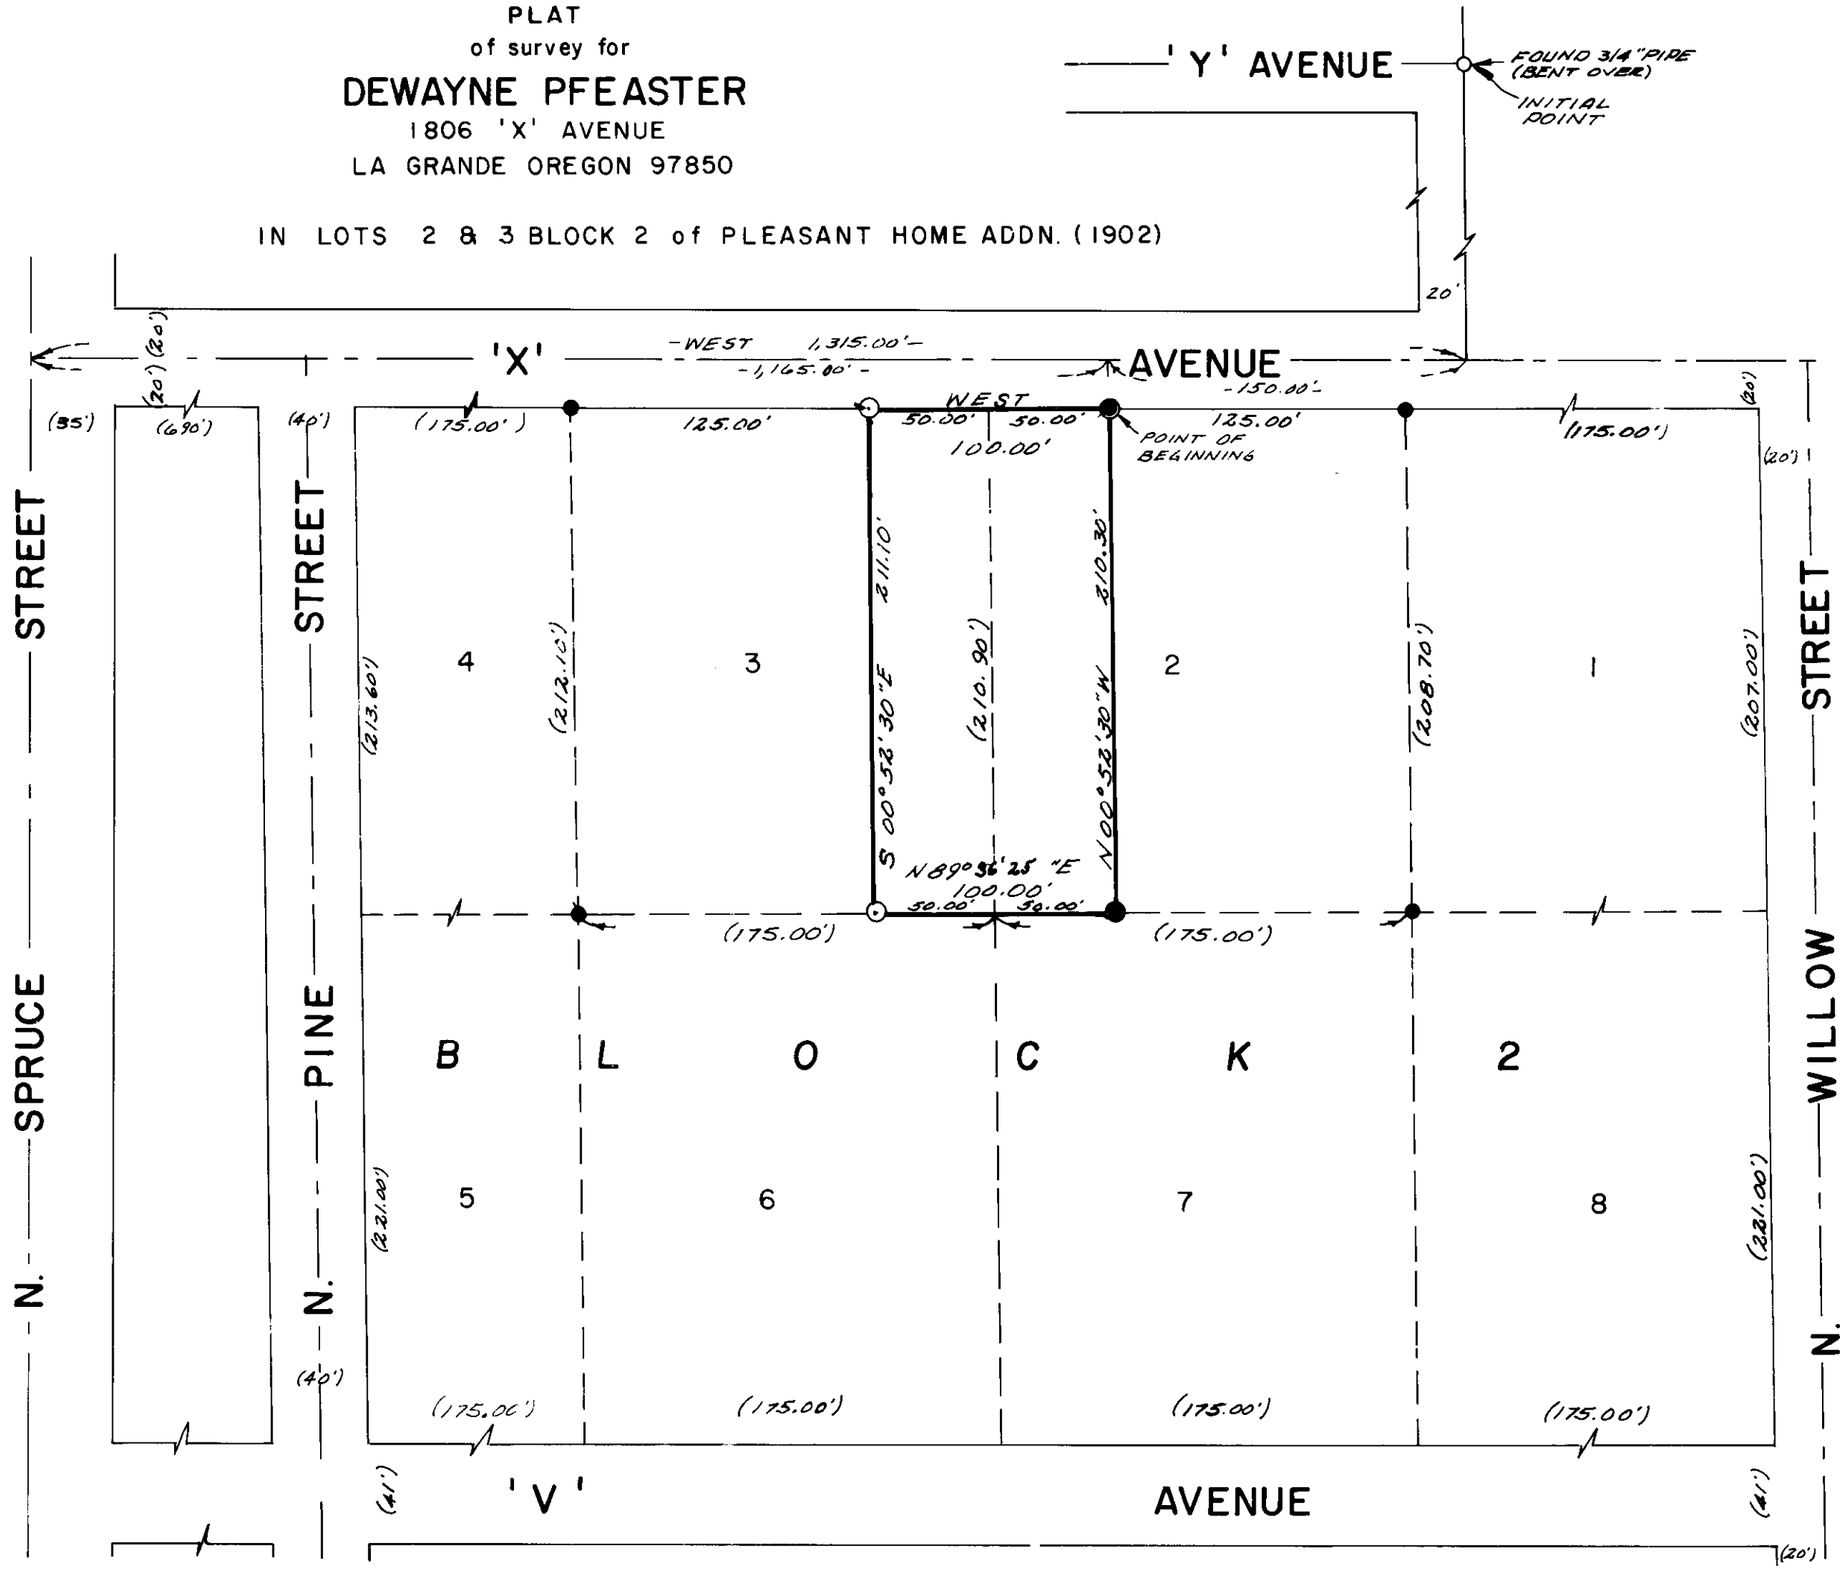

LEGEND

- ● Rods set from previous surveys.
- ○ Found monuments.
- ⊙ Set 5/8" X 30" steel rods.
- —·— Street center lines.
- ( ) Data of record.

BASIS OF BEARINGS
BASED ON ℄ OF 'X' AVE. BEING WEST.

James G. Voelz

SURVEYED BY	
VOELZ LAND SURVEYING, INC.	
SURVEYED FOR	
DEWAYNE PFEASTER	
DATE	SCALE
MAY 13, 1976	1" = 60'

31-76