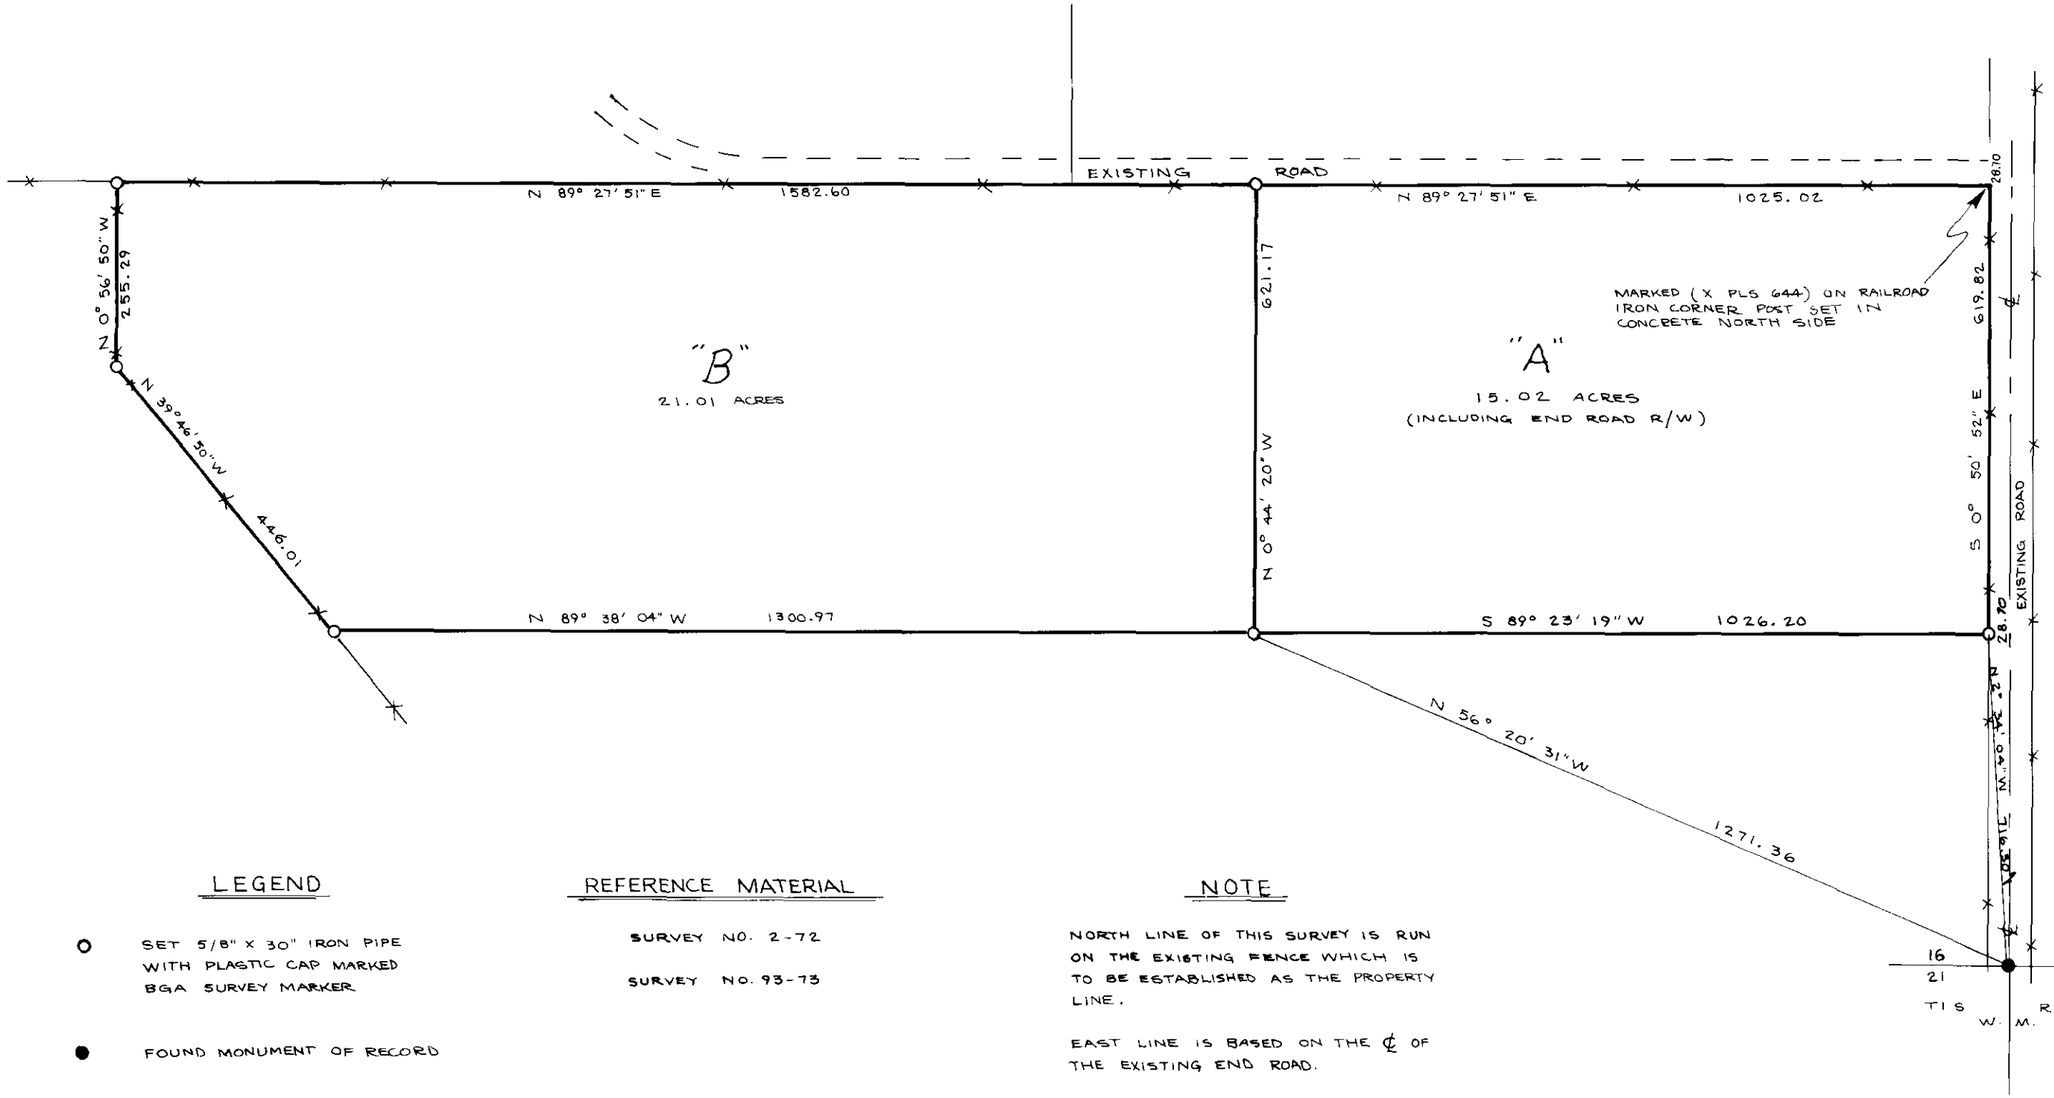

BASIS OF BEARING

SOLAR OBSERVATIONS

LEGEND

- ○ SET 5/8" X 30" IRON PIPE WITH PLASTIC CAP MARKED BGA SURVEY MARKER
- ● FOUND MONUMENT OF RECORD
- —x—x— EXISTING FENCE LINE

REFERENCE MATERIAL

SURVEY NO. 2-72

SURVEY NO. 93-73

NOTE

NORTH LINE OF THIS SURVEY IS RUN ON THE EXISTING FENCE WHICH IS TO BE ESTABLISHED AS THE PROPERTY LINE.

EAST LINE IS BASED ON THE ℄ OF THE EXISTING END ROAD.

REGISTERED PROFESSIONAL LAND SURVEYOR

OREGON
JULY 10, 1944
DUANE I. GRIFFITH
644

BAGETT, GRIFFITH & ASSOCIATES
La Grande, Oregon

Map of Survey

PARCELS IN THE S 1/2 OF SECTION 16 T1S, R38E W. M.

UNION COUNTY, OREGON

SURVEYED FOR	ROBERT T. OPIE	
SURVEYED BY	D. I. G.	JULY, 1976
Scale: 1" = 200'	Drawn by: t.d.g.	JULY, 1976

38-76

38-76