




BASIS OF BEARING  
SOLAR OBSERVATION

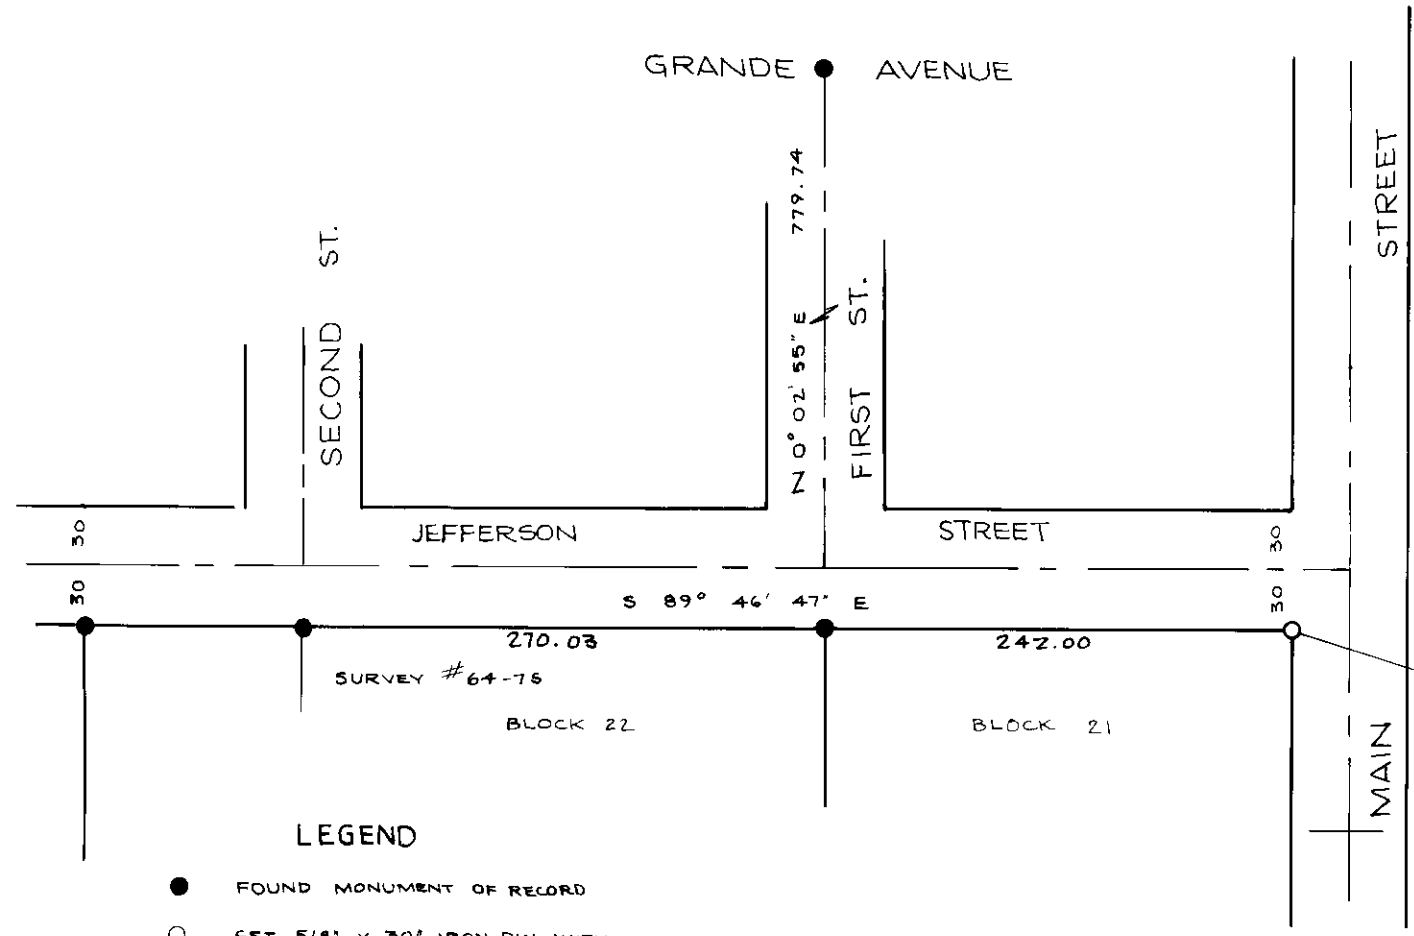

LEGEND

- FOUND MONUMENT OF RECORD
- SET 5/8" X 30" IRON PIN WITH PLASTIC CAP MARKED BGA SURVEY MARK

REFERENCE MATERIAL

- SURVEY NO. 64-75
- SURVEY NO. 67-71

REGISTERED  
**PROFESSIONAL  
LAND SURVEYOR**

*Duane L. Griffith*

**OREGON**  
JULY 10, 1944  
**DUANE L. GRIFFITH**  
644

**BAGETT, GRIFFITH & ASSOCIATES**

La Grande, Oregon

Map of Survey

ESTABLISH NE CORNER  
OF  
LOT 21 OF HANNAH'S ADD.  
UNION  
UNION COUNTY, OREGON

|                |                  |            |
|----------------|------------------|------------|
| SURVEYED FOR   | RUSS LESTER      |            |
| SURVEYED BY    | D.I.G.           | JULY, 1976 |
| Scale: 1"=100' | Drawn by: t.d.g. | JULY, 1976 |

42-76