


**BASIS OF BEARING**  
 SOUTH LINE OF SECTION  
 BEING S. 89° 34' W ESTABLISHED  
 BY G.L.O. AS RECORDED ON  
 SURVEY NO. 111-73

REFERENCE MATERIAL	
COUNTY SURVEYS	
84-74	
4-71	
111-73	
66-72	
68-72	
65-75	
RECORD DEEDS	
MICROFILM DOC. NO.	46278
	44844
	49408
	48719

- LEGEND**
- FOUND MONUMENT OF RECORD
  - SET 5/8" PIN
  - SET 1/2" PIN
  - ( ) RECORDED DATA

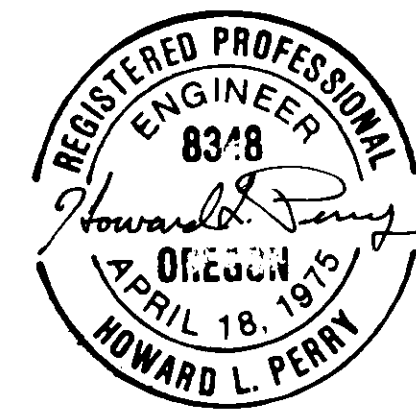

<b>PROPERTY SURVEY</b>		
SECTION 9, T.1S., R.38E., W.M.		
FOR: BILL BREAM		
SCALE 1" = 200'	<b>ANDERSON · PERRY &amp; ASSOCIATES, INC.</b> <small>ENGINEERING, SURVEYING, AND MATERIALS TESTING</small>	SHEET NO. 1
DATE NOV. 1976		LA GRANDE & ENTERPRISE, OREGON

5576