



PLAT
of survey for
IMBLER RURAL FIRE PROTECTION DISTRICT
IMBLER OREGON

IN BLOCK 24 OF THE TOWNSITE OF IMBLER

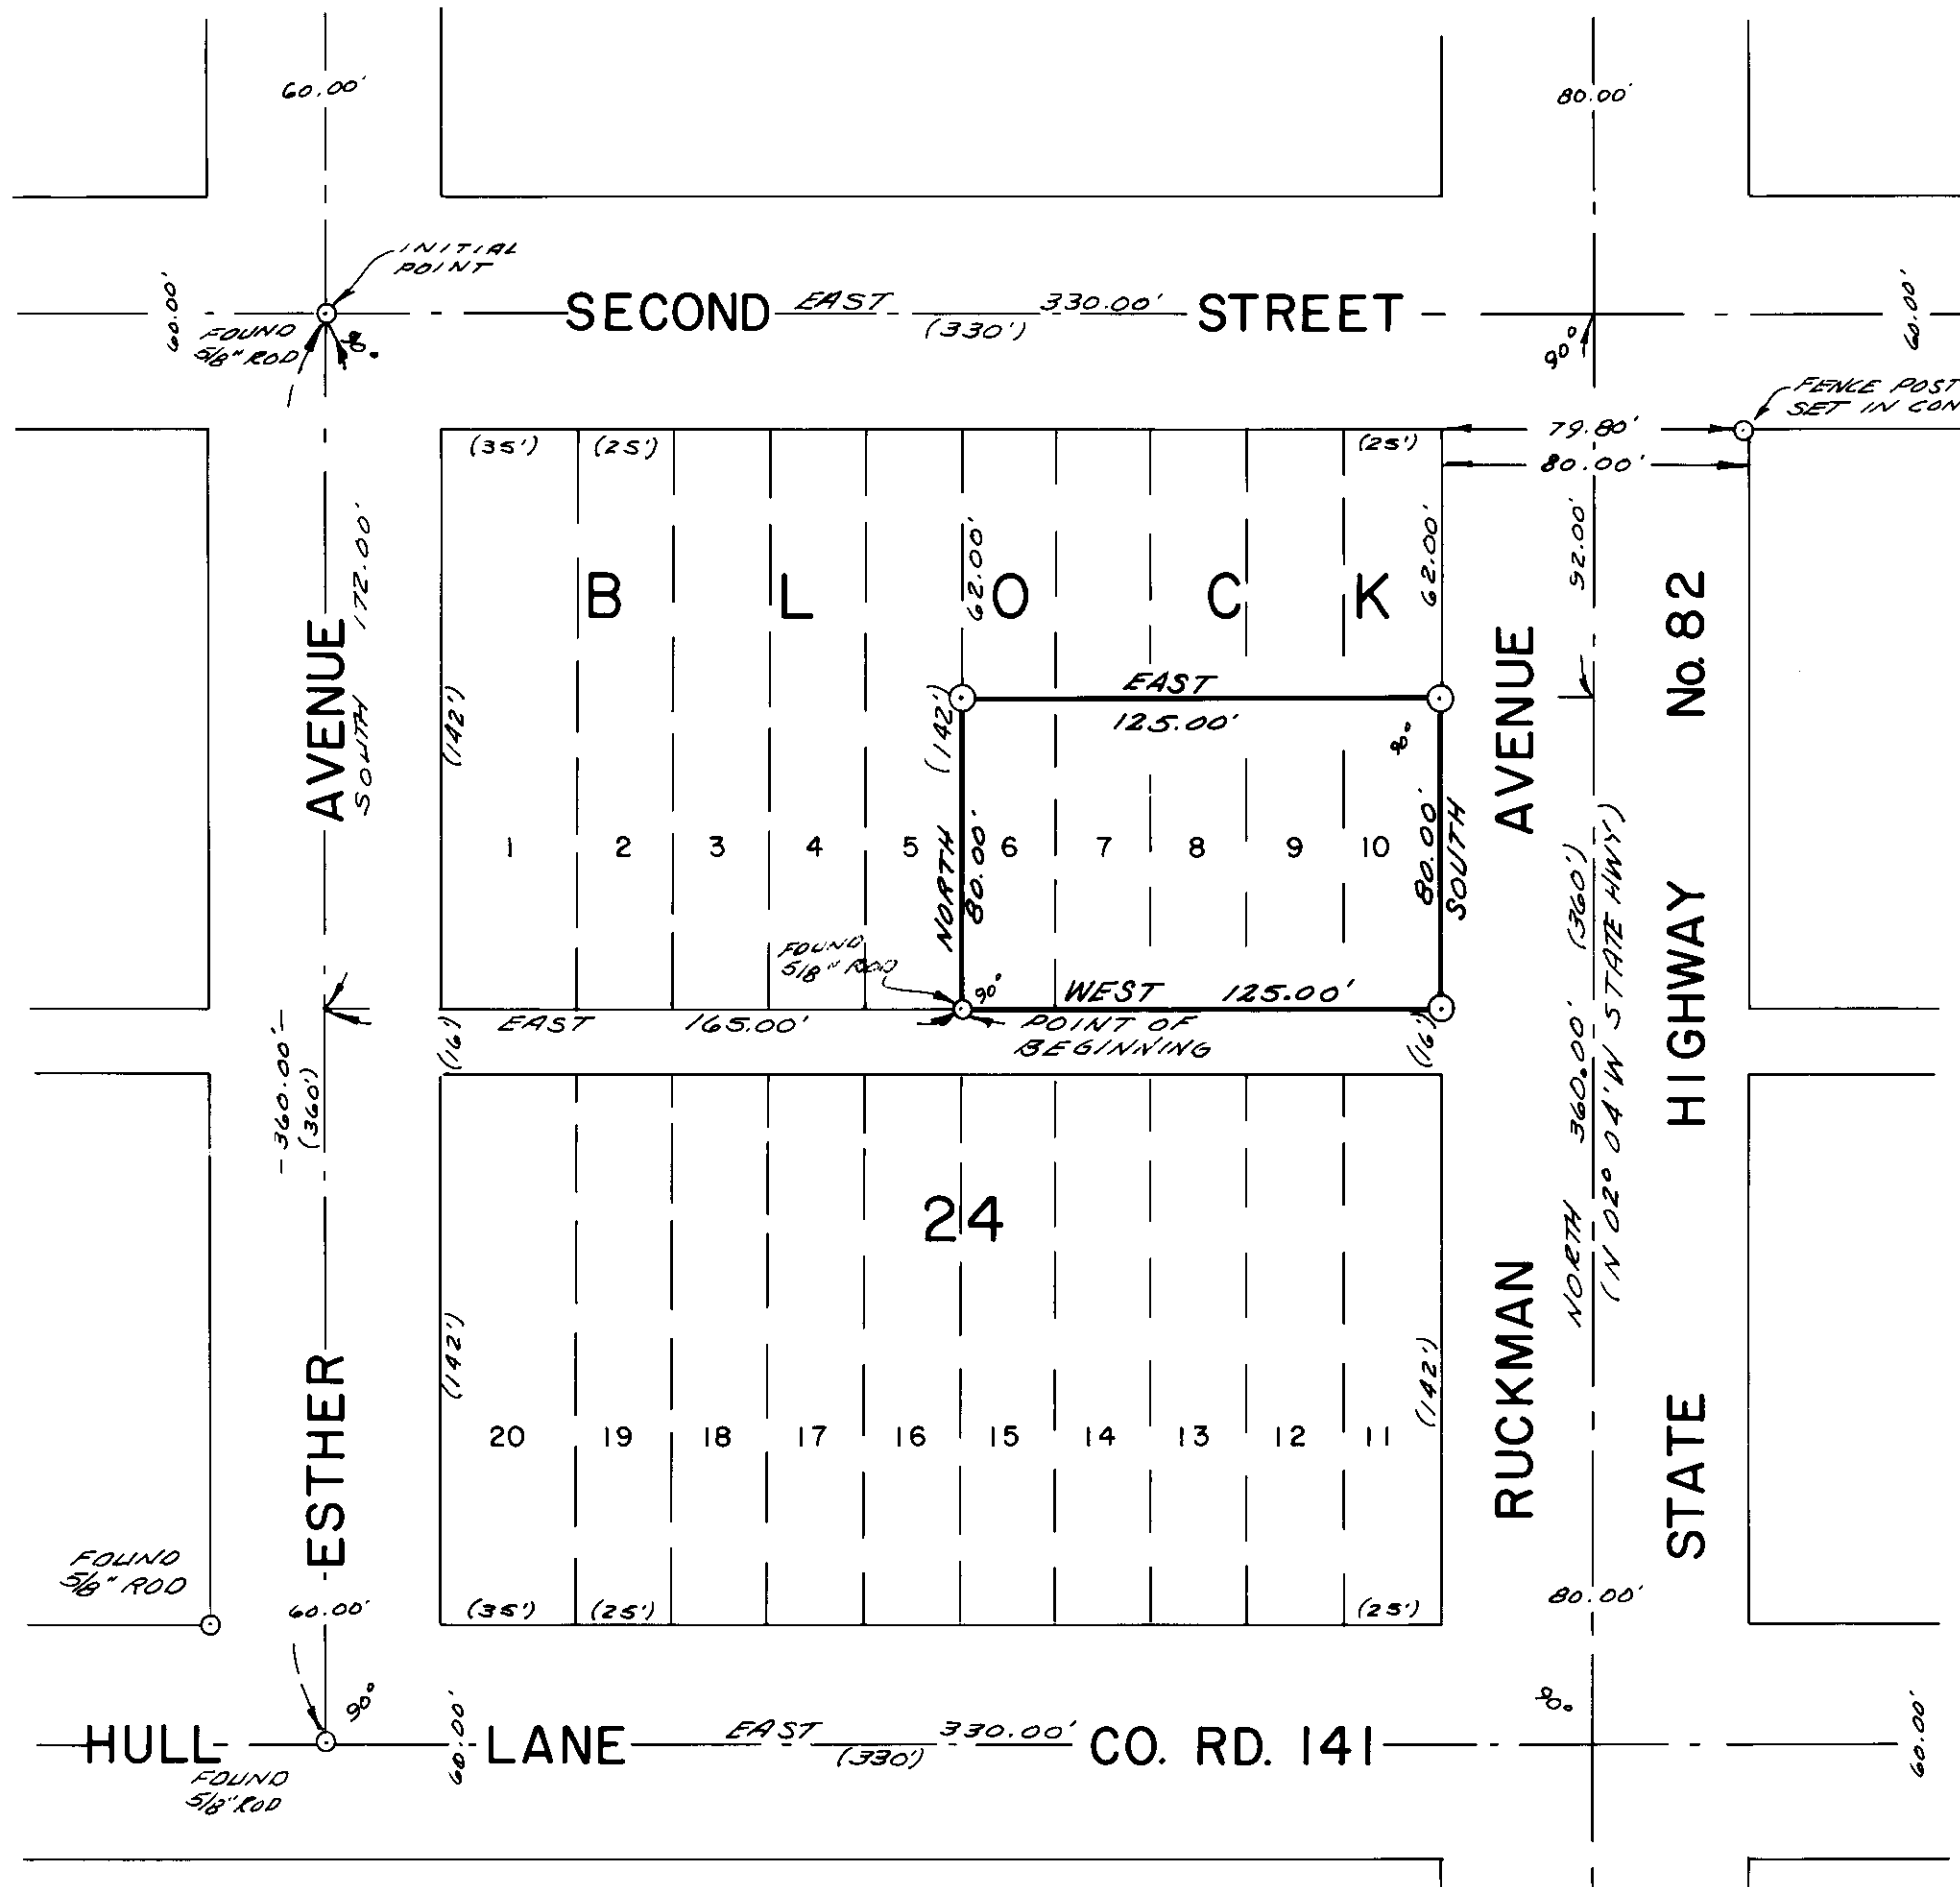

LEGEND

Found monuments as indicated.
Set 5/8" X 30" steel rods.
Center lines of streets.
Data of record.

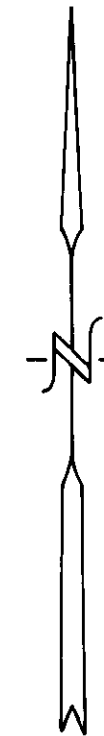

BASIS OF BEARINGS
BASED ON CEN. LI. OF
ESTHER AVE. BEING
SOUTH.

Jamie D. Voelz

SURVEYED BY VOELZ LAND SURVEYING, INC.	
SURVEYED FOR IMBLER RURAL FIRE DISTRICT	
DATE SEPT 30 1976	SCALE 1" = 50'

63 76