


**BASIS OF BEARING**  
SURVEY NO. 56-73

- LEGEND**
- LOT LINE
  - ⊙ FOUND MONUMENT OF RECORD
  - ( ) RECORD DATA
  - SET 5/8" x 30" STEEL PIN WITH CAP MARKED A.P.A.
  - SET 1/2" x 24" STEEL PIN WITH CAP MARKED A.P.A.
  - ③ LOT NUMBERS

**PROPERTY SURVEY**  
LOCATED IN LOT 5 & THE SOUTH 8 RODS OF LOT 6 OF MIDDLETOWN SUBDIVISION.

**REFERENCE MATERIAL**  
RECORD SURVEY NO. 56-73

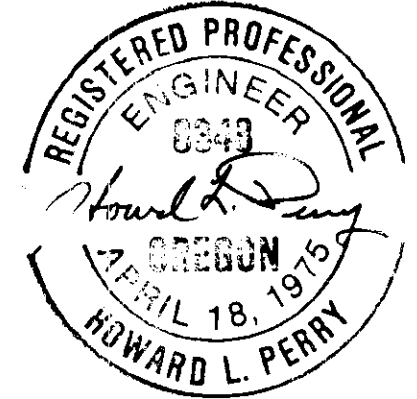

REVISION DATED 7/7/77

PROPERTY SURVEY LOCATED IN THE W 1/2 OF THE SW 1/4 OF THE SE 1/4, SEC. 33, T.2S., R.38 E., W.M.

SCALE	1" = 50'	SHEET NO.
DATE	APR. 1977	
FOR: LYNN ASLA		
ENGINEERING - SURVEYING - PLANNING - DESIGN LA GRANDE & ENTERPRISE OREGON		