

FOUND LEAD PLUG &  
BRASS SCREW

FOUND NAIL & LEAD  
PLUGS ON CURBS

THIRD ST  
N 00° 22' 40" E  
369.85 (370.00)



**BASIS OF BEARING**

FORWARD BEARING AS PUBLISHED BY U.S.C. & G.S.  
FROM Δ COLLEGE TO Δ VALLEY


**LEGEND**

- ▲ UNRECORDED MONUMENT
- SET 5/8" RE-BAR WITH PLASTIC CAP MARKED B. G. A. SURVEY MARKER
- CUT CROSS IN DRIVEWAY CURBING
- FOUND MONUMENT OF RECORD
- ( ) RECORD DISTANCE

SET CONCRETE NAIL  
(ALSO FOUND CONC. NAIL  
.13 SOUTH & .03 WEST  
OF MY NAIL.)

N 89° 41' 00" W  
369.93 (370.00)

MAIN ST

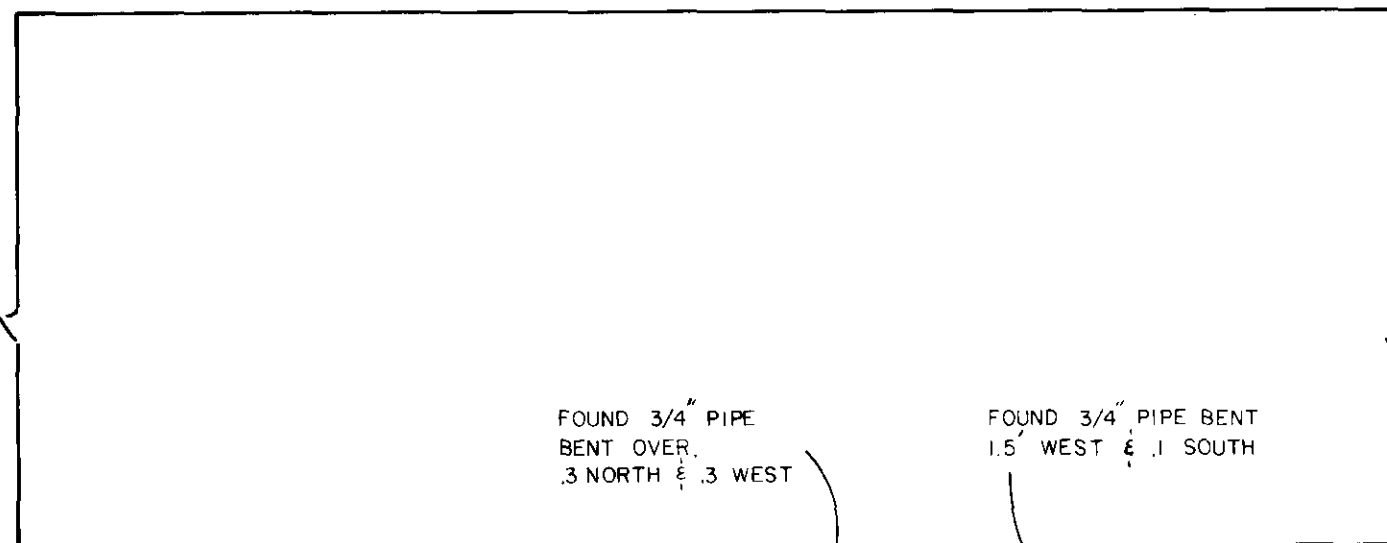

N 00° 22' 46" E

71.00

65.96

N 89° 40' 02" W  
134.93

N 89° 40' 03" W  
134.93

FOUND 3/4" PIPE  
.05 WEST & .10 SOUTH  
OF TRUE POSITION

71.00

CROSS IN CURB

N 00° 22' 35" E

65.95

FOURTH ST

369.75 (370.00)  
N 00° 22' 35" E

WASHINGTON ST

369.86 (370.00)  
N 89° 39' 47" W

SET CONCRETE NAIL

SET CONCRETE NAIL

FOUND METAL BOX  
WITH LEAD CROSS  
HUB TACK IN LEAD PLUG

FOUND METAL BOX WITH  
NAIL IN CONCRETE

**REFERENCE MATERIAL**

UNRECORDED MAP OF SURVEY BY DAVID SLAGHT  
SURVEY 30-74  
SURVEY 14-76  
1922 MONUMENTATION MAP OF LA GRANDE  
REMONUMENTATION MAP OF LA GRANDE

REGISTERED  
PROFESSIONAL  
LAND SURVEYOR

*Gregory T. Blackman*

OREGON  
JULY 13, 1973  
GREGORY T. BLACKMAN  
991

**BAGETT, GRIFFITH & ASSOCIATES**

La Grande, Oregon

Map of Survey

THE N. 21 FT. OF LOT 3 AND  
THE S. 50 FT. OF LOT 4 BLK. 1  
GRANDY'S ADDITION TO  
LA GRANDE  
UNION COUNTY, OREGON

SURVEYED FOR	QUINCY FONG	
SURVEYED BY	G.T.B.	5 / 77
Scale: 1" = 40'	Drawn by: G.T.B.	5 / 77

28-77