


13 18
T4S, R40EWM
24 19

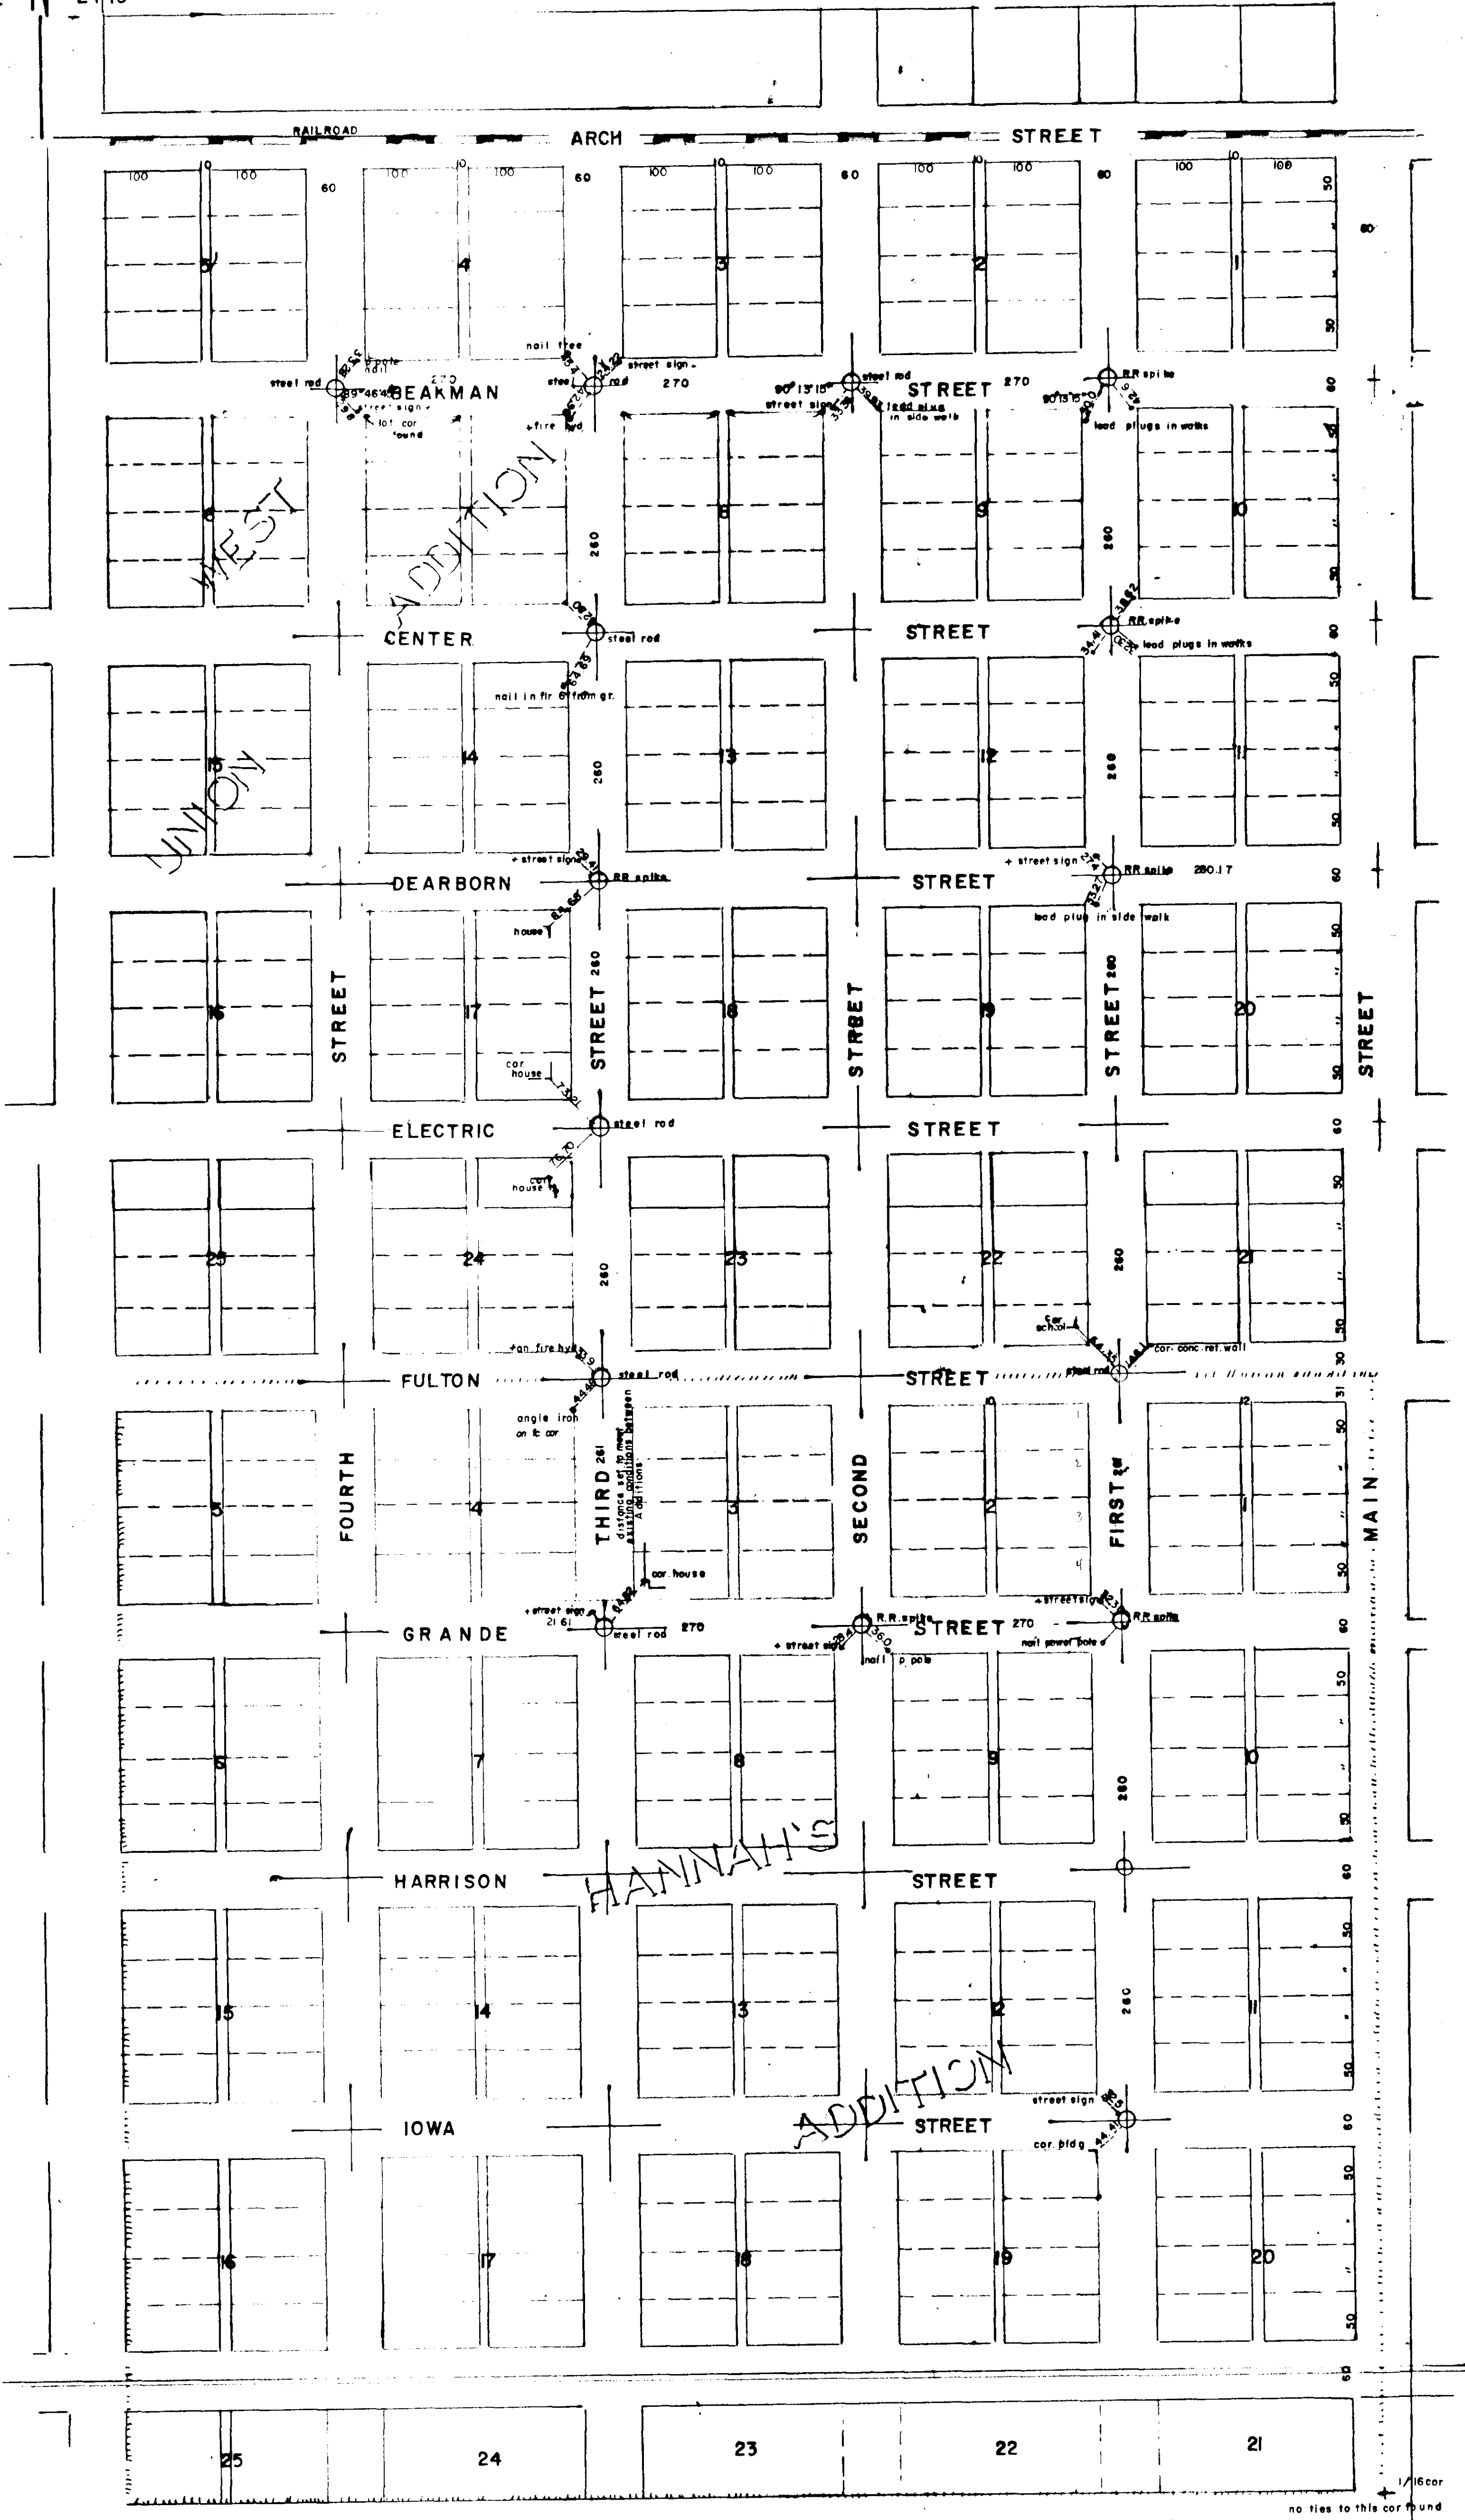

MONUMENTATION OF INTERSECTIONS
UNION, OREGON
Date-June, 1971 Scale 1" = 100'

REGISTERED
OREGON
LAND SURVEYOR
James G. Voelz
MAY 4, 1958
JAMES G. VOELZ
331

23-77

23-77